


PLAT OF SURVEY
(SEE SHEET 2 FOR DESCRIPTIONS OF LAND)

SHEET 1 OF 2 SHEETS.

TOMBEAU ROAD

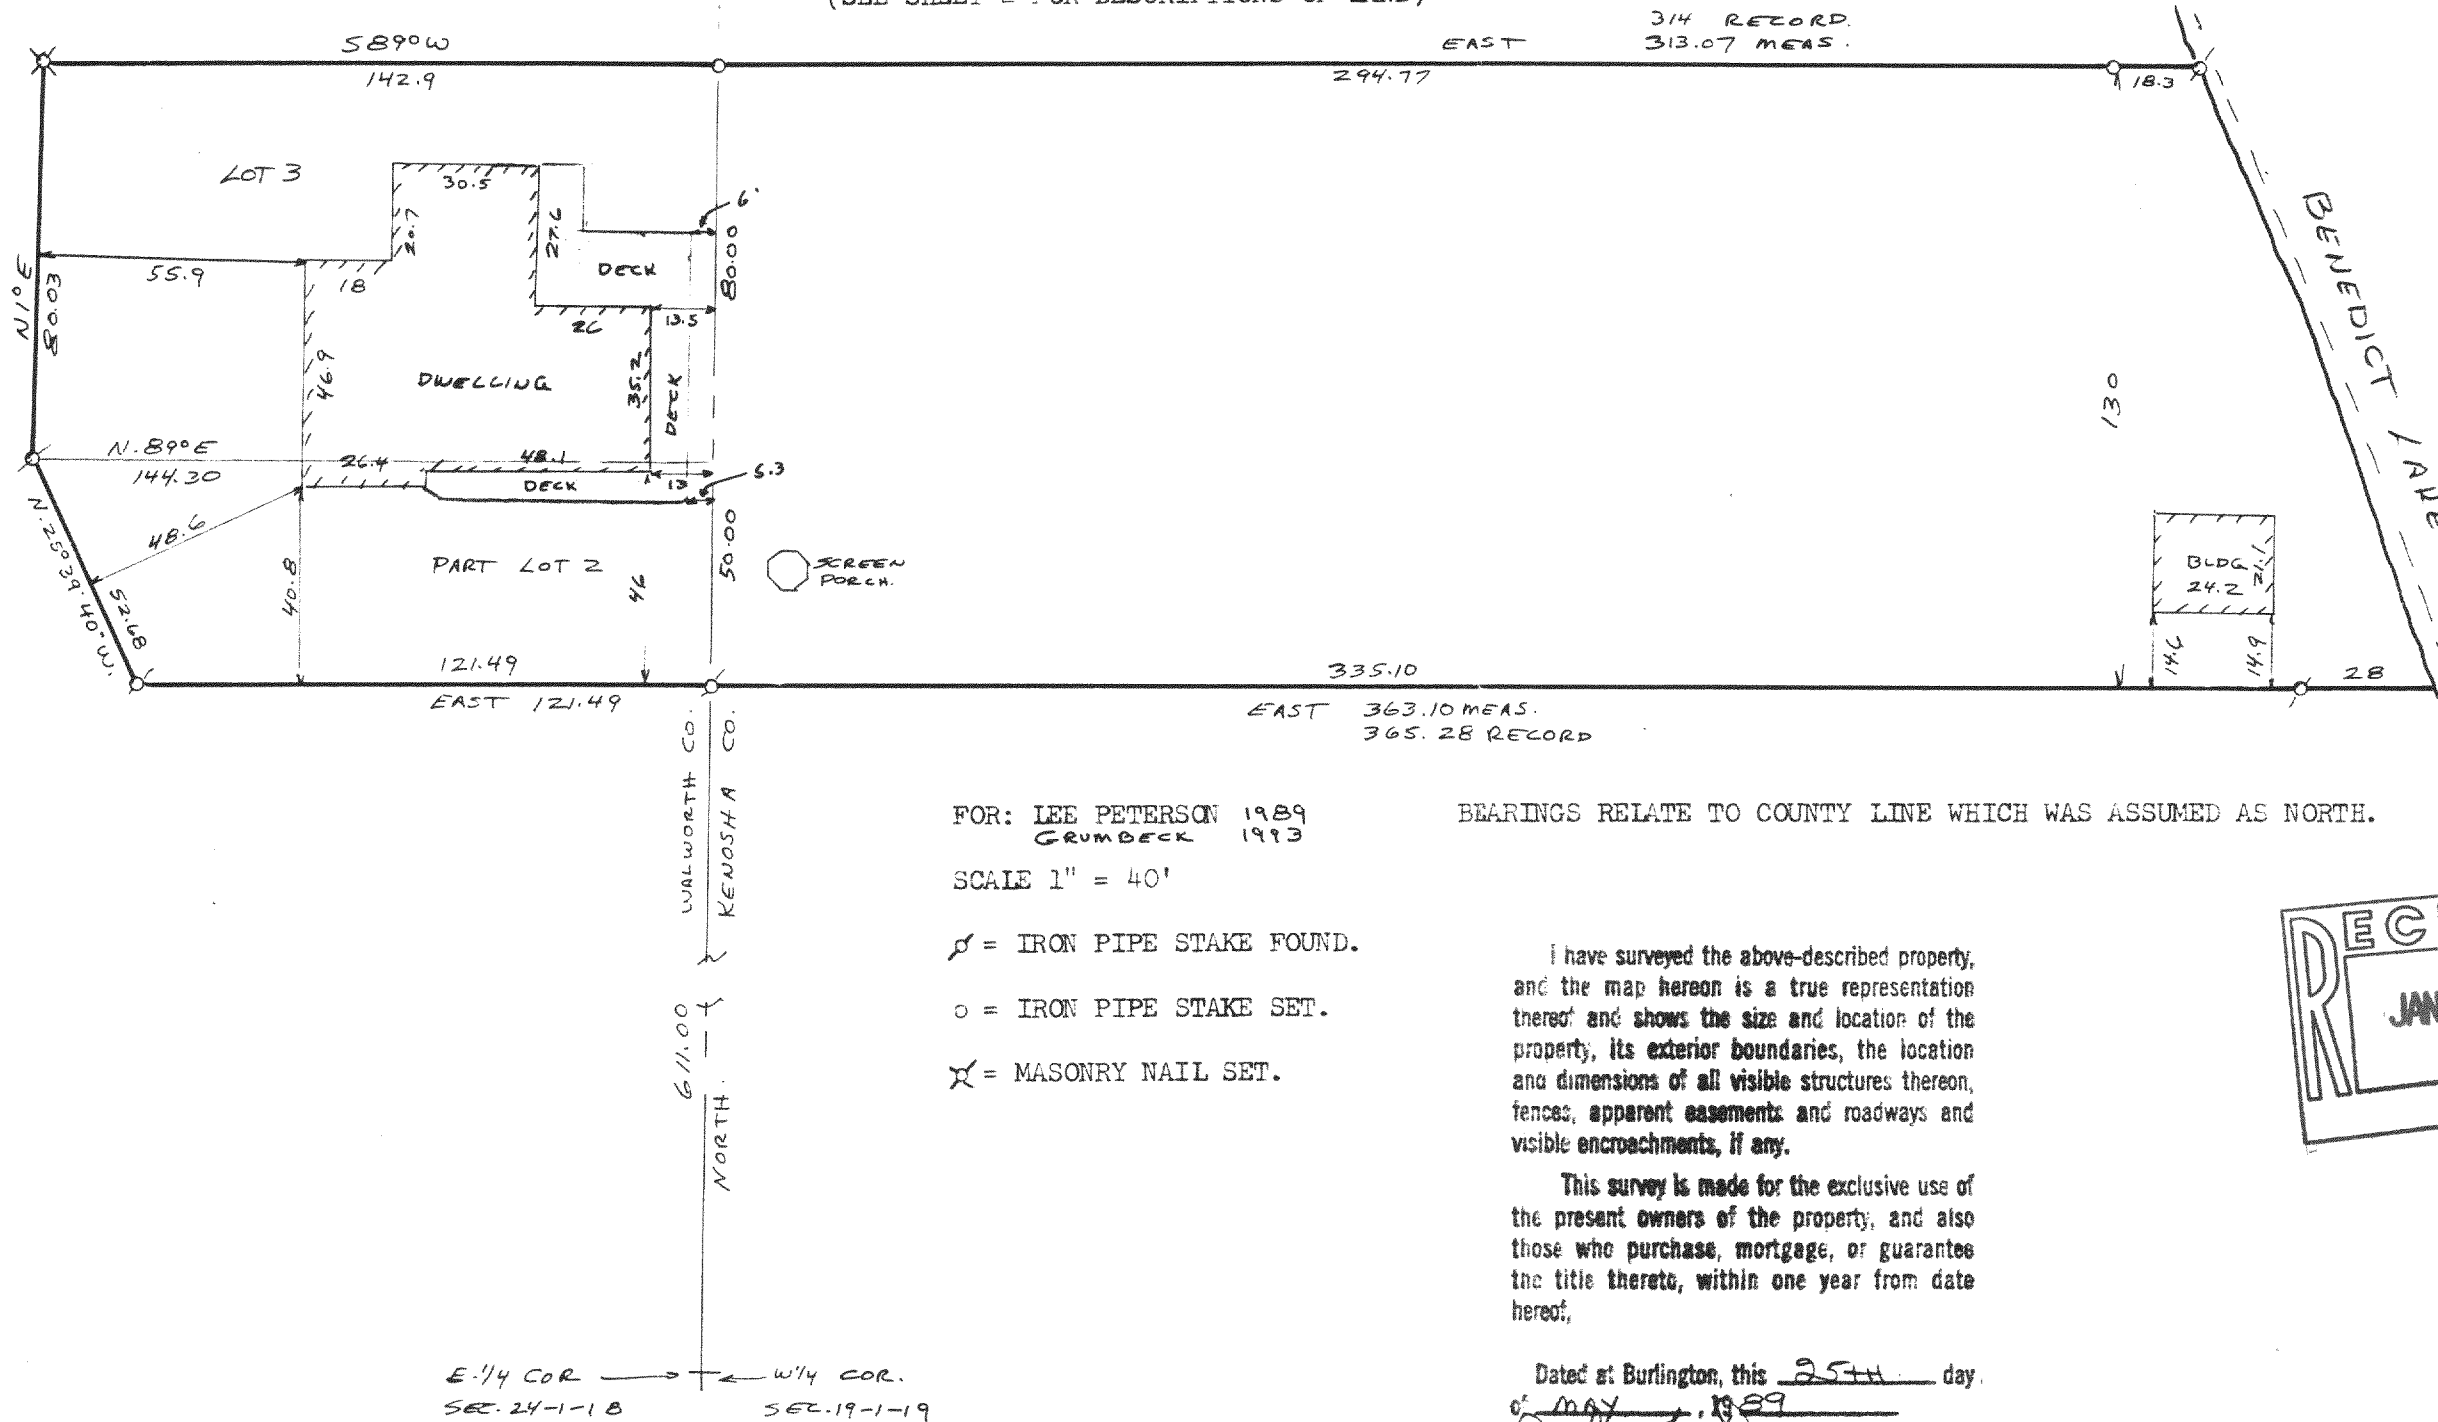

FOR: LEE PETERSON 1989
GRUMBECK 1993

BEARINGS RELATE TO COUNTY LINE WHICH WAS ASSUMED AS NORTH.

SCALE 1" = 40'

⊕ = IRON PIPE STAKE FOUND.


○ = IRON PIPE STAKE SET.

⊗ = MASONRY NAIL SET.

I have surveyed the above-described property, and the map hereon is a true representation thereof and shows the size and location of the property, its exterior boundaries, the location and dimensions of all visible structures thereon, fences, apparent easements and roadways and visible encroachments, if any.

This survey is made for the exclusive use of the present owners of the property, and also those who purchase, mortgage, or guarantee the title thereto, within one year from date hereof.

Dated at Burlington, this 25th day of May, 1989
John F. Degen, Land Surveyor # 242
589 N. Pine St. Burlington, WI 53105
RE-SURVEYED 11-23-93

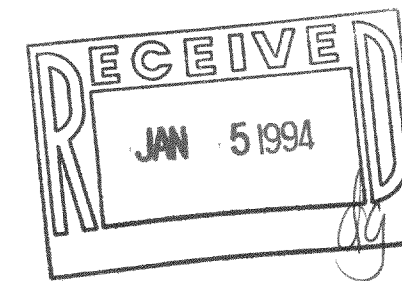

16-D-2 #2A

MNP-12D

118-1313