

PLAT OF SURVEY
OF


LOTS 9672 THRU 9680 IN BLOCK 212, OF SECTION 7 OF PELL LAKE SUBDIVISION,
LOCATED IN THE NORTHEAST 1/4 OF SECTION 21, T. 1 N., R. 18 E. OF
THE 4TH P.M., TOWNSHIP OF BLOOMFIELD, COUNTY OF WALWORTH,
STATE OF WISCONSIN.

FOR: KRUMPEN

SCALE 1" = 40'

o = IRON PIPE SET.

⌘ = IRON PIPE FOUND.

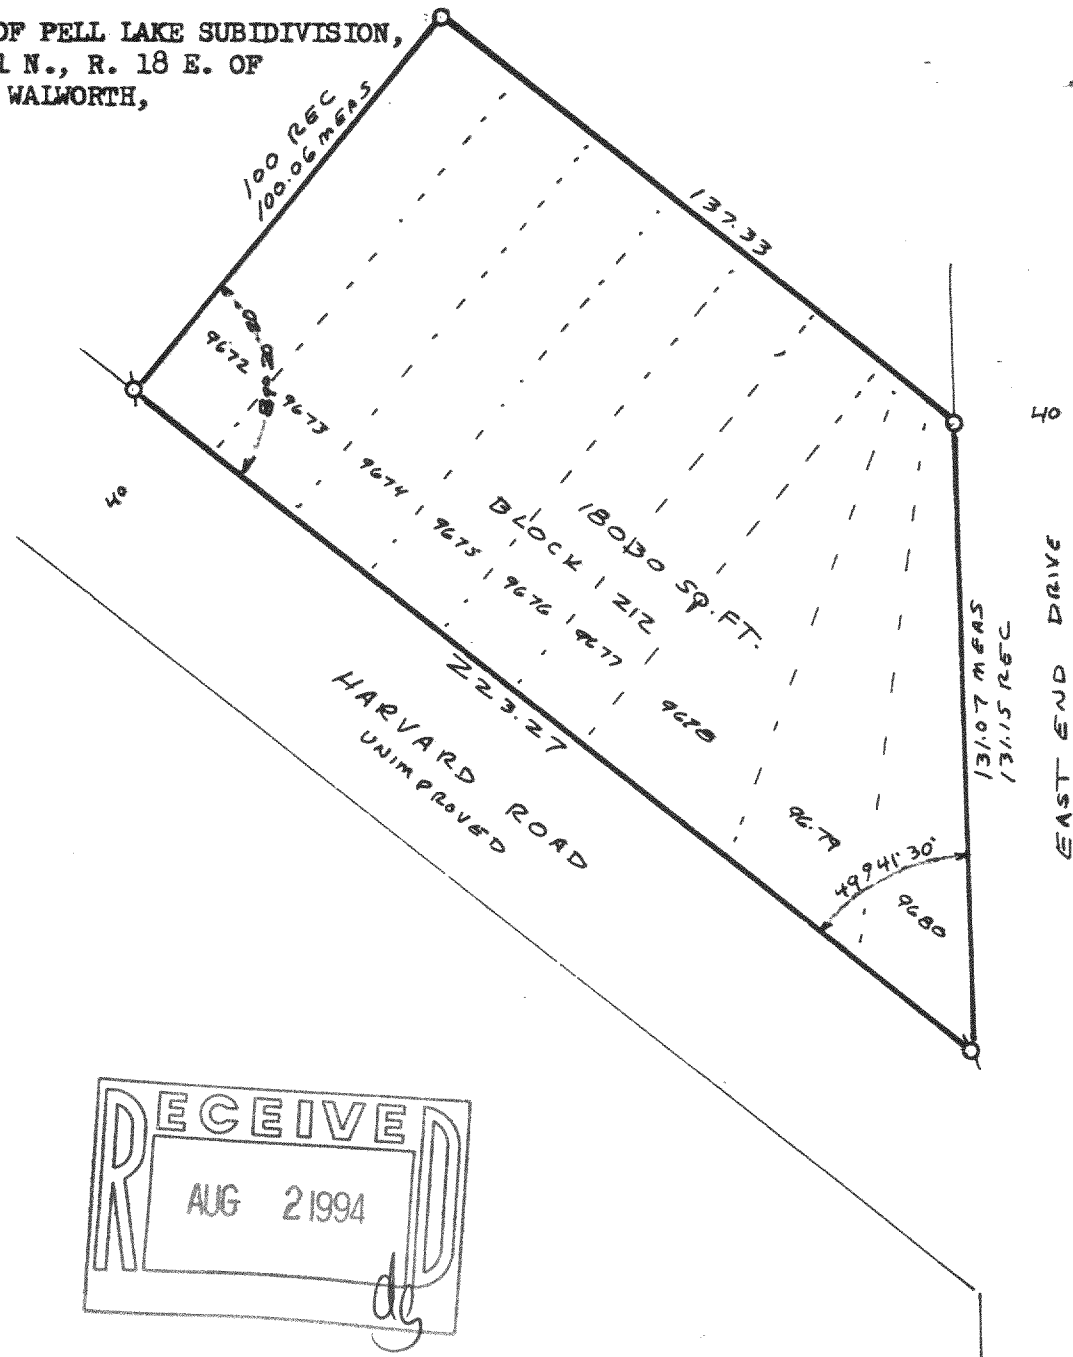


I have surveyed the above-described property,
and the map hereon is a true representation
thereof and shows the size and location of the
property, its exterior boundaries, the location
and dimensions of all visible structures thereon,
fences, apparent easements and roadways and
visible encroachments, if any.

This survey is made for the exclusive use of
the present owners of the property, and also
those who purchase, mortgage, or guarantee
the title thereto, within one year from date
hereof.

Dated at Burlington, this 1ST day
of JULY, 1994

John F. Degen

John F. Degen, Land Surveyor S 242
589 N. Pine St. Burlington, WI 53105

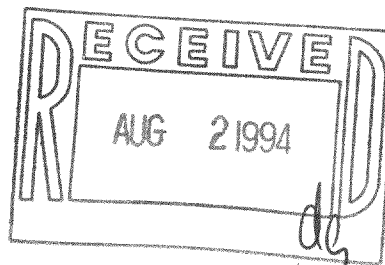

(N) 16-F-3 #30

MPL-1961

MPL-1962

118-1355