

PLAT OF SURVEY
OF

LOTS 4644 THROUGH 4653 IN BLOCK 90 OF SECTION 3 OF PELL LAKE, A SUBDIVISION LOCATED IN THE SOUTHEAST 1/4 OF SECTION 15, T. 1 N., R. 18 E. OF THE 4TH P.M., TOWNSHIP OF BLOOMFIELD, COUNTY OF WALWORTH, STATE OF WISCONSIN.

FOR: BURMAT

SCALE 1" = 30'

⊂ = IRON PIPE FOUND

⌵ = IRON ROD FOUND.

⊂ = IRON PIPE SET.

---X---X--- DENOTES FENCE



===== DENOTES BUILDING WALL

I have surveyed the above-described property, and the map hereon is a true representation thereof and shows the size and location of the property, its exterior boundaries, the location and dimensions of all visible structures thereon, fences, apparent easements and roadways and visible encroachments, if any.

This survey is made for the exclusive use of the present owners of the property, and also those who purchase, mortgage, or guarantee the title thereto, within one year from date hereof.

Dated at Burlington, this 31ST. day, of AUGUST, 1994

John F. Degen
John F. Degen, Land Surveyor S242
589 N. Pine St. Burlington, WI 53105

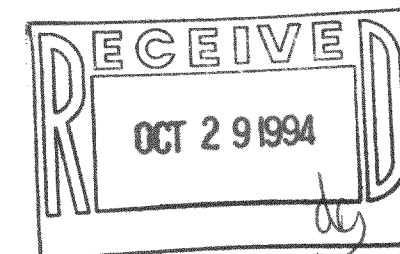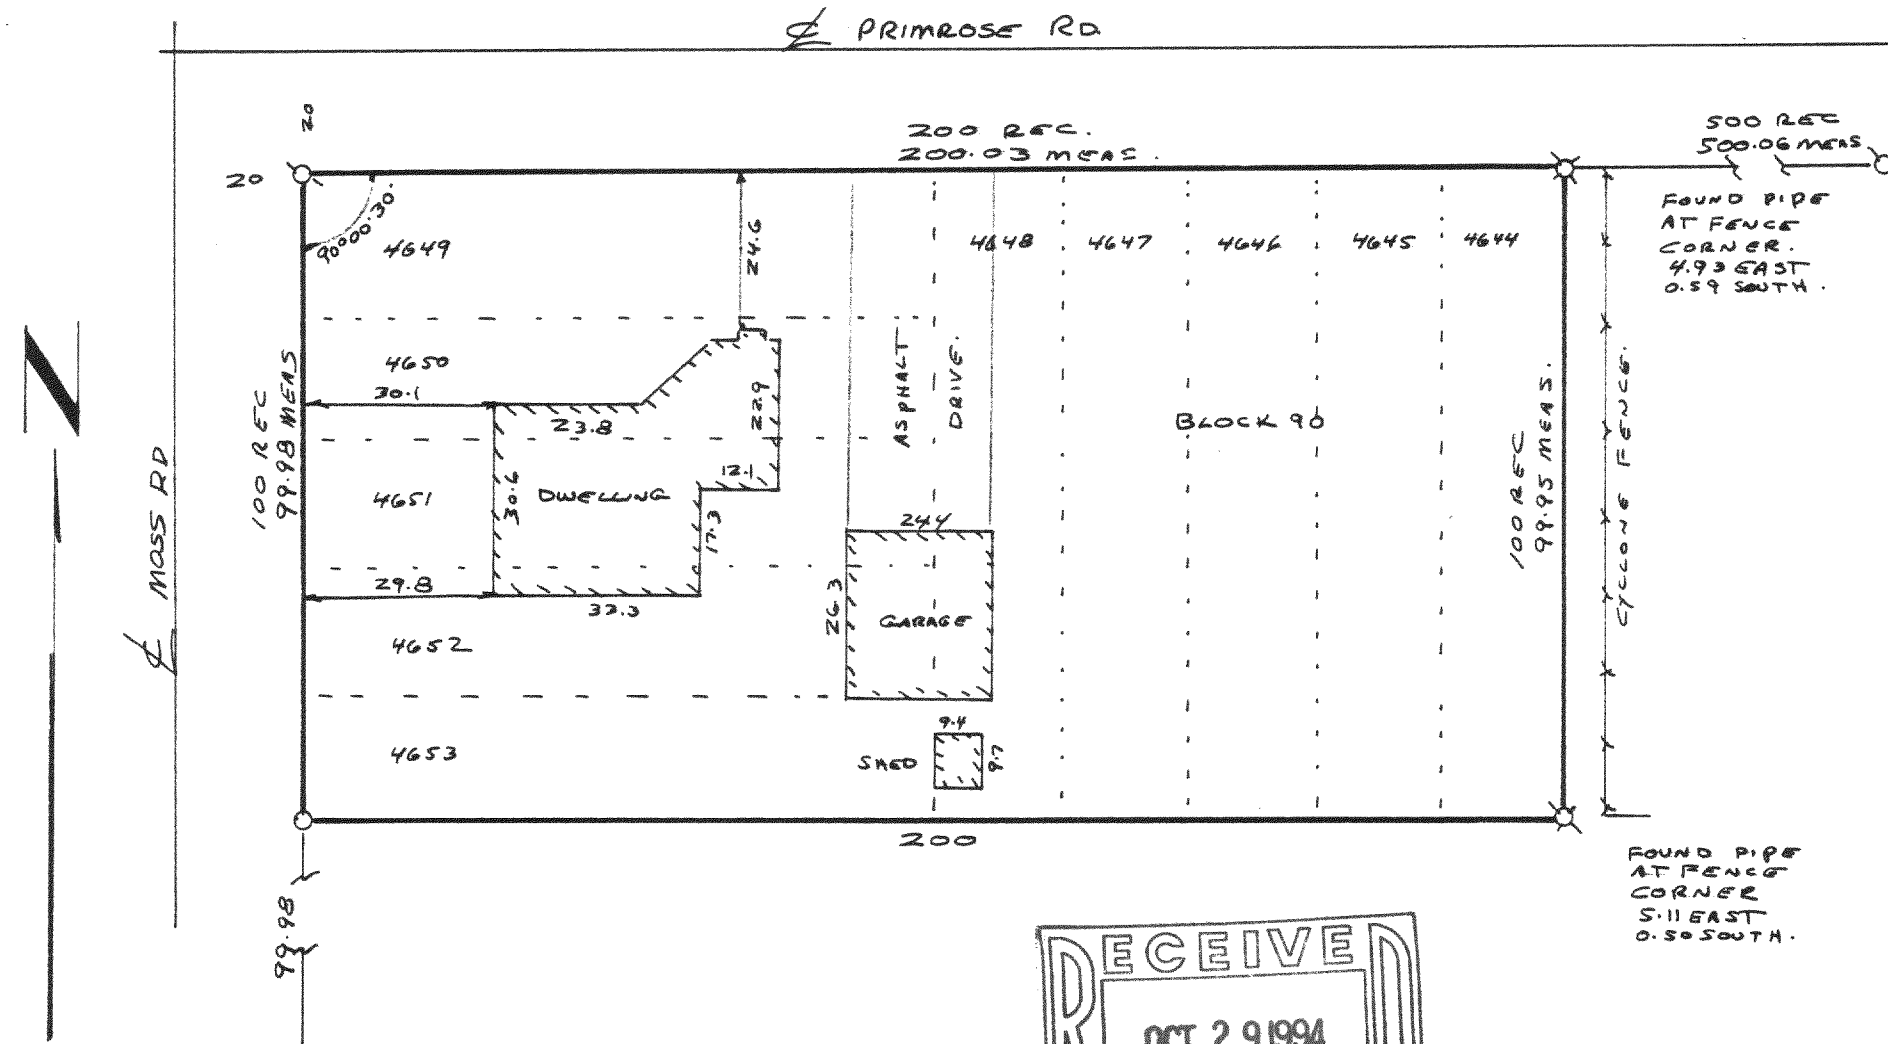

MPL-991
MPL-992

118-1362

19-C-2 #41