


KOLB LAND CONSULTING, INC.
LAND SURVEYING • SUBDIVIDING • LAND PLANNING



929 WILLIAMS STREET LAKE GENEVA, WISCONSIN 53147 414-248-3697

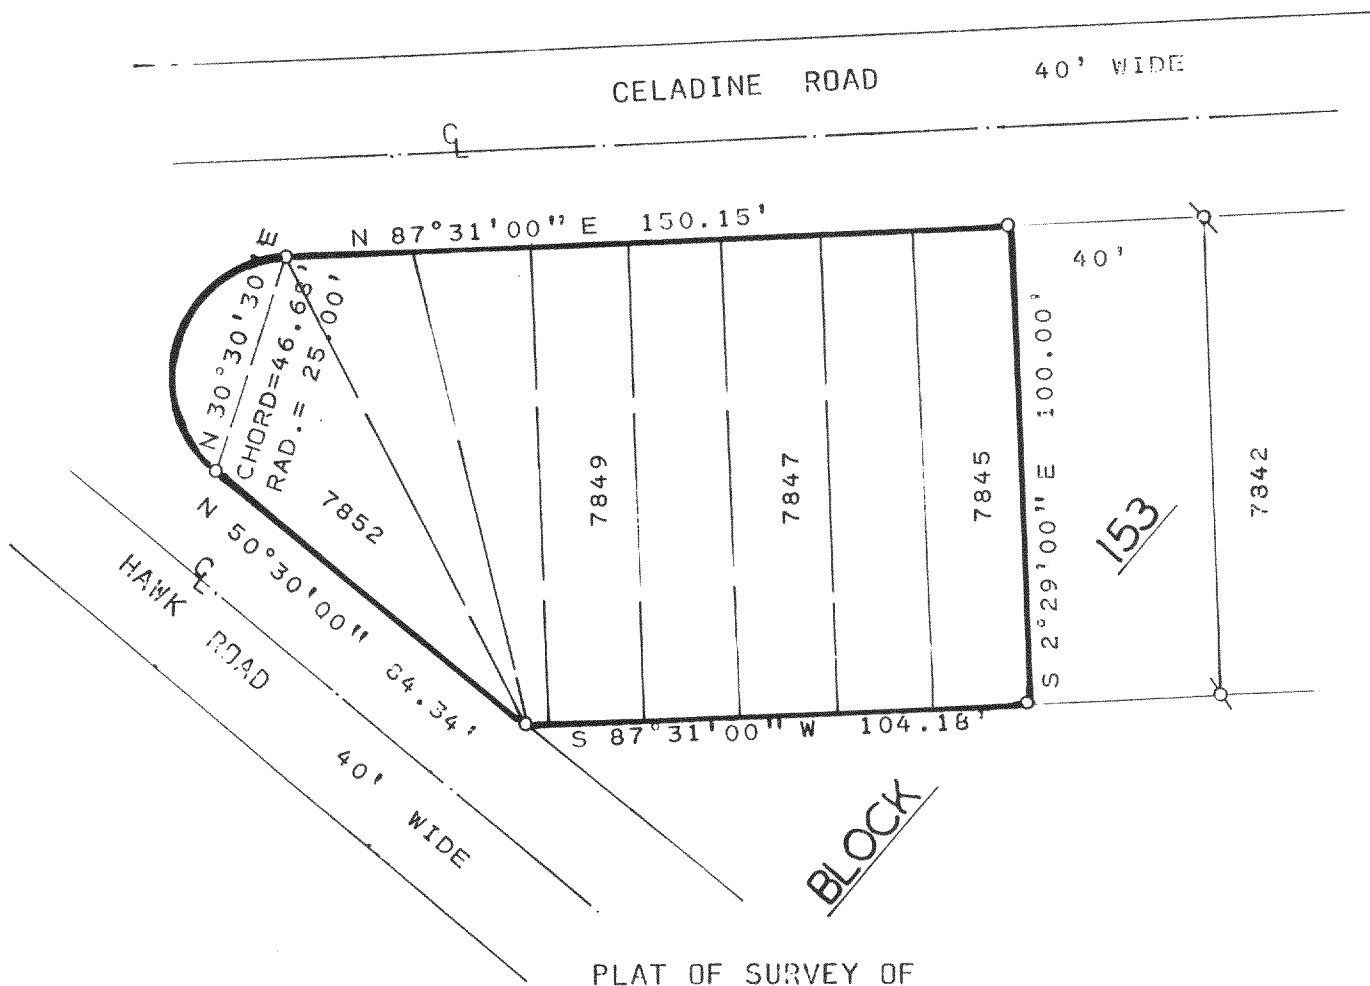

LOTS 7845-7852, BLOCK 153, PELL LAKE SUBDIVISION
LOCATED IN SECTION 5, T1N, R18E, TOWN OF BLOOM-
FIELD WALWORTH COUNTY, WISCONSIN.

ORDERED BY: JOHN ARNOW
35033 INDIAN TRAIL RD.
INGLESIDE IL. 60041

NOTE: BEARINGS ARE ASSUMED FROM
PREVIOUSLY RECORDED SUBDIVISION
PLAT.

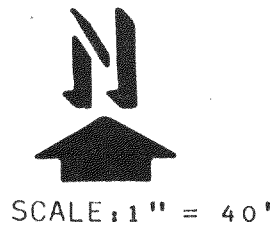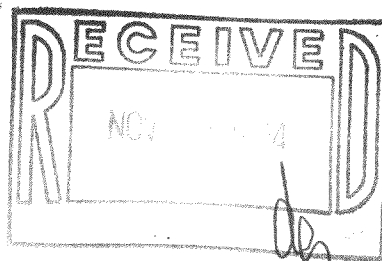

LEGEND

- ⊗ - IRON PIPE FOUND
○ - IRON PIPE SET

I HAROLD H. KOLB, DO HEREBY CERTIFY
THAT I HAVE SURVEYED THE PROPERTY
HEREON DESCRIBED ACCORDING TO THE
OFFICIAL RECORDS, AND THAT THE PLAT
HEREON IS A CORRECT REPRESENTATION
OF THE LOT LINES TO THE BEST OF MY
KNOWLEDGE AND BELIEF.
SURVEY NOT VALID UNLESS SURVEYOR'S
SIGNATURE IS IN RED.

HAROLD H. KOLB

WISCONSIN REGISTERED LAND SURVEYOR, S-
DATE FEBRUARY 8, 1994


REVISED

REVISED

1-18-396A

KOLB LAND CONSULTING, INC.
LAND SURVEYING • SUBDIVIDING • LAND PLANNING



929 WILLIAMS STREET LAKE GENEVA, WISCONSIN 53147 414 248-3697

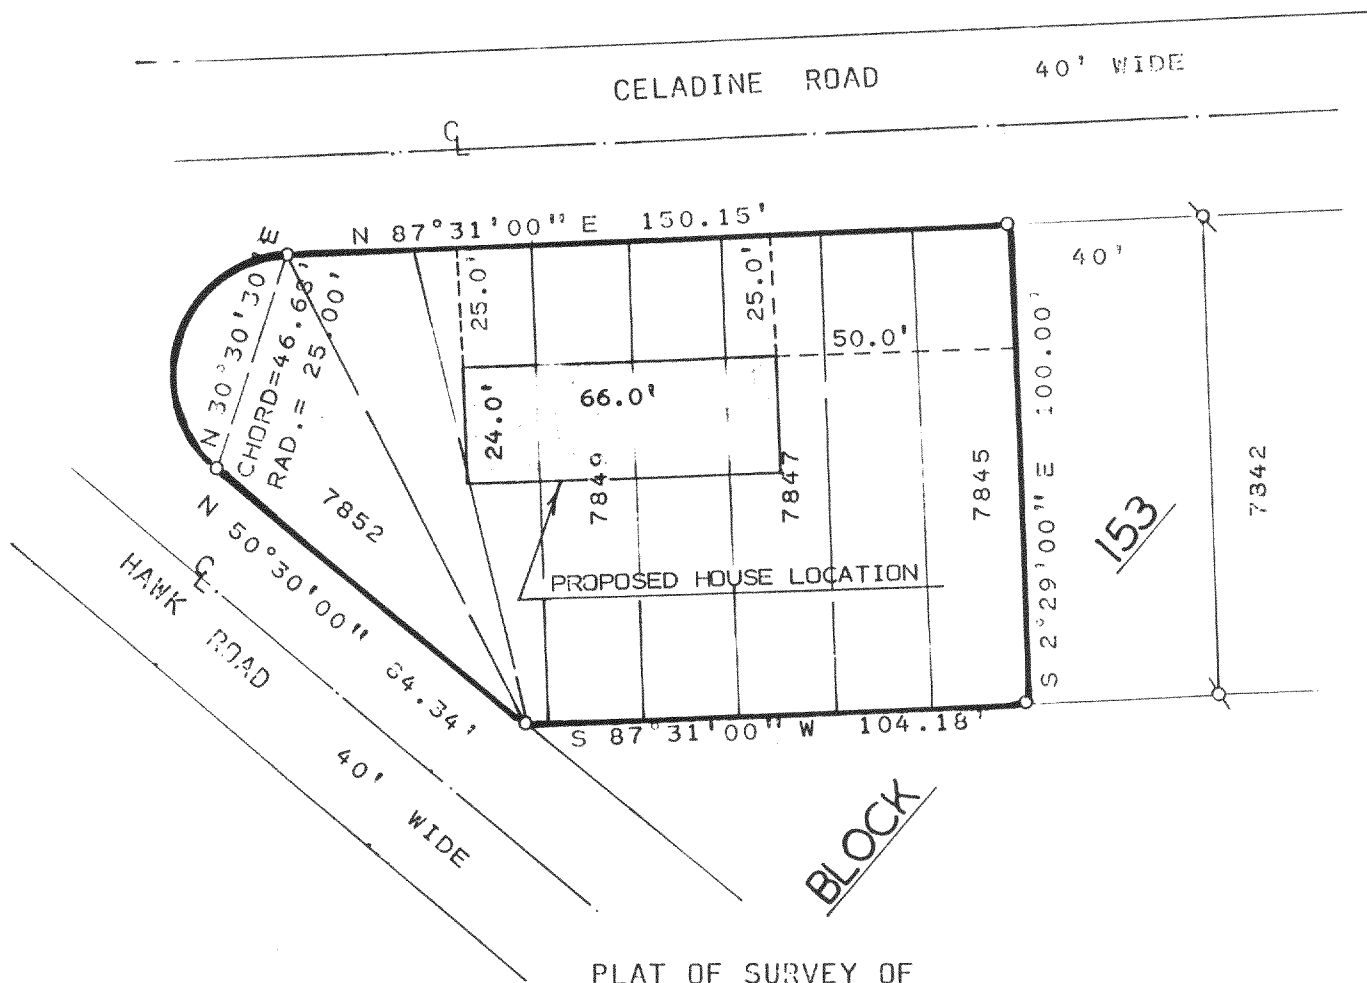

LOTS 7845-7852, BLOCK 153, PELL LAKE SUBDIVISION
LOCATED IN SECTION 5, T1N, R18E, TOWN OF BLOOM-
FIELD WALWORTH COUNTY, WISCONSIN.

ORDERED BY: JOHN ARNOW
35033 INDIAN TRAIL RD.
INGLESIDE IL. 60041

NOTE: BEARINGS ARE ASSUMED FROM
PREVIOUSLY RECORDED SUBDIVISION
PLAT.

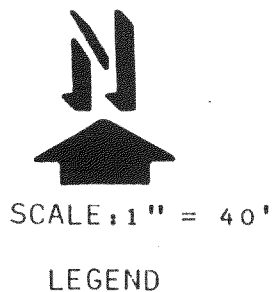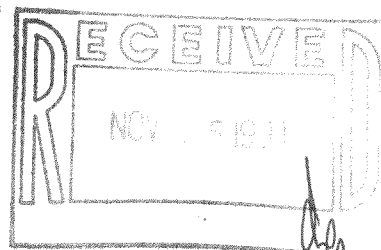

q - IRON PIPE FOUND
o - IRON PIPE SET

I HAROLD H. KOLB, DO HEREBY CERTIFY
THAT I HAVE SURVEYED THE PROPERTY
HEREON DESCRIBED ACCORDING TO THE
OFFICIAL RECORDS, AND THAT THE PLAT
HEREON IS A CORRECT REPRESENTATION
OF THE LOT LINES TO THE BEST OF MY
KNOWLEDGE AND BELIEF.
SURVEY NOT VALID UNLESS SURVEYOR'S
SIGNATURE IS IN RED.

HAROLD H. KOLB

WISCONSIN REGISTERED LAND SURVEYOR, S-
DATE FEBRUARY 8, 1994

REVISED FEBRUARY 17, 1994

REVISED

1-13-396A

MPL-1587
MPL-1588

118-1382