


KOLB LAND CONSULTING, INC.
LAND SURVEYING • SUBDIVIDING • LAND PLANNING

929 WILLIAMS STREET

LAKE GENEVA, WISCONSIN 53147


414-248-3697

EASTWOOD ROAD 40' WIDE

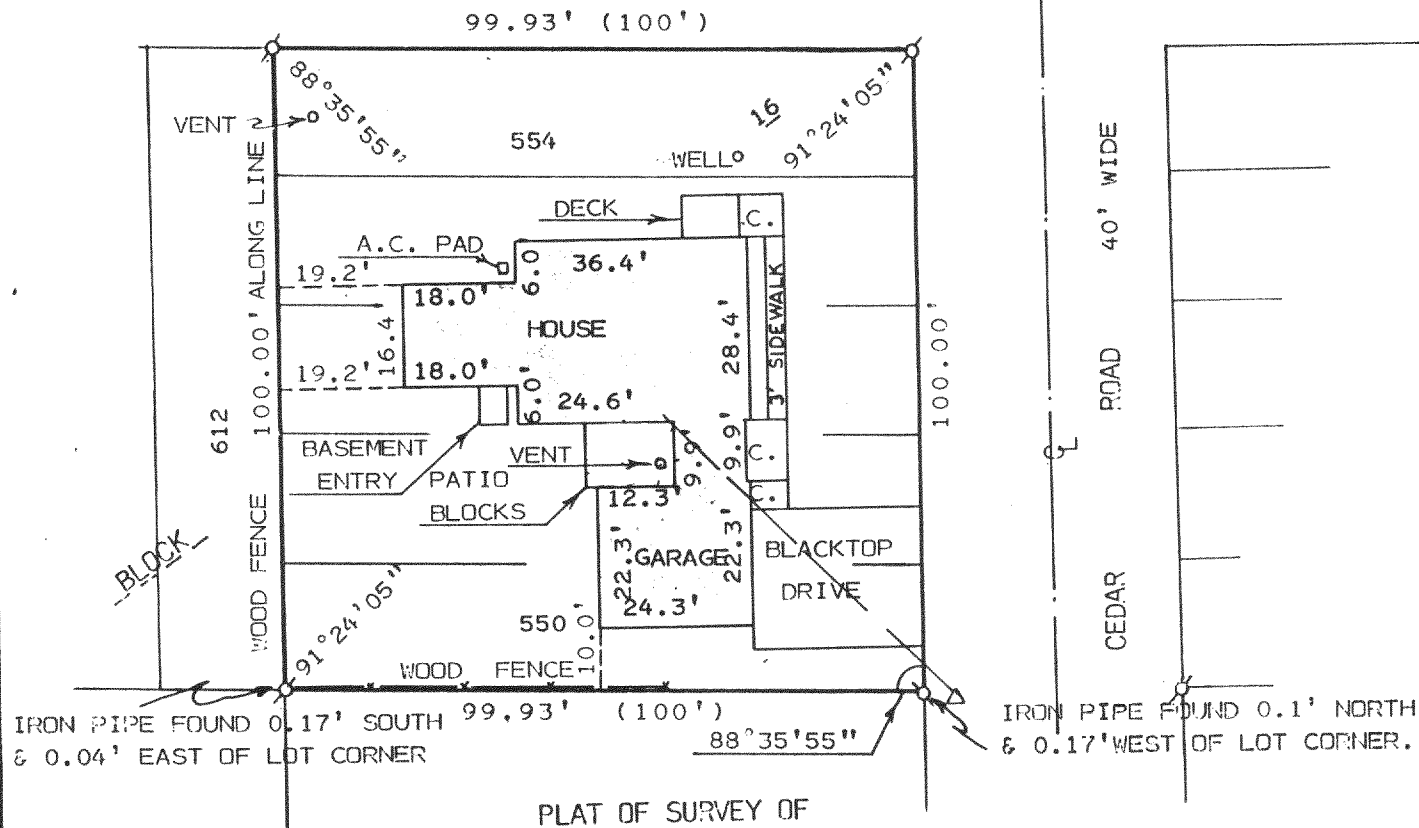


LOTS 550-554, BLOCK 16 OF PELL LAKE HIGHLANDS SUBDIVISION
LOCATED IN T1N, R18E, TOWN OF BLOOMFIELD, WALWORTH COUNTY,
WISCONSIN.

ORDERED BY: BOB & JEAN HOYOSS
% FIVE STAR HOMES
90 EAST GENEVA SQUARE
P.O. BOX 127 LAKE GENEVA
WISCONSIN. 53147

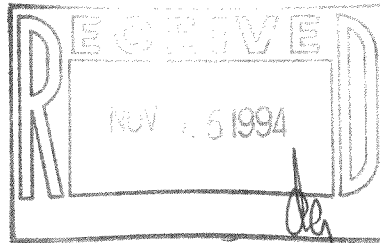

I HEREBY CERTIFY THAT I HAVE SURVEYED THE
ABOVE DESCRIBED PROPERTY AND THAT THE ABOVE
MAP IS A TRUE REPRESENTATION THEREOF AND
SHOWS THE SIZE AND LOCATION OF THE PROPERTY,
ITS EXTERIOR BOUNDARIES, THE LOCATION OF ALL
VISIBLE STRUCTURES AND DIMENSIONS OF ALL
PRINCIPAL BUILDINGS THEREON, BOUNDARY FENCES,
APPARENT EASEMENTS, ROADWAYS AND VISIBLE
ENCROACHMENTS, IF ANY, TO THE BEST OF MY
KNOWLEDGE AND BELIEF.
THIS SURVEY IS MADE FOR THE USE OF THE
PRESENT OWNERS OF THE PROPERTY, AND ALSO
THOSE WHO PURCHASE, MORTGAGE, OR GUARANTEE
THE TITLE THERETO WITHIN ONE (1) YEAR FROM
DATE HEREOF. THIS SURVEY IS NOT VALID UNLESS
THE SURVEYOR'S SIGNATURE IS IN RED.

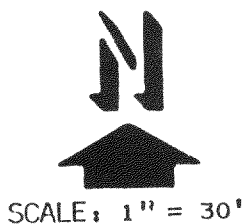

LEGEND

- △ - IRON PIPE FOUND
- - IRON PIPE SET
- Δ - UTILITY POLE
- - OVERHEAD UTILITY LINE
- (100') - AS RECORDED
- C. - CONCRETE

HAROLD H. KOLB

WISCONSIN REGISTERED LAND SURVEYOR, S-187

DATE JANUARY 14, 1994

REVISED

REVISED

MPLH-120

118-1385

1-18-433