
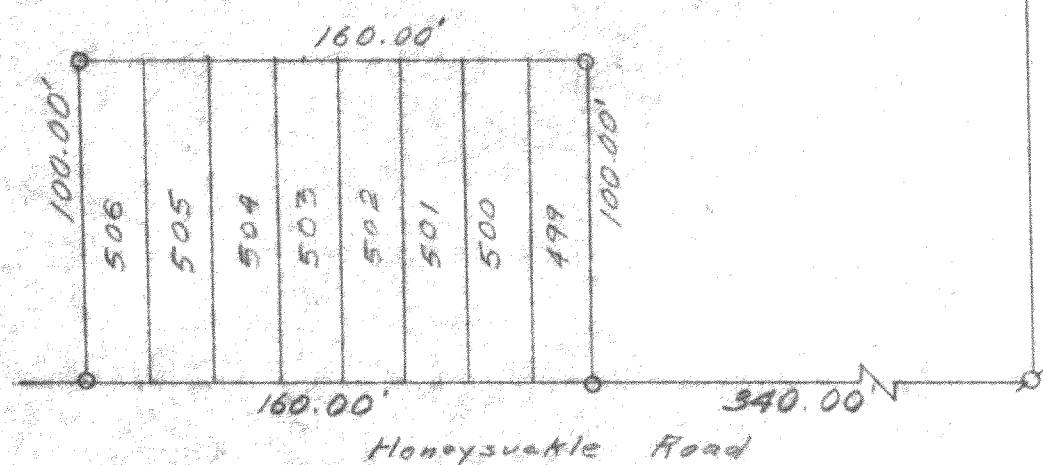


HAROLD H. KOLB
REGISTERED PROFESSIONAL LAND SURVEYOR
LAKE GENEVA, WISCONSIN

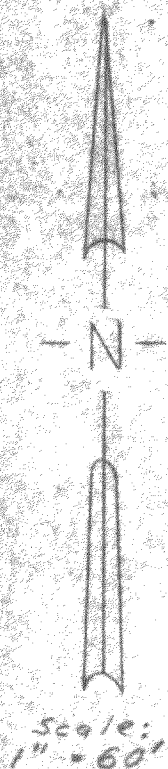

PLAT OF SURVEY OF

Lots 499-506, Block 17, Pell Lake Highlands, a
subdivision located in Walworth County, Wisconsin.

Harold H. Kolb

Harold H. Kolb, Wisconsin Surveyor, S-187
DATE: May 22, 1964.

⊗ Iron Pipe Found
○ Iron Pipe Set

118-139