



FOREST ROAD

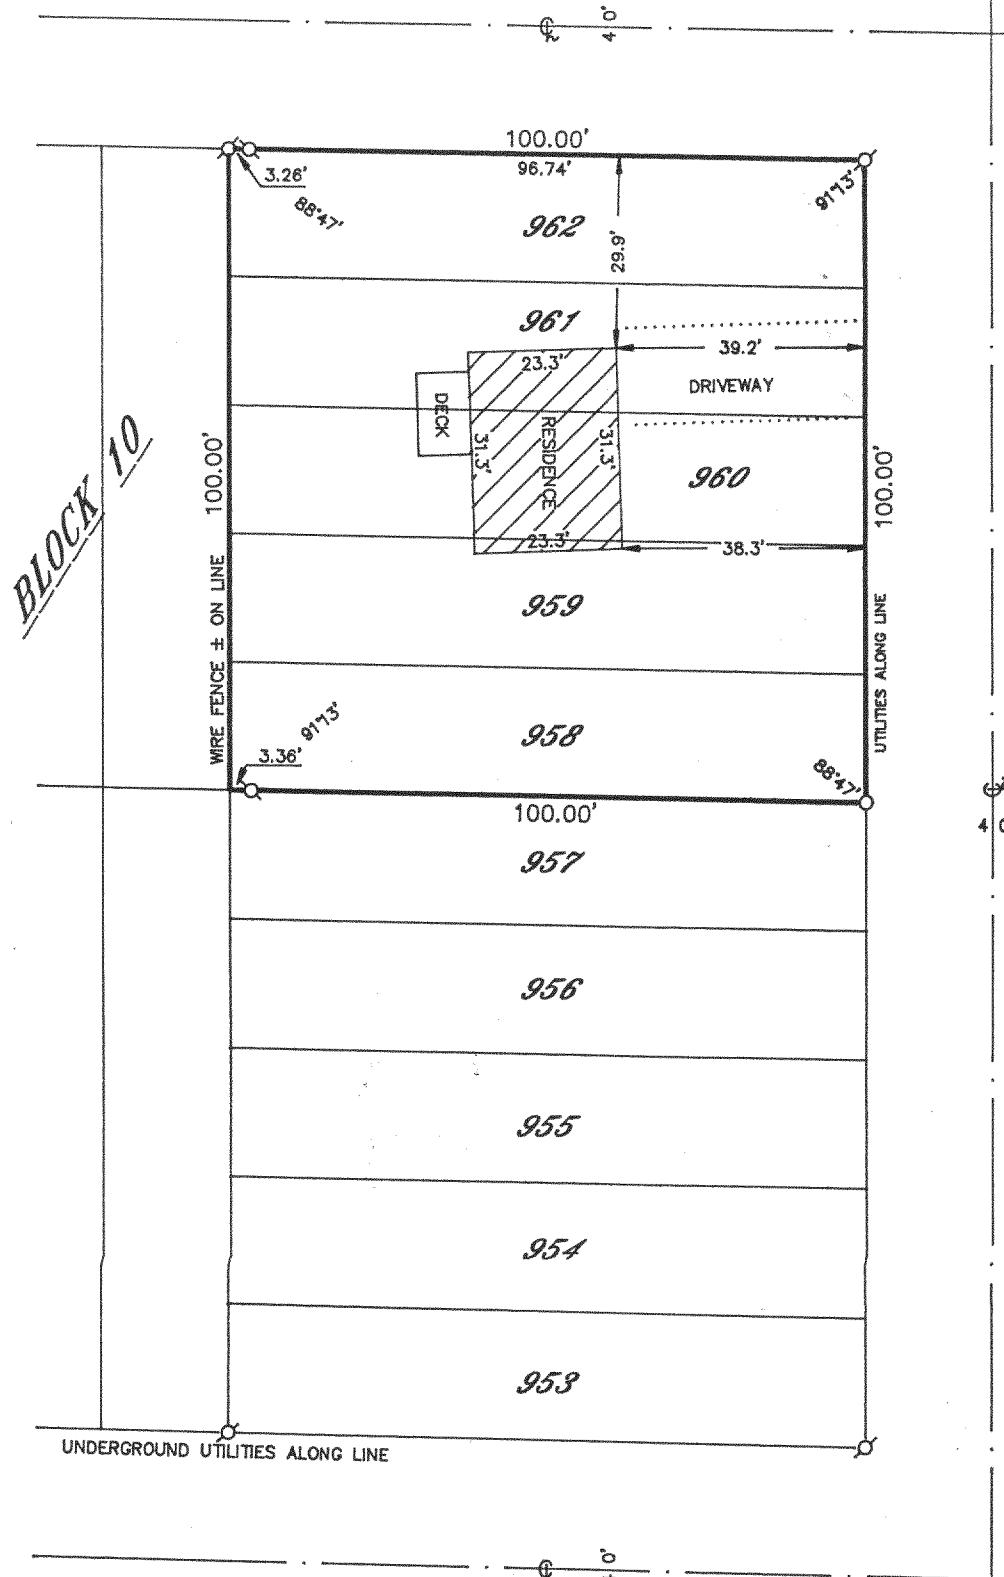

GLENWOOD ROAD

WALWORTH COUNTY
SURVEYING & MAPPING
727 HENRY STREET
LAKE GENEVA, WISCONSIN
414-248-0505

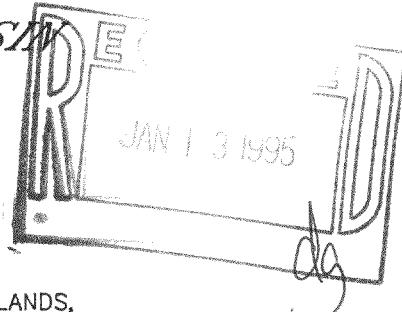

PLAT OF SURVEY OF

LOTS 958-962, BLOCK 10 OF PELL LAKE HIGHLANDS,
LOCATED IN SECTION 16, T 1 N, R 18 E, WALWORTH
COUNTY, WISCONSIN.

ORDERED BY: STACY WILKINSON
26545 FAIRFIELD ROAD
WAUCONDA, ILLINOIS
60084

GRAPHIC SCALE



(IN FEET)
1 inch = 30 ft.

○ - IRON PIPE FOUND
○ - IRON ROD FOUND
● - CONCRETE MONUMENT FOUND
○ - IRON PIPE PLACED
() - RECORDED AS

I HEREBY CERTIFY THAT I HAVE SURVEYED THE ABOVE DESCRIBED PROPERTY AND THAT THE ABOVE MAP IS A TRUE REPRESENTATION THEREOF AND SHOWS THE SIZE AND LOCATION OF THE PROPERTY, ITS EXTERIOR BOUNDARIES, THE LOCATION OF ALL VISIBLE STRUCTURES AND DIMENSIONS OF ALL PRINCIPAL BUILDINGS THEREON, BOUNDARY FENCES, APPARENT EASEMENTS, ROADWAYS AND VISIBLE ENCROACHMENTS, IF ANY, TO THE BEST OF MY KNOWLEDGE AND BELIEF.

THIS SURVEY IS MADE FOR THE USE OF THE PRESENT OWNERS OF THE PROPERTY AND ALSO THOSE WHO PURCHASE, MORTGAGE OR GUARANTEE THE TITLE THERETO WITHIN ONE (1) YEAR FROM DATE HEREOF.

Robert M. Baerenwald
ROBERT M. BAERENWALD
WISCONSIN REGISTERED LAND SURVEYOR, S-1508

DATE *JAN 13, 1994*
JOB NO. 3693

NOTE: THIS IS NOT A CERTIFIED COPY UNLESS SEALED.