


PLAT OF SURVEY
OF

LOT 8, BLOCK 6, ROSE NIPPERS INK GARDENS, A SUBDIVISION LOCATED IN THE SOUTHEAST 1/4 OF SECTION 24, T. 1 N., R. 18 E. OF THE 4TH P.M., TOWNSHIP OF BLOOMFIELD, COUNTY OF WALWORTH, STATE OF WISCONSIN.

FOR: STUMPF REALTY SCALE 1" = 40' σ = IRON PIPE FOUND.

• = CONCRETE MONUMENT FOUND.

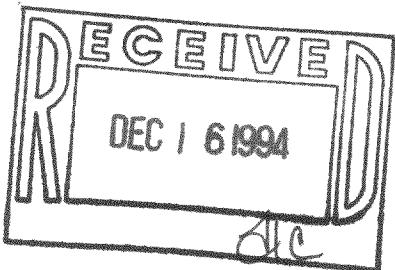


I have surveyed the above-described property, and the map hereon is a true representation thereof and shows the size and location of the property, its exterior boundaries, the location and dimensions of all visible structures thereon, fences, apparent easements and roadways and visible encroachments, if any.

This survey is made for the exclusive use of the present owners of the property, and also those who purchase, mortgage, or guarantee the title thereto, within one year from date hereof.

Dated at Burlington, this 20th day,
of Sept^{ember} 19⁹⁴.

John F. Degen, Land Surveyor S 442
589 N. Pine St. Burlington, WI 53105

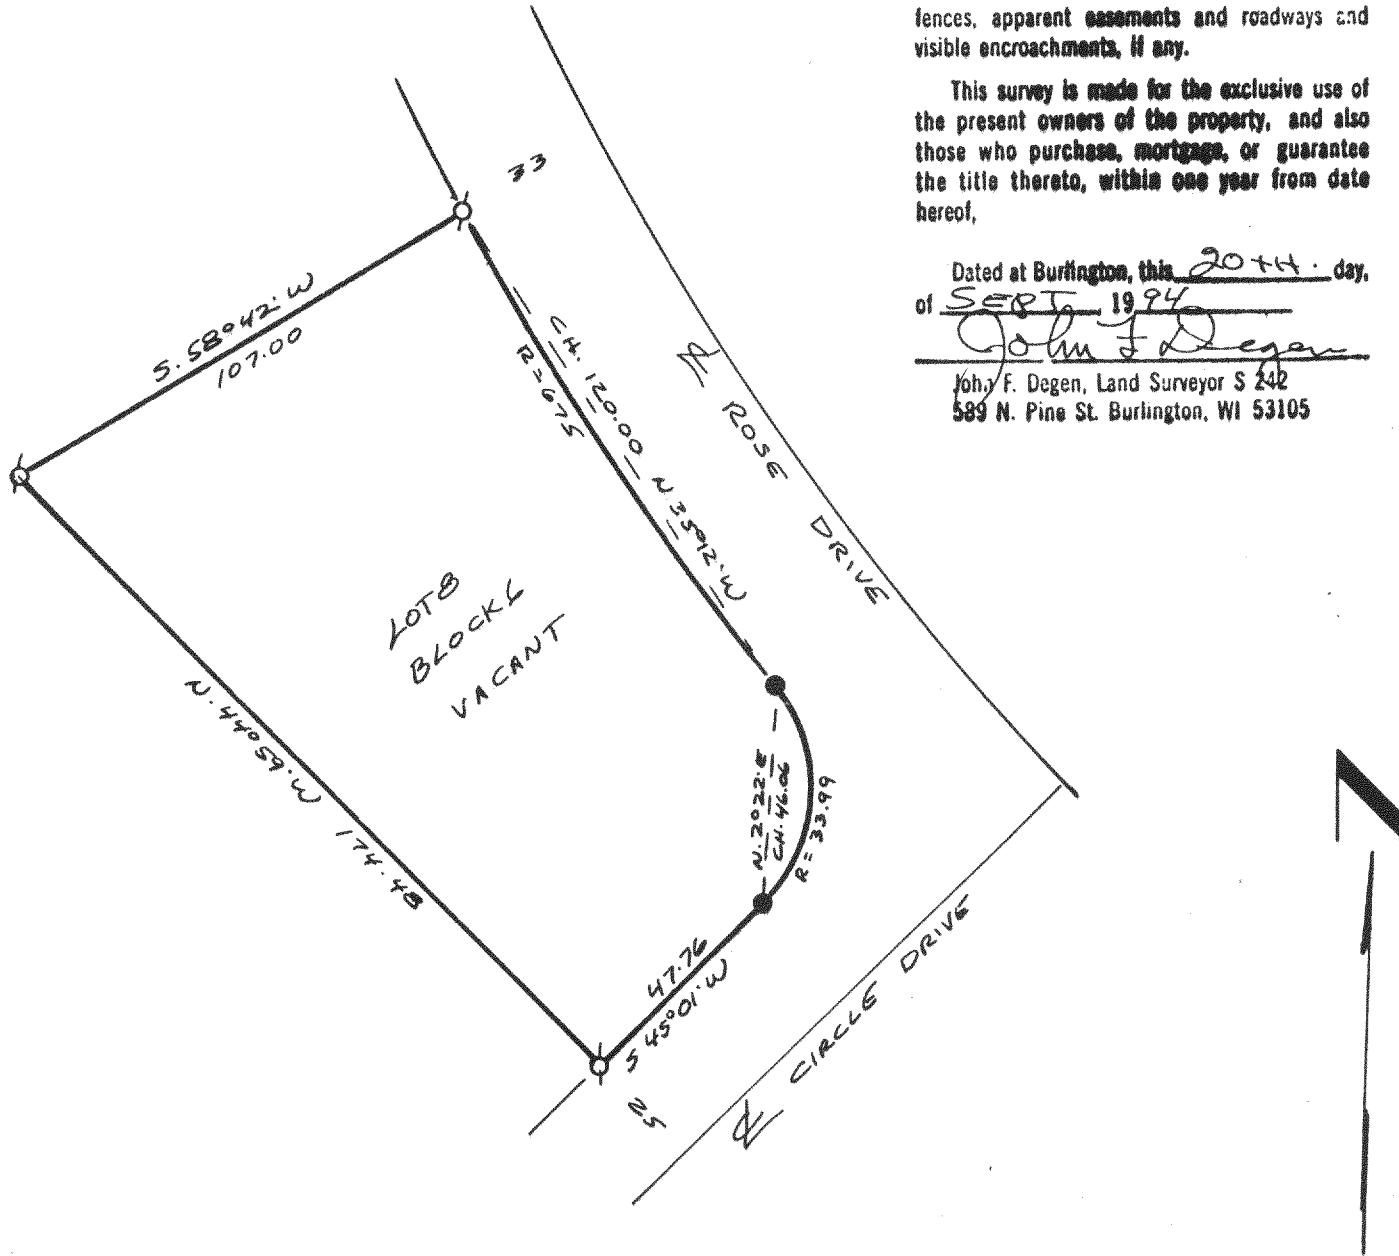

MRN 6- last

118-1406 16-F-4 #43