


DUNHAM SURVEYING, S.C.
SURVEYING & SUBDIVIDING
DELAVER, WISCONSIN 53115

LAKE GENEVA HIGHWAY

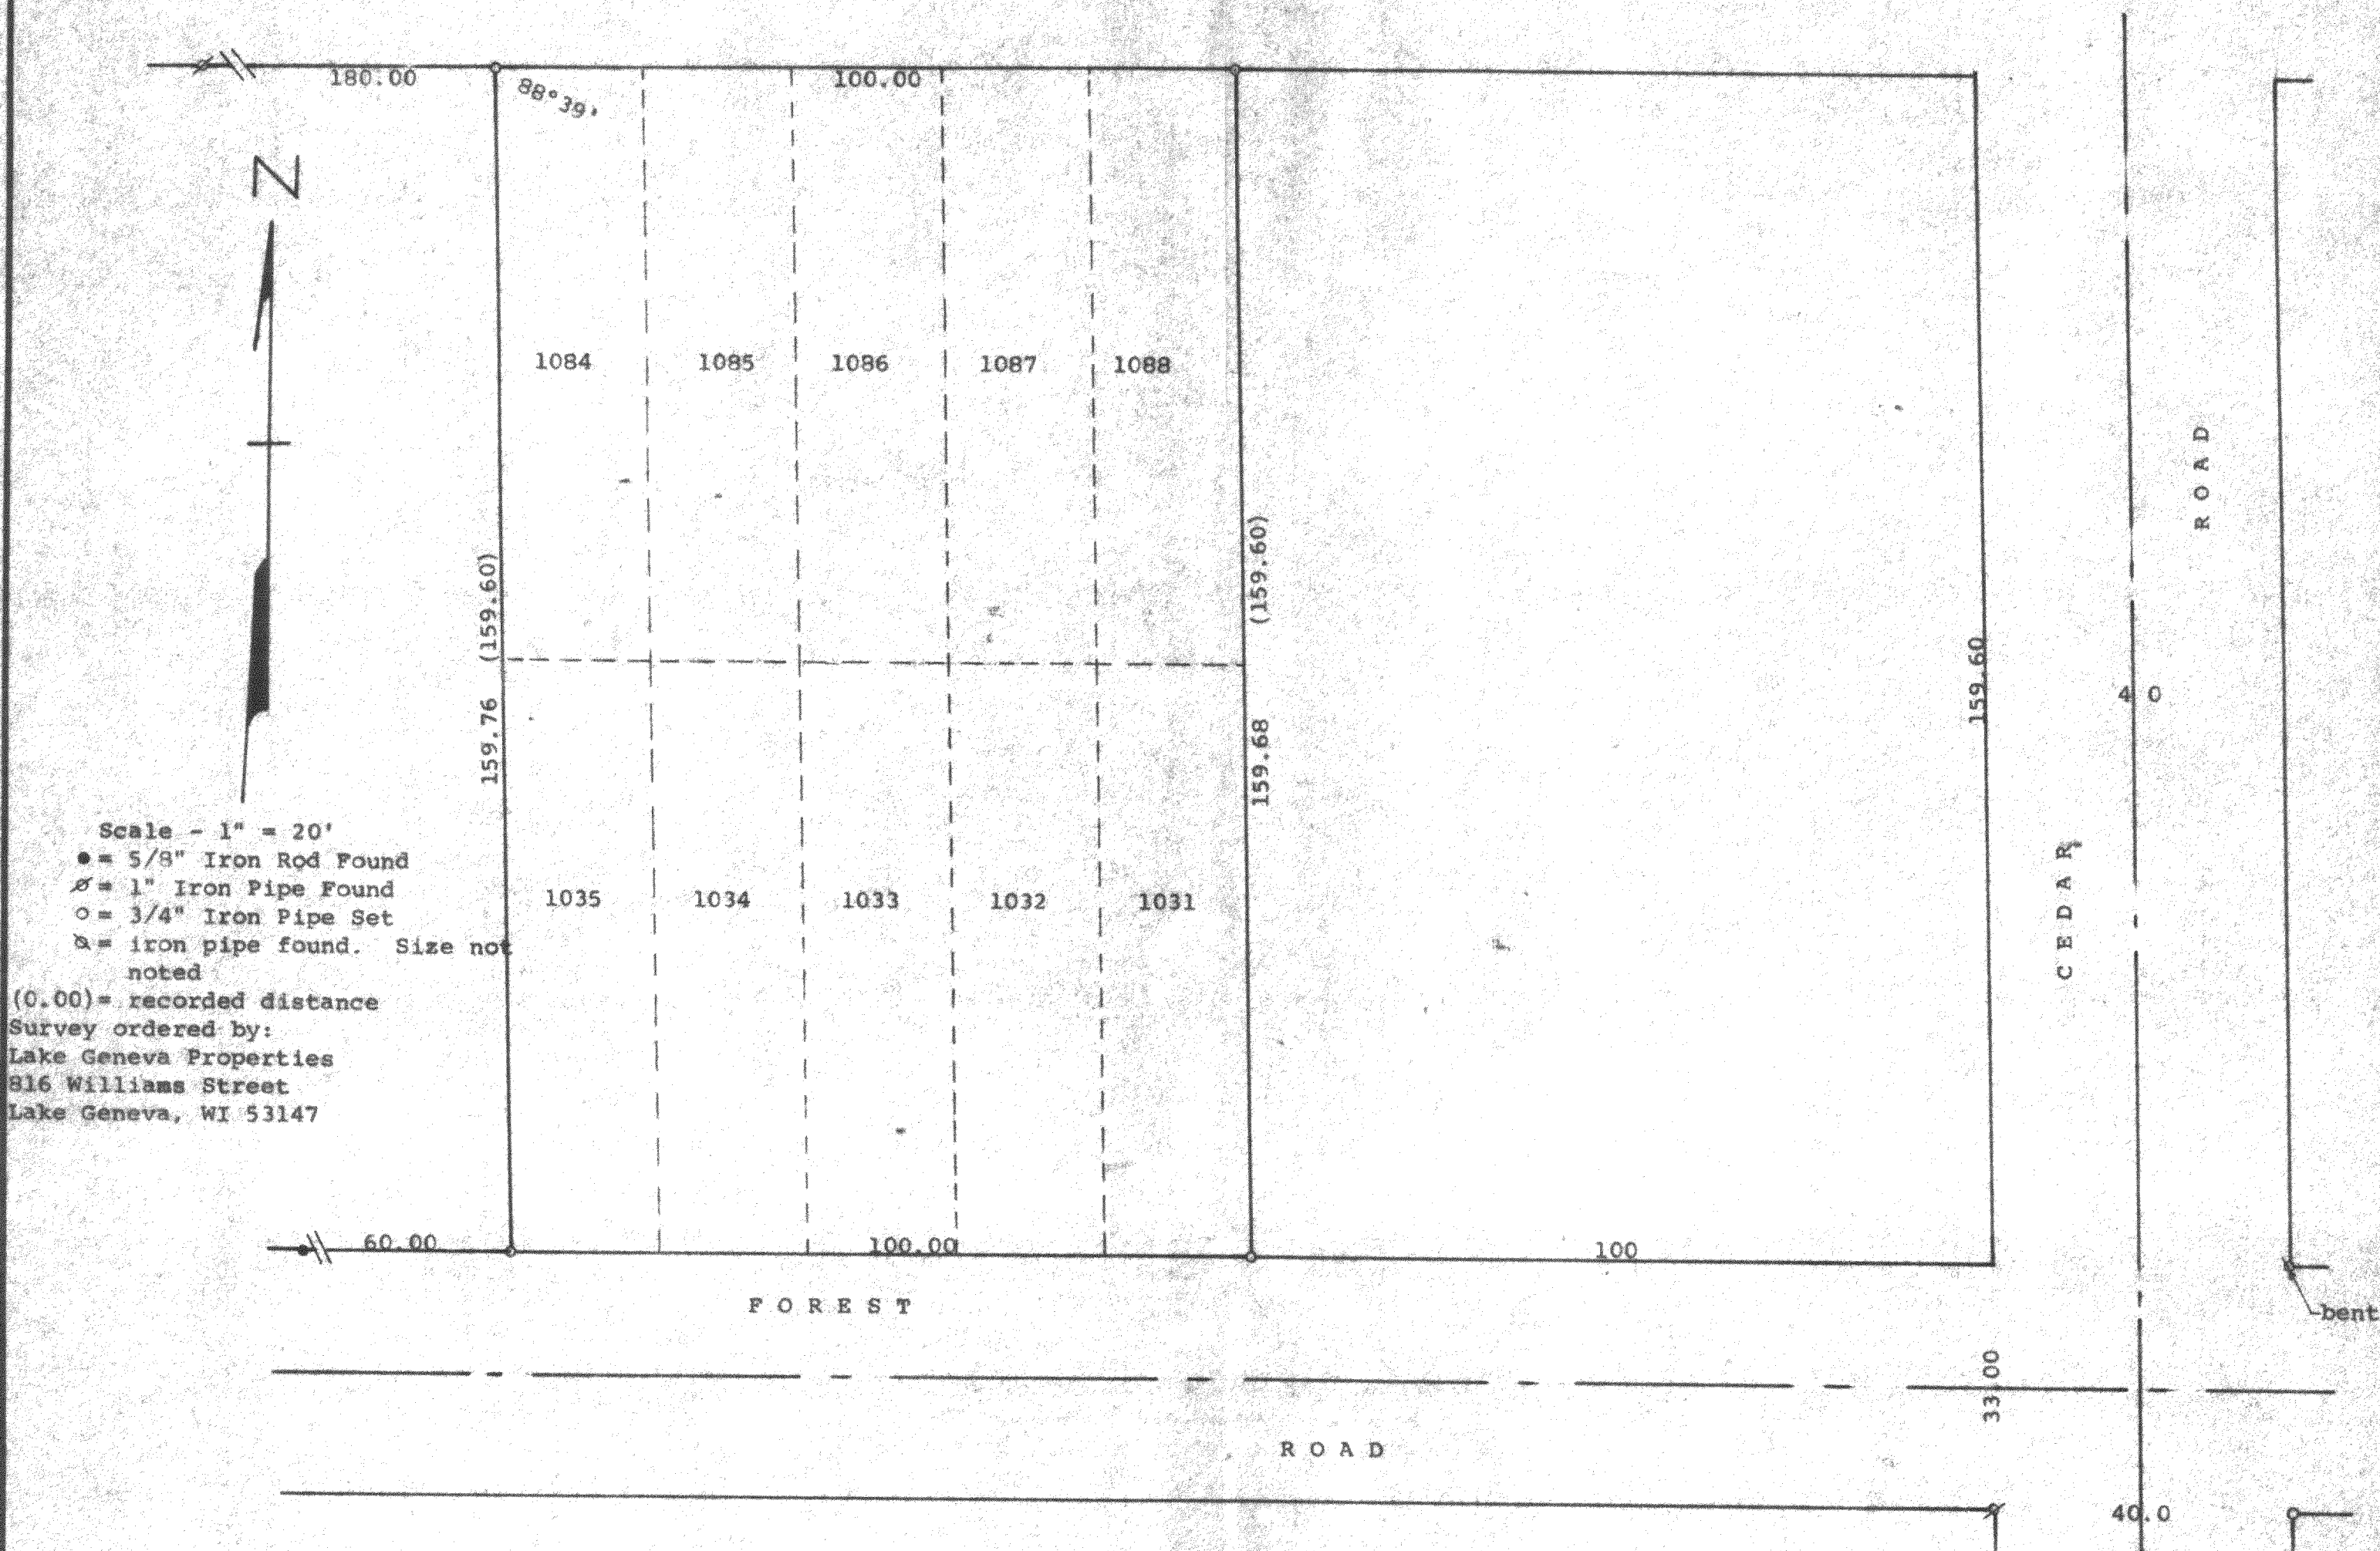

STATE OF WISCONSIN) ss
COUNTY OF WALWORTH)



I, George T. Dunham, Surveyor, certify that I have surveyed the property described as follows:

Lots 1084-1088 inclusive and Lots 1031-1035 inclusive in Block 9 of Pell Lake Highlands, a subdivision located in Section 16, T 1 N, R 18 E, Walworth County, Wisconsin

and that the plat shown hereon is a correct representation thereof and shows the size and location of the property, its exterior boundaries, the location of all visible structures and dimensions of all principal buildings thereon, boundary fences, apparent easements, roadways and visible encroachments, if any, and that I have surveyed the property hereon described, according to the official records, to the best of my knowledge and belief.

February 28, 1995

George T. Dunham
George T. Dunham, Surveyor

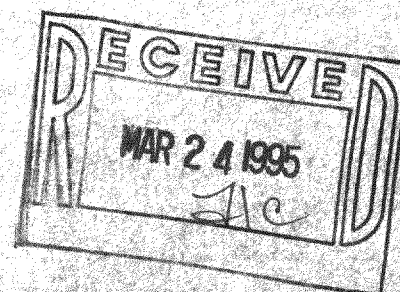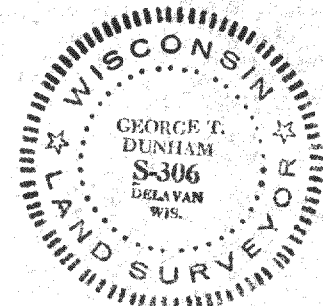

MPLH-217
MPLH-228
MPLH-215

118-1427