


HAROLD H. KOLB
 REGISTERED PROFESSIONAL LAND SURVEYOR
 LAKE GENEVA, WISCONSIN

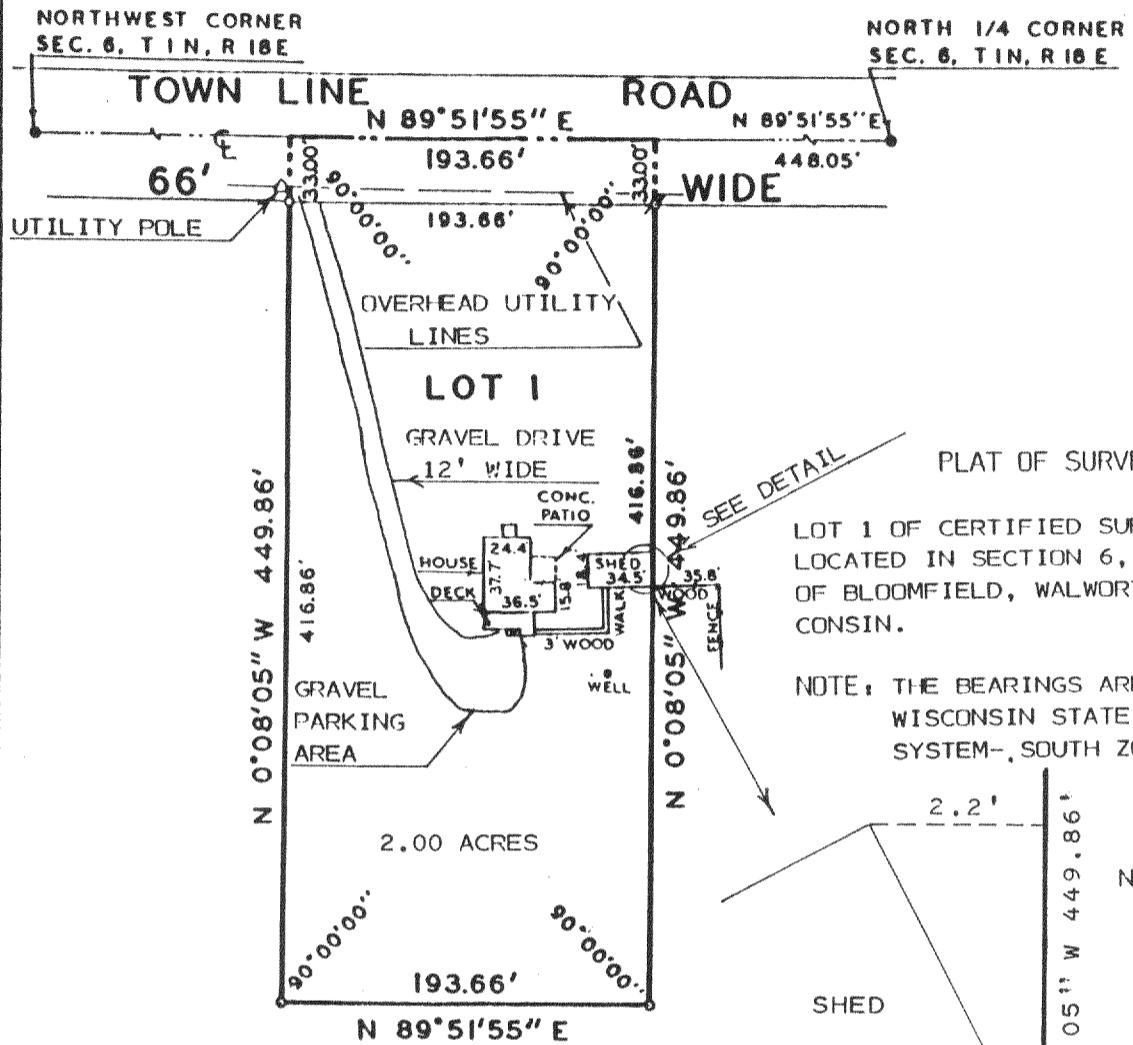

ORDERED BY: KEEFE REAL ESTATE, INC.
 704 W. MAIN STREET
 LAKE GENEVA, WI. 53147

FOR: WILLIAM HOST, OWNER

RECEIVED

N



0 75
 50 100
 SCALE IN FEET

LEGEND

- - IRON PIPE PLACED, 1" x 24" 1.13 LB./LIN. FT.
- - CONCRETE MONUMENT, 8" DIA. x 30"
- ∅ - IRON PIPE FOUND

HAROLD H. KOLB
 WISCONSIN REGISTERED LAND SURVEYOR, S-187
 DATE AUGUST 19, 1994