


LOTS 1055 THRU 1064 IN BLOCK 9 OF PELL LAKE HIGHLANDS, A SUBDIVISION LOCATED IN SECTION 16, T. 1 N., R. 18 E. OF THE 4TH P.M., TOWNSHIP OF BLOOMFIELD, COUNTY OF WALWORTH, STATE OF WISCONSIN

✕ = IRON ROD SET.

O = IRON PIPE SET.

This survey is made for the exclusive use of the present owners of the property, and also those who purchase, mortgage, or guarantee the title thereto, within one year from date hereof.

Dated at Burlington, this 20th day
of June, 1995
John F. Degen
John F. Degen, Land Surveyor S 242
589 N. Pine St. Burlington, WI 53105

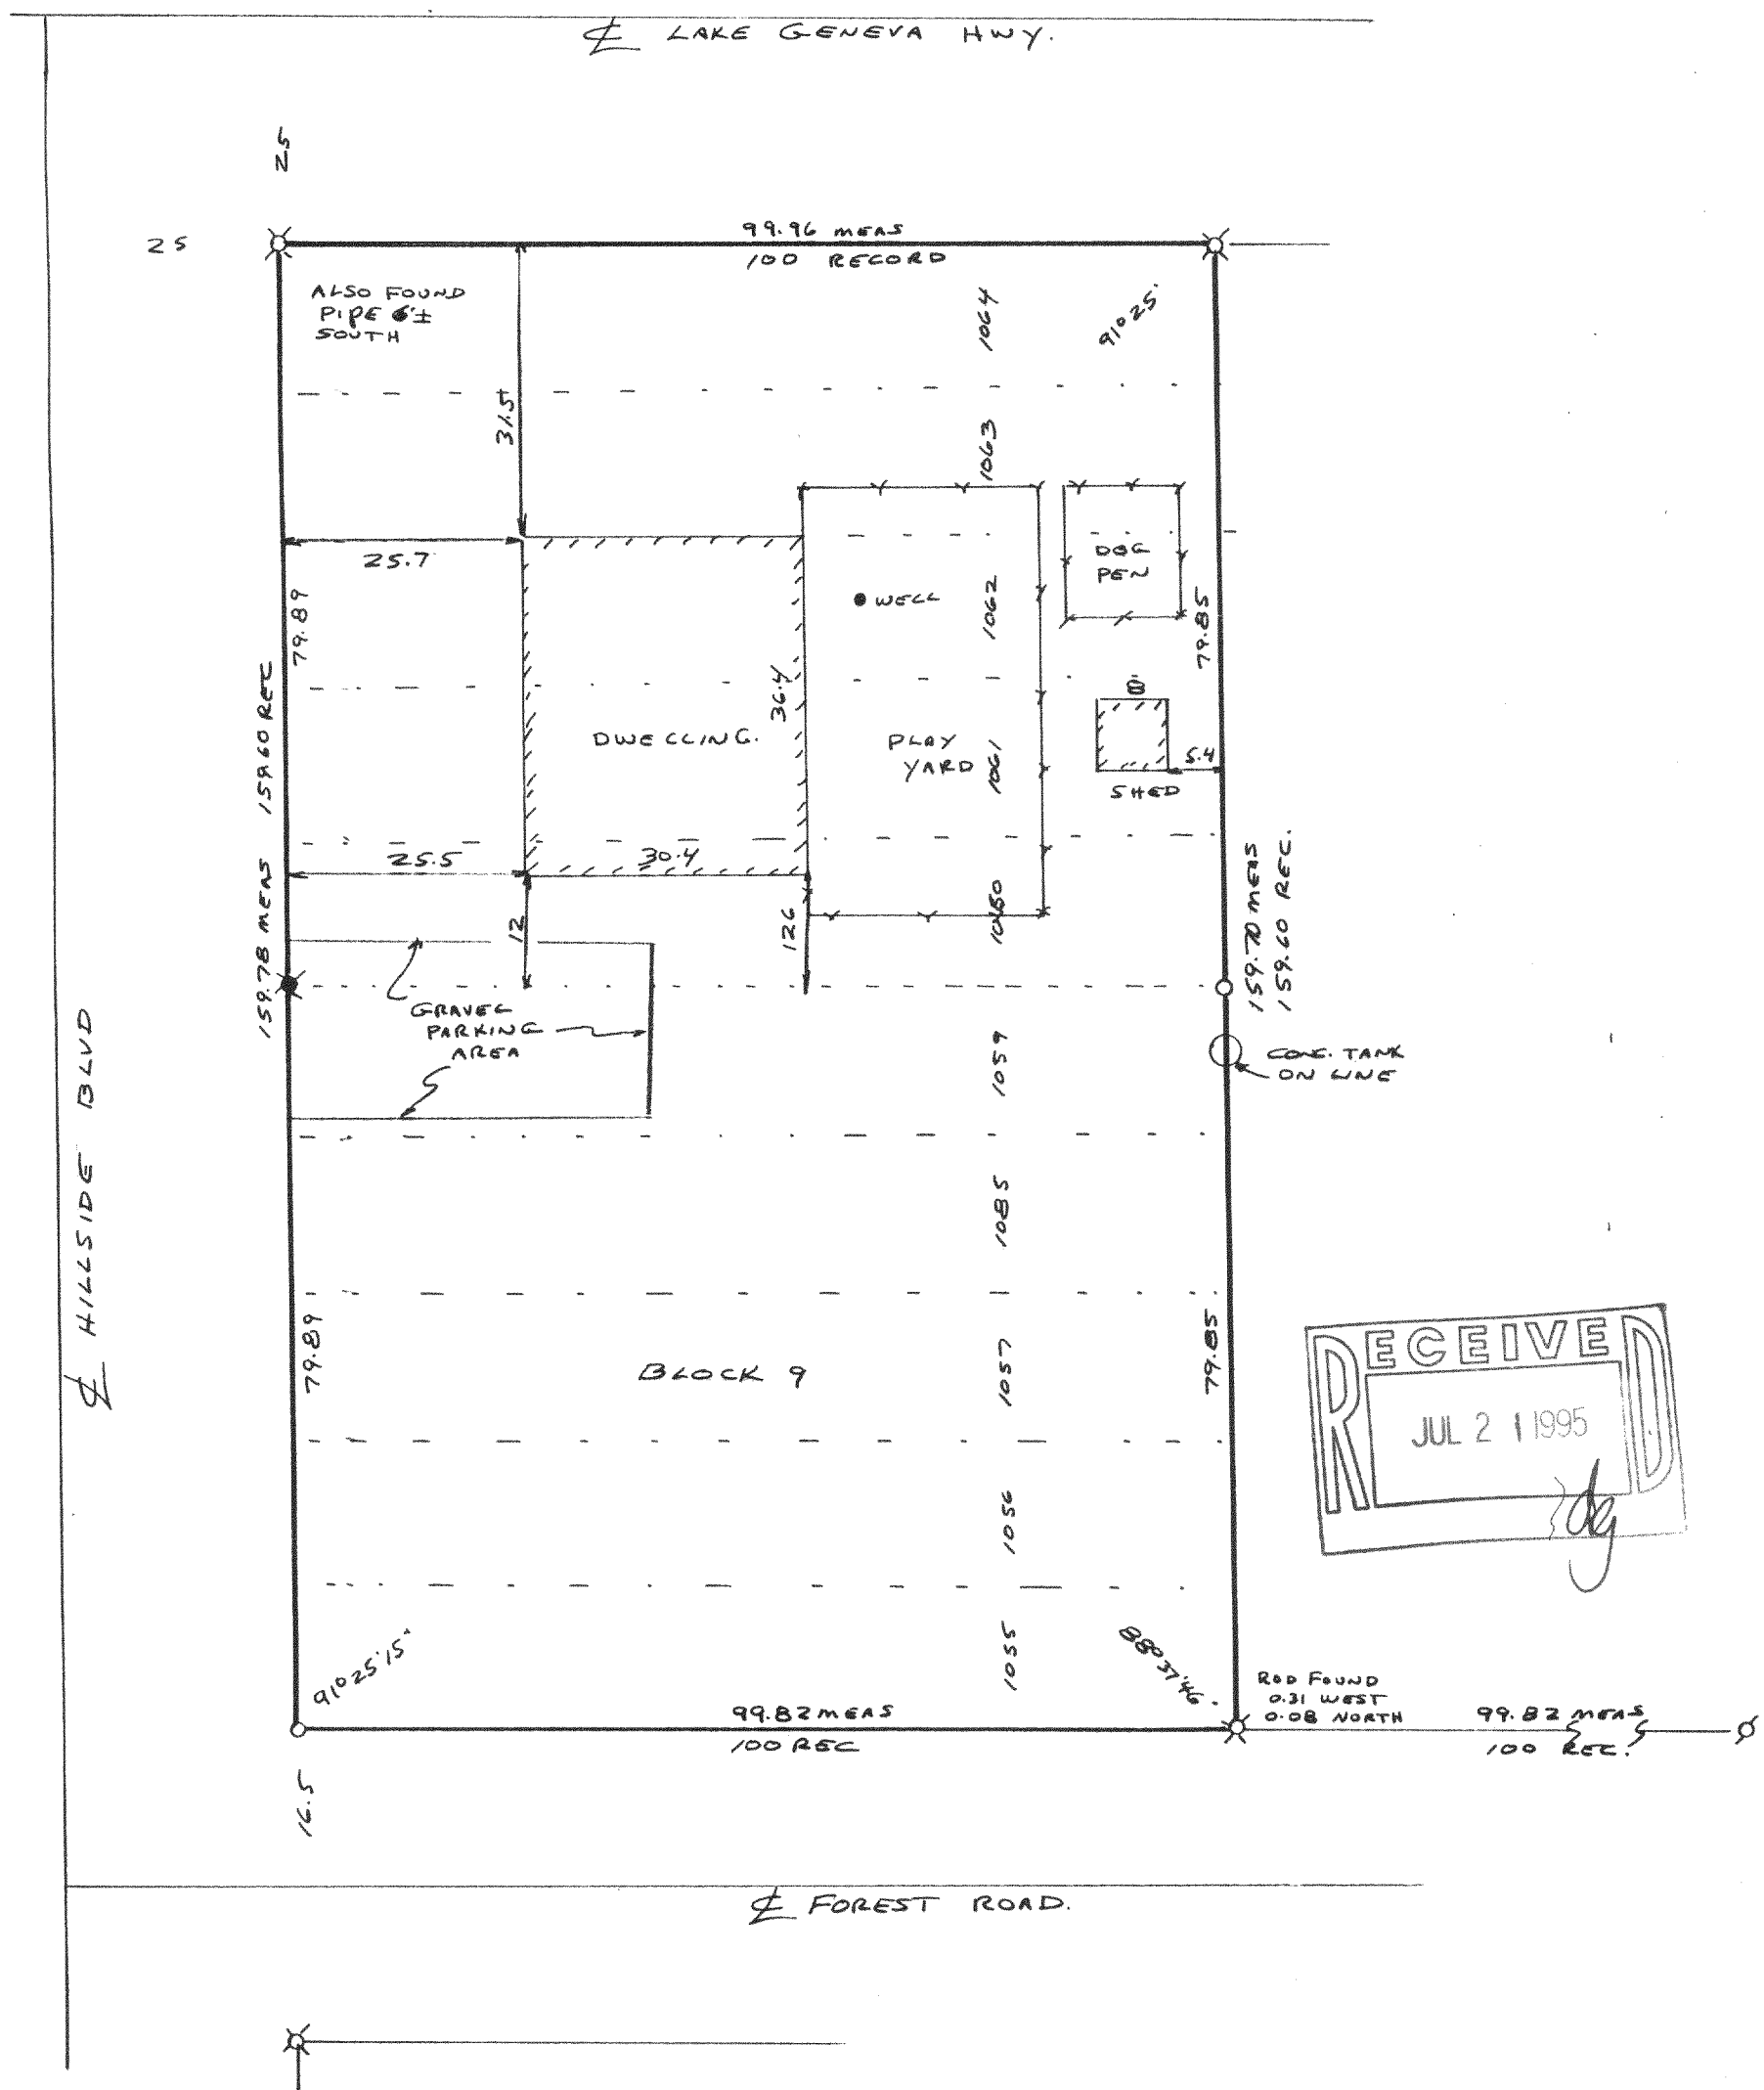

19-D-3 #1

MPLH-222

118-1468