
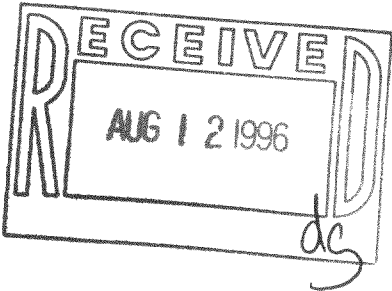


PLAT OF SURVEY
OF
LOTS 22, 23, 24, IN BLOCK 6, OF ROSE NIPPERSINK GARDENS, A SUBDIVISION OF PART OF SECTION 24, T. 1 N., R. 18 E. OF THE 4TH P.M., TOWNSHIP OF
BLOOMFIELD, COUNTY OF WALWORTH, STATE OF WISCONSIN.

FOR : MEISNER SCALE 1" = 40' ○ = IRON PIPE SET ♂ = IRON PIPE FOUND.

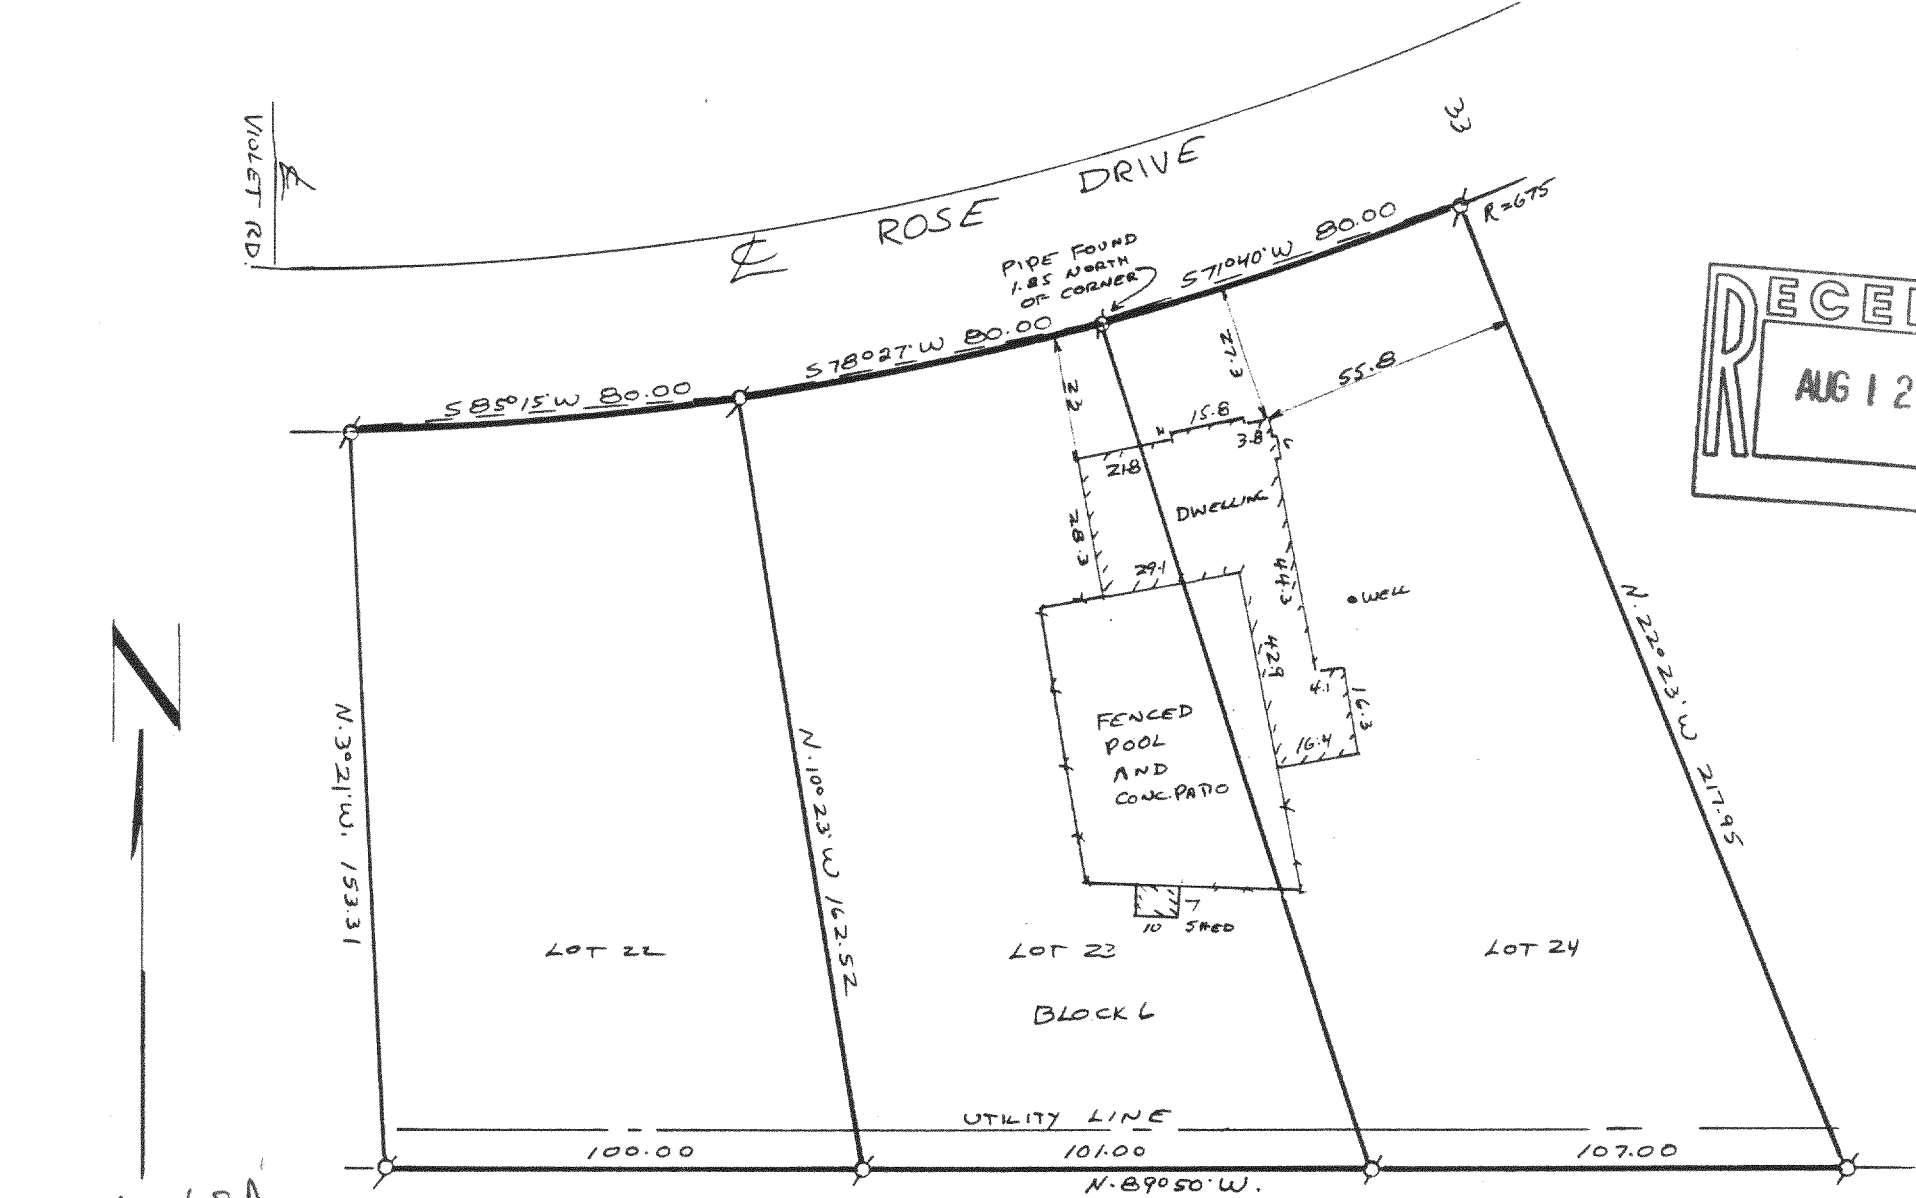

I have surveyed the above-described property, and the map hereon is a true representation thereof and shows the size and location of the property, its exterior boundaries, the location and dimensions of all visible structures thereon, fences, apparent easements and roadways and visible encroachments, if any.

This survey is made for the exclusive use of the present owners of the property, and also those who purchase, mortgage, or guarantee the title thereto, within one year from date hereof.

Dated at Burlington, this 11th day, of JUNE, 1996

John F. Degen
John F. Degen, Land Surveyor S 242
589 N. Pine St. Burlington, WI 53105

MRNG-68A
MRNG-69
118-1510