

LOTS 6783 THROUGH 6789 IN BLOCK 144 OF SECTION 4 OF PELL LAKE SUBDIVISION, IN THE TOWN OF BLOOMFIELD, WALWORTH COUNTY, WISCONSIN.

FOR: ANDERSON

SCALE 1" = 30'



O = IRON PIPE SET.

Ø = IRON PIPE FOUND.

I have surveyed the above-described property, and the map hereon is a true representation thereof and shows the size and location of the property, its exterior boundaries, the location and dimensions of all visible structures thereon, fences, apparent easements and roadways and visible encroachments, if any.

This survey is made for the exclusive use of the present owners of the property, and also those who purchase, mortgage, or guarantee the title thereto, within one year from date hereof

Dated at Burlington, this 2nd day,
of July, 1996
John F. Degen
John F. Degen, Land Surveyor S242
689 N. Pine St. Burlington, WI 53105

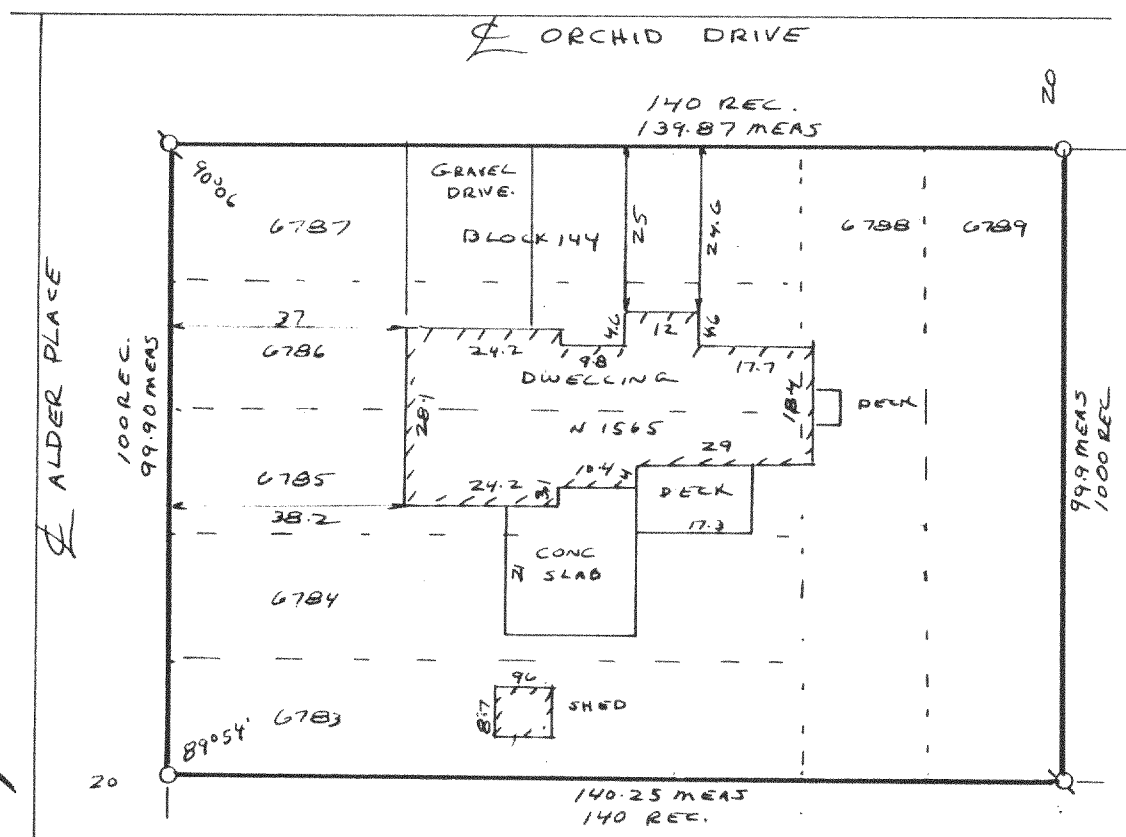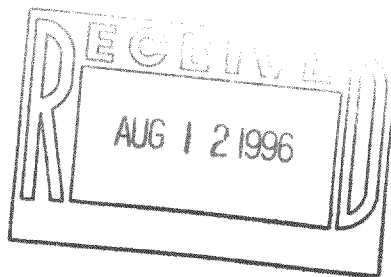

MPL-1478
118-1515