


FARRIS, HANSEN & ASSOCIATES, INC.
ENGINEERING, ARCHITECTURE, SURVEYING
7 RIDGEWAY COURT - P.O. BOX 437 ELKHORN, WISCONSIN 53121
PHONE: (414) 723-2098 FAX: (414) 723-5886

PLAT OF SURVEY

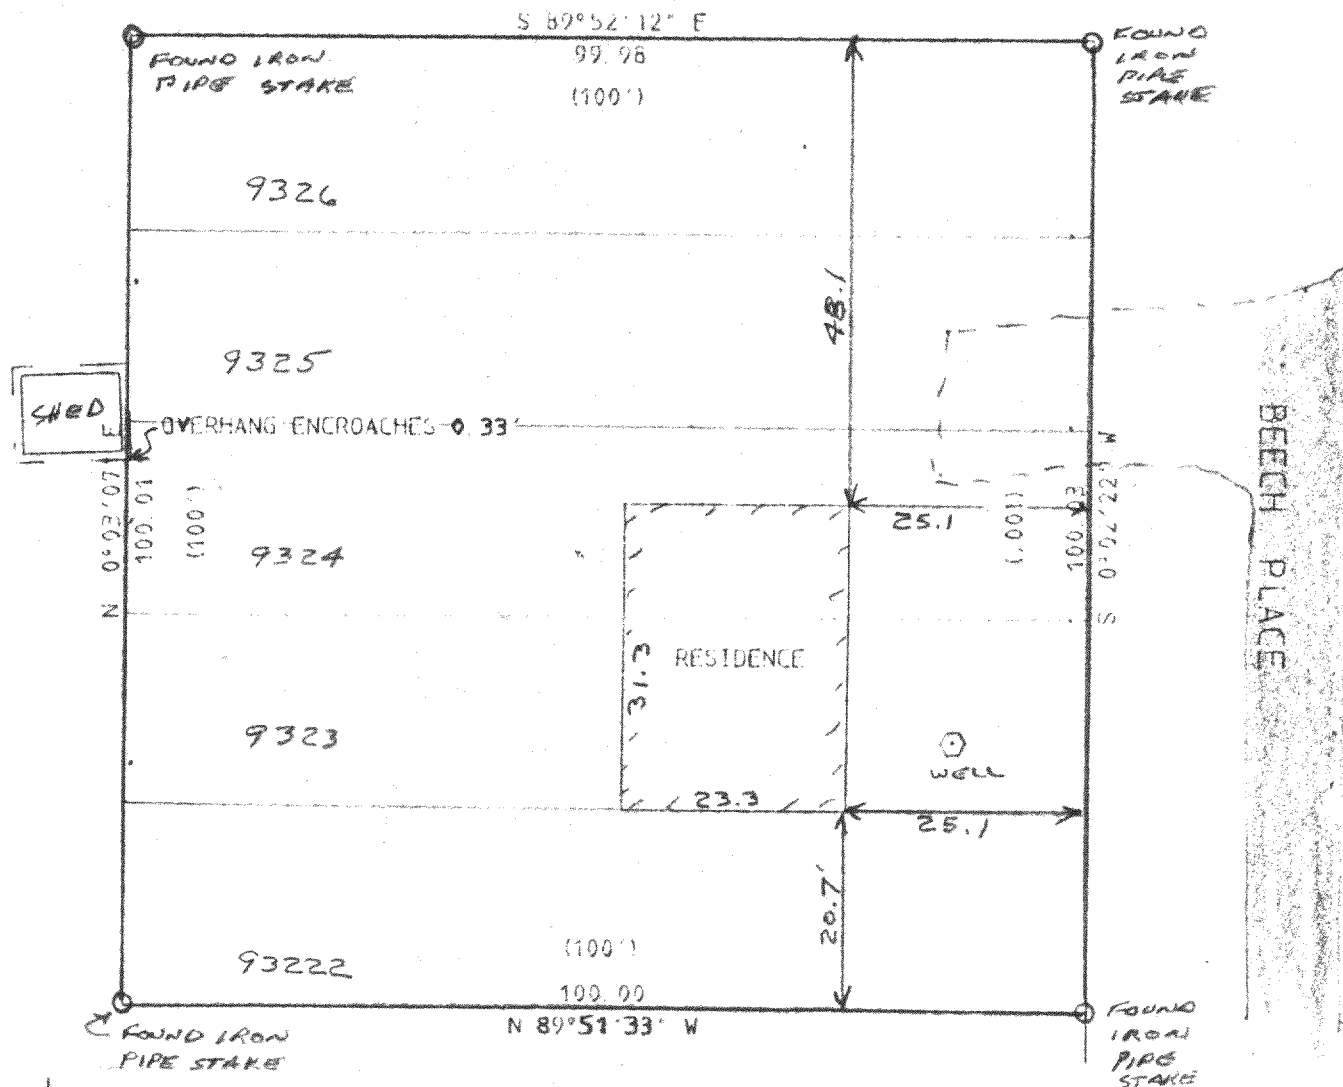

ASSIGNED WEST LINE
BEECH PLACE
S 00°02'22" W


RECEIVED
JUN 10 1996

LOTS 9322 - 9326, BLOCK 167
SECTION 5 OF PELL LAKE SUBDIVISION
TOWN 1 NORTH, RANGE 18 EAST
WALWORTH COUNTY, WISCONSIN

WORK ORDERED BY:
WILLIAM HELLYER
10 W. TERRA COTTA
CRYSTAL LAKE, IL.



MAP SCALE IN FEET ORIGINAL 1" = 20'

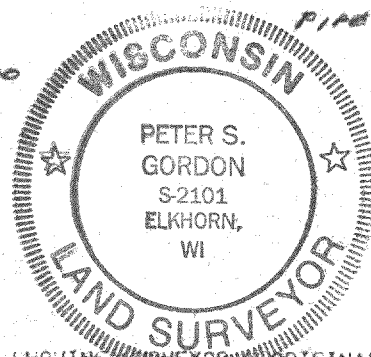

MA-1889

118-1522

NOTE: COPIES OF THIS MAP TO WHICH THE FOLLOWING CERTIFICATE WILL APPLY ARE BLUE LINE PRINTS SHOWING SURVEYOR'S ORIGINAL SEAL AND SIGNATURE IN BLACK INK. COPIES BY ANY OTHER MEANS MAY HAVE ALTERATIONS WHICH DO NOT REPRESENT THE SURVEYOR'S WORK PRODUCT.

I HEREBY CERTIFY THAT THE ABOVE DESCRIBED PROPERTY HAS BEEN SURVEYED UNDER MY DIRECTION AND THAT THE ABOVE MAP IS A TRUE REPRESENTATION THEREOF AND SHOWS THE SIZE AND LOCATION OF THE PROPERTY AND ITS EXTERIOR BOUNDARIES. THIS SURVEY IS MADE FOR THE USE OF THE PRESENT OWNERS OF THE PROPERTY, AND ALSO THOSE WHO PURCHASE, MORTGAGE, OR GUARANTEE THE TITLE THERETO WITHIN ONE YEAR FROM THE DATE HEREOF.

4/19/1994
DATED

Peter S. Gordon
PETER S. GORDON RLS 2101

PROJ 1479