


**HAROLD H. KOLB**

REGISTERED PROFESSIONAL LAND SURVEYOR  
LAKE GENEVA, WISCONSIN

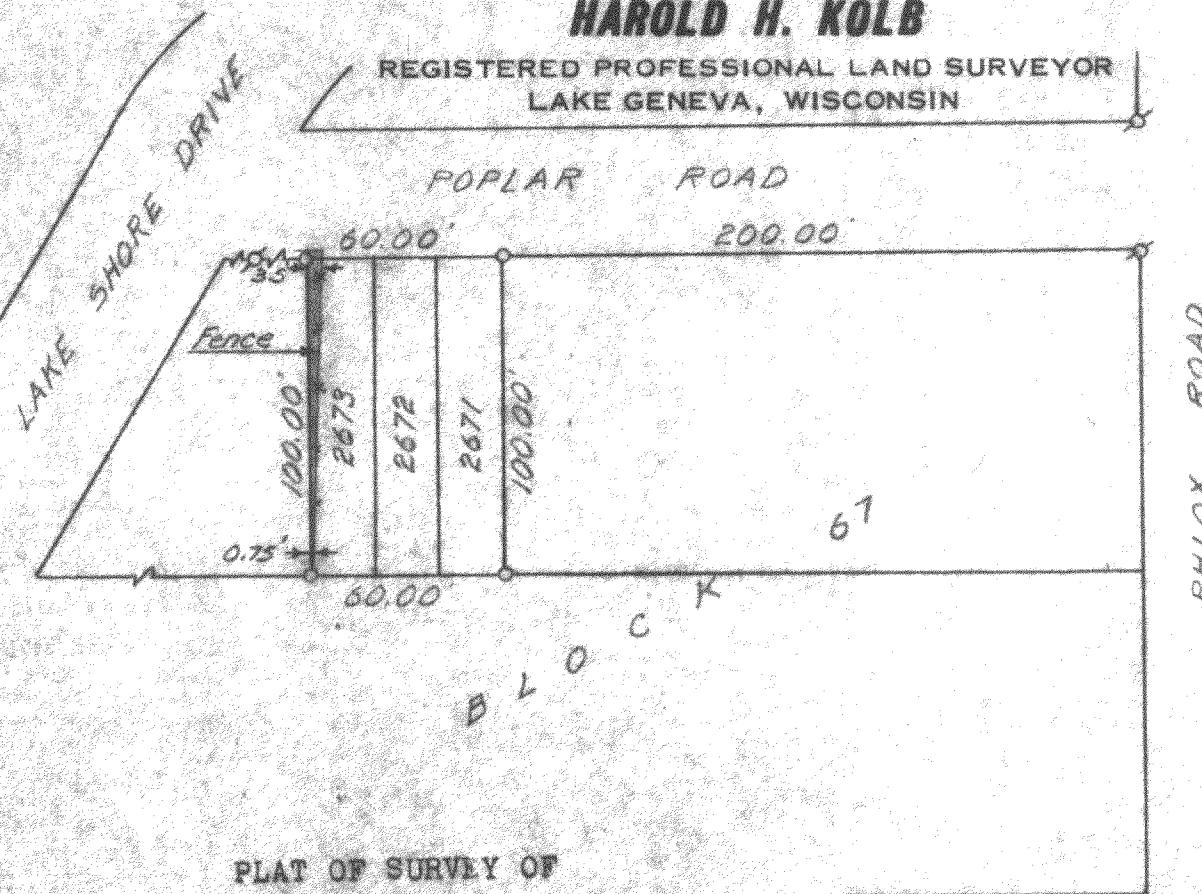

Scale 1"=60'

**PLAT OF SURVEY OF**

Lots 2671-2673, Block 67, Pell Lake Subdivision, located in the Northwest 1/4 of Section 22, T 1 N, R 15 E, Walworth County, Wisconsin

**LEGEND**

- IRON PIPE FOUND
- — IRON PIPE PLACED
- — CONCRETE MONUMENT
- × — SPIKE

I, HAROLD H. KOLB, DO HEREBY CERTIFY THAT I HAVE SURVEYED THE PROPERTY HEREON DESCRIBED ACCORDING TO THE OFFICIAL RECORDS, AND THAT THE PLAT HEREON IS A CORRECT REPRESENTATION OF THE LOT LINES.

*Harold H. Kolb*

HAROLD H. KOLB  
WISCONSIN REGISTERED LAND SURVEYOR, S-187  
DATE October 14, 1964

118-153