


PHONE 414-537-4874
FAX 414-537-4221

RECEIVED
MAY 28 1996
dg

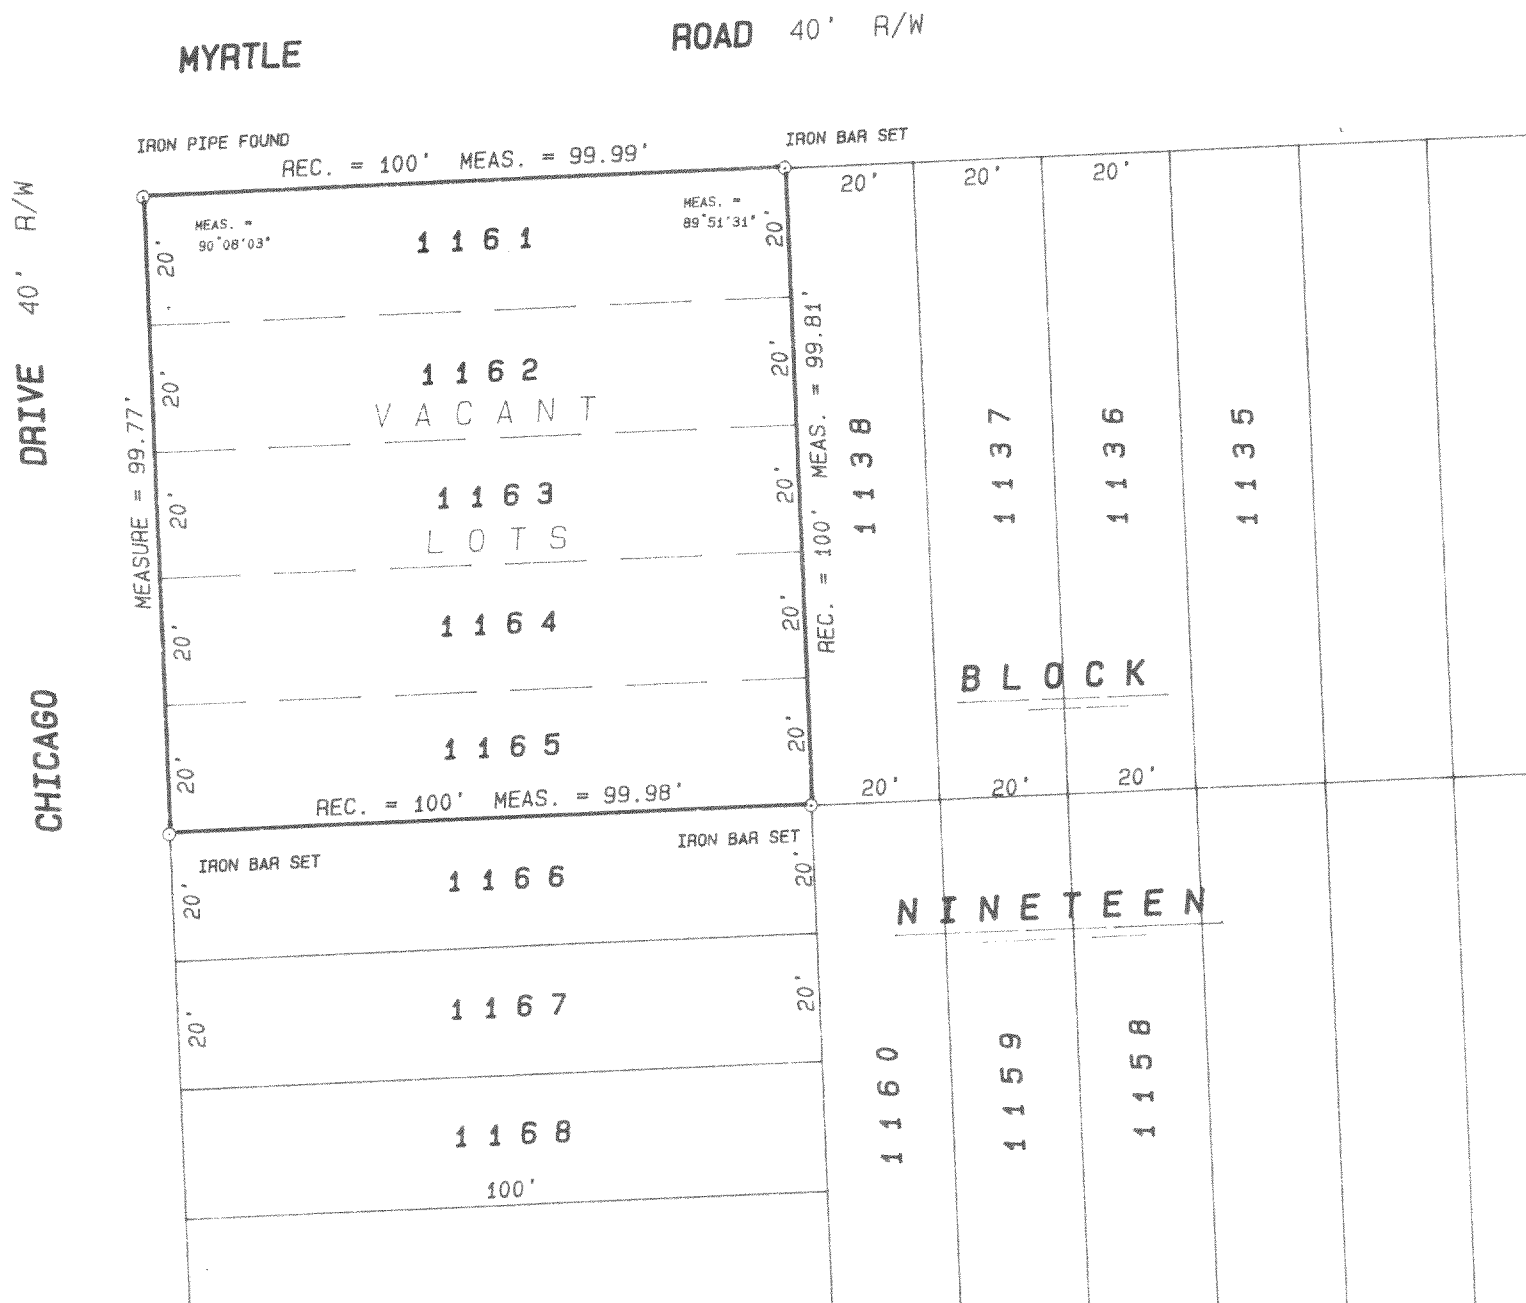

Mark A. Bolender
Wisconsin Registered Land Surveyor S - 1784

MPLA - 237
118-1541