



LOTS 5 & 6, BLOCK 1 OF ROSE NIPPERSINK GARDENS, A SUBDIVISION LOCATED IN SECTION 24, T. 1 N., R.18 E. OF THE 4TH P.M., TOWNSHIP OF BLOOMFIELD, COUNTY OF WALWORTH, STATE OF WISCONSIN.

○ = IRON PIPE SET.

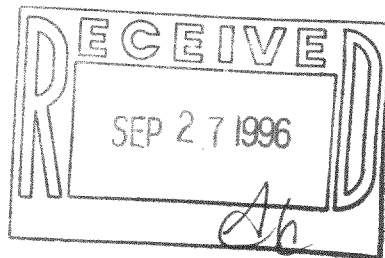

John F. Dagen, Land Surveyor S 242
589 N. Pine St. Burlington, WI 53105

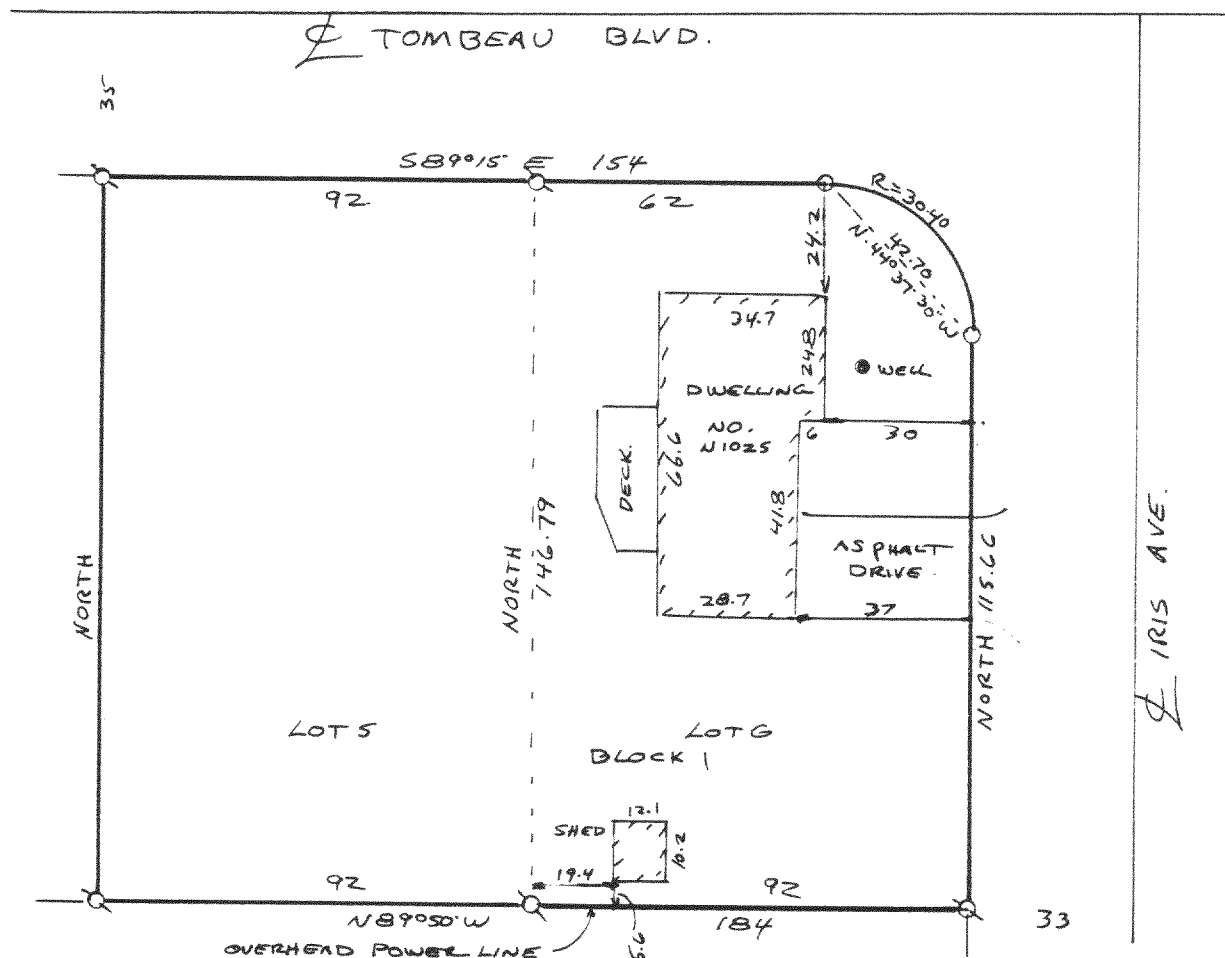

19-A-1 #49

MRNG-5
118-1562