


PLAT OF SURVEY
OF

LOTS 706 THRU 711, BLOCK 14, OF PELL LAKE HIGHLANDS, A SUBDIVISION LOCATED IN THE
TOWN OF BLOOMFIELD, WALWORTH COUNTY, WISCONSIN.

FOR: MURPHREE

SCALE 1" = 30'

Ø = IRON PIPE FOUND.

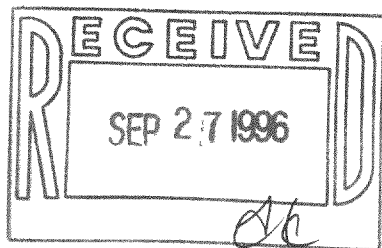


I have surveyed the above-described property,
and the map hereon is a true representation
thereof and shows the size and location of the
property, its exterior boundaries, the location
and dimensions of all visible structures thereon,
fences, apparent easements and roadways and
visible encroachments, if any.

This survey is made for the exclusive use of
the present owners of the property, and also
those who purchase, mortgage, or guarantee
the title thereto, within one year from date
hereof.

Dated at Burlington, this 10th day,
of SEPT, 1996

John F. Degen
John F. Degen, Land Surveyor S 240
589 N. Pine St. Burlington, WI 53105

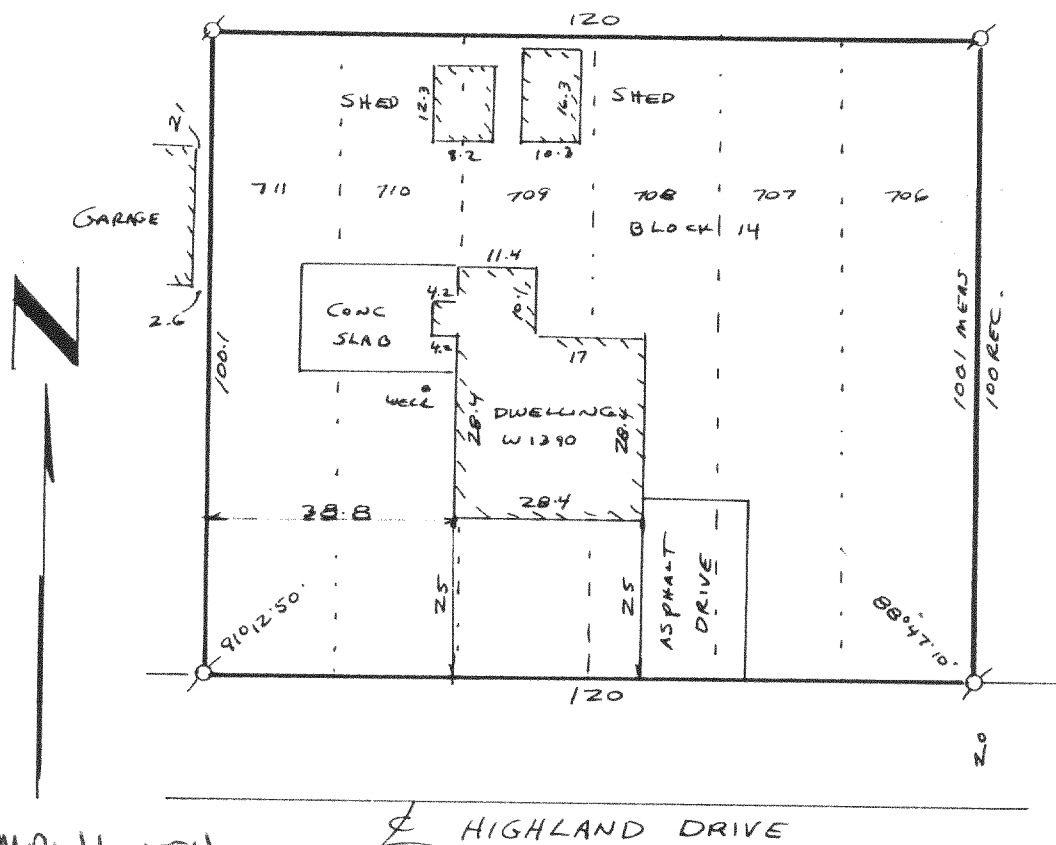

MPLH-154
118-1565