



LOTS 48 & 49, BLOCK 1, OF THE 8TH ADDITION TO SHINNER'S NIPPERSINK PARK, A SUBDIVISION OF PART OF SECTION 24,
T. 1 N., R. 18 E. OF THE 4TH P.M., TOWNSHIP OF BLOOMFIELD, COUNTY OF WALWORTH, STATE OF WISCONSIN.

FOR: BILL ENGELMAN

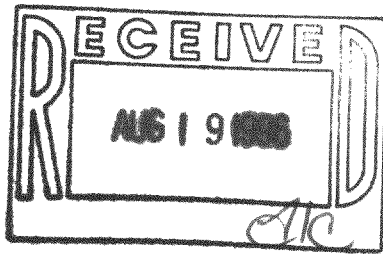

John F. Degen, Land Surveyor S 242

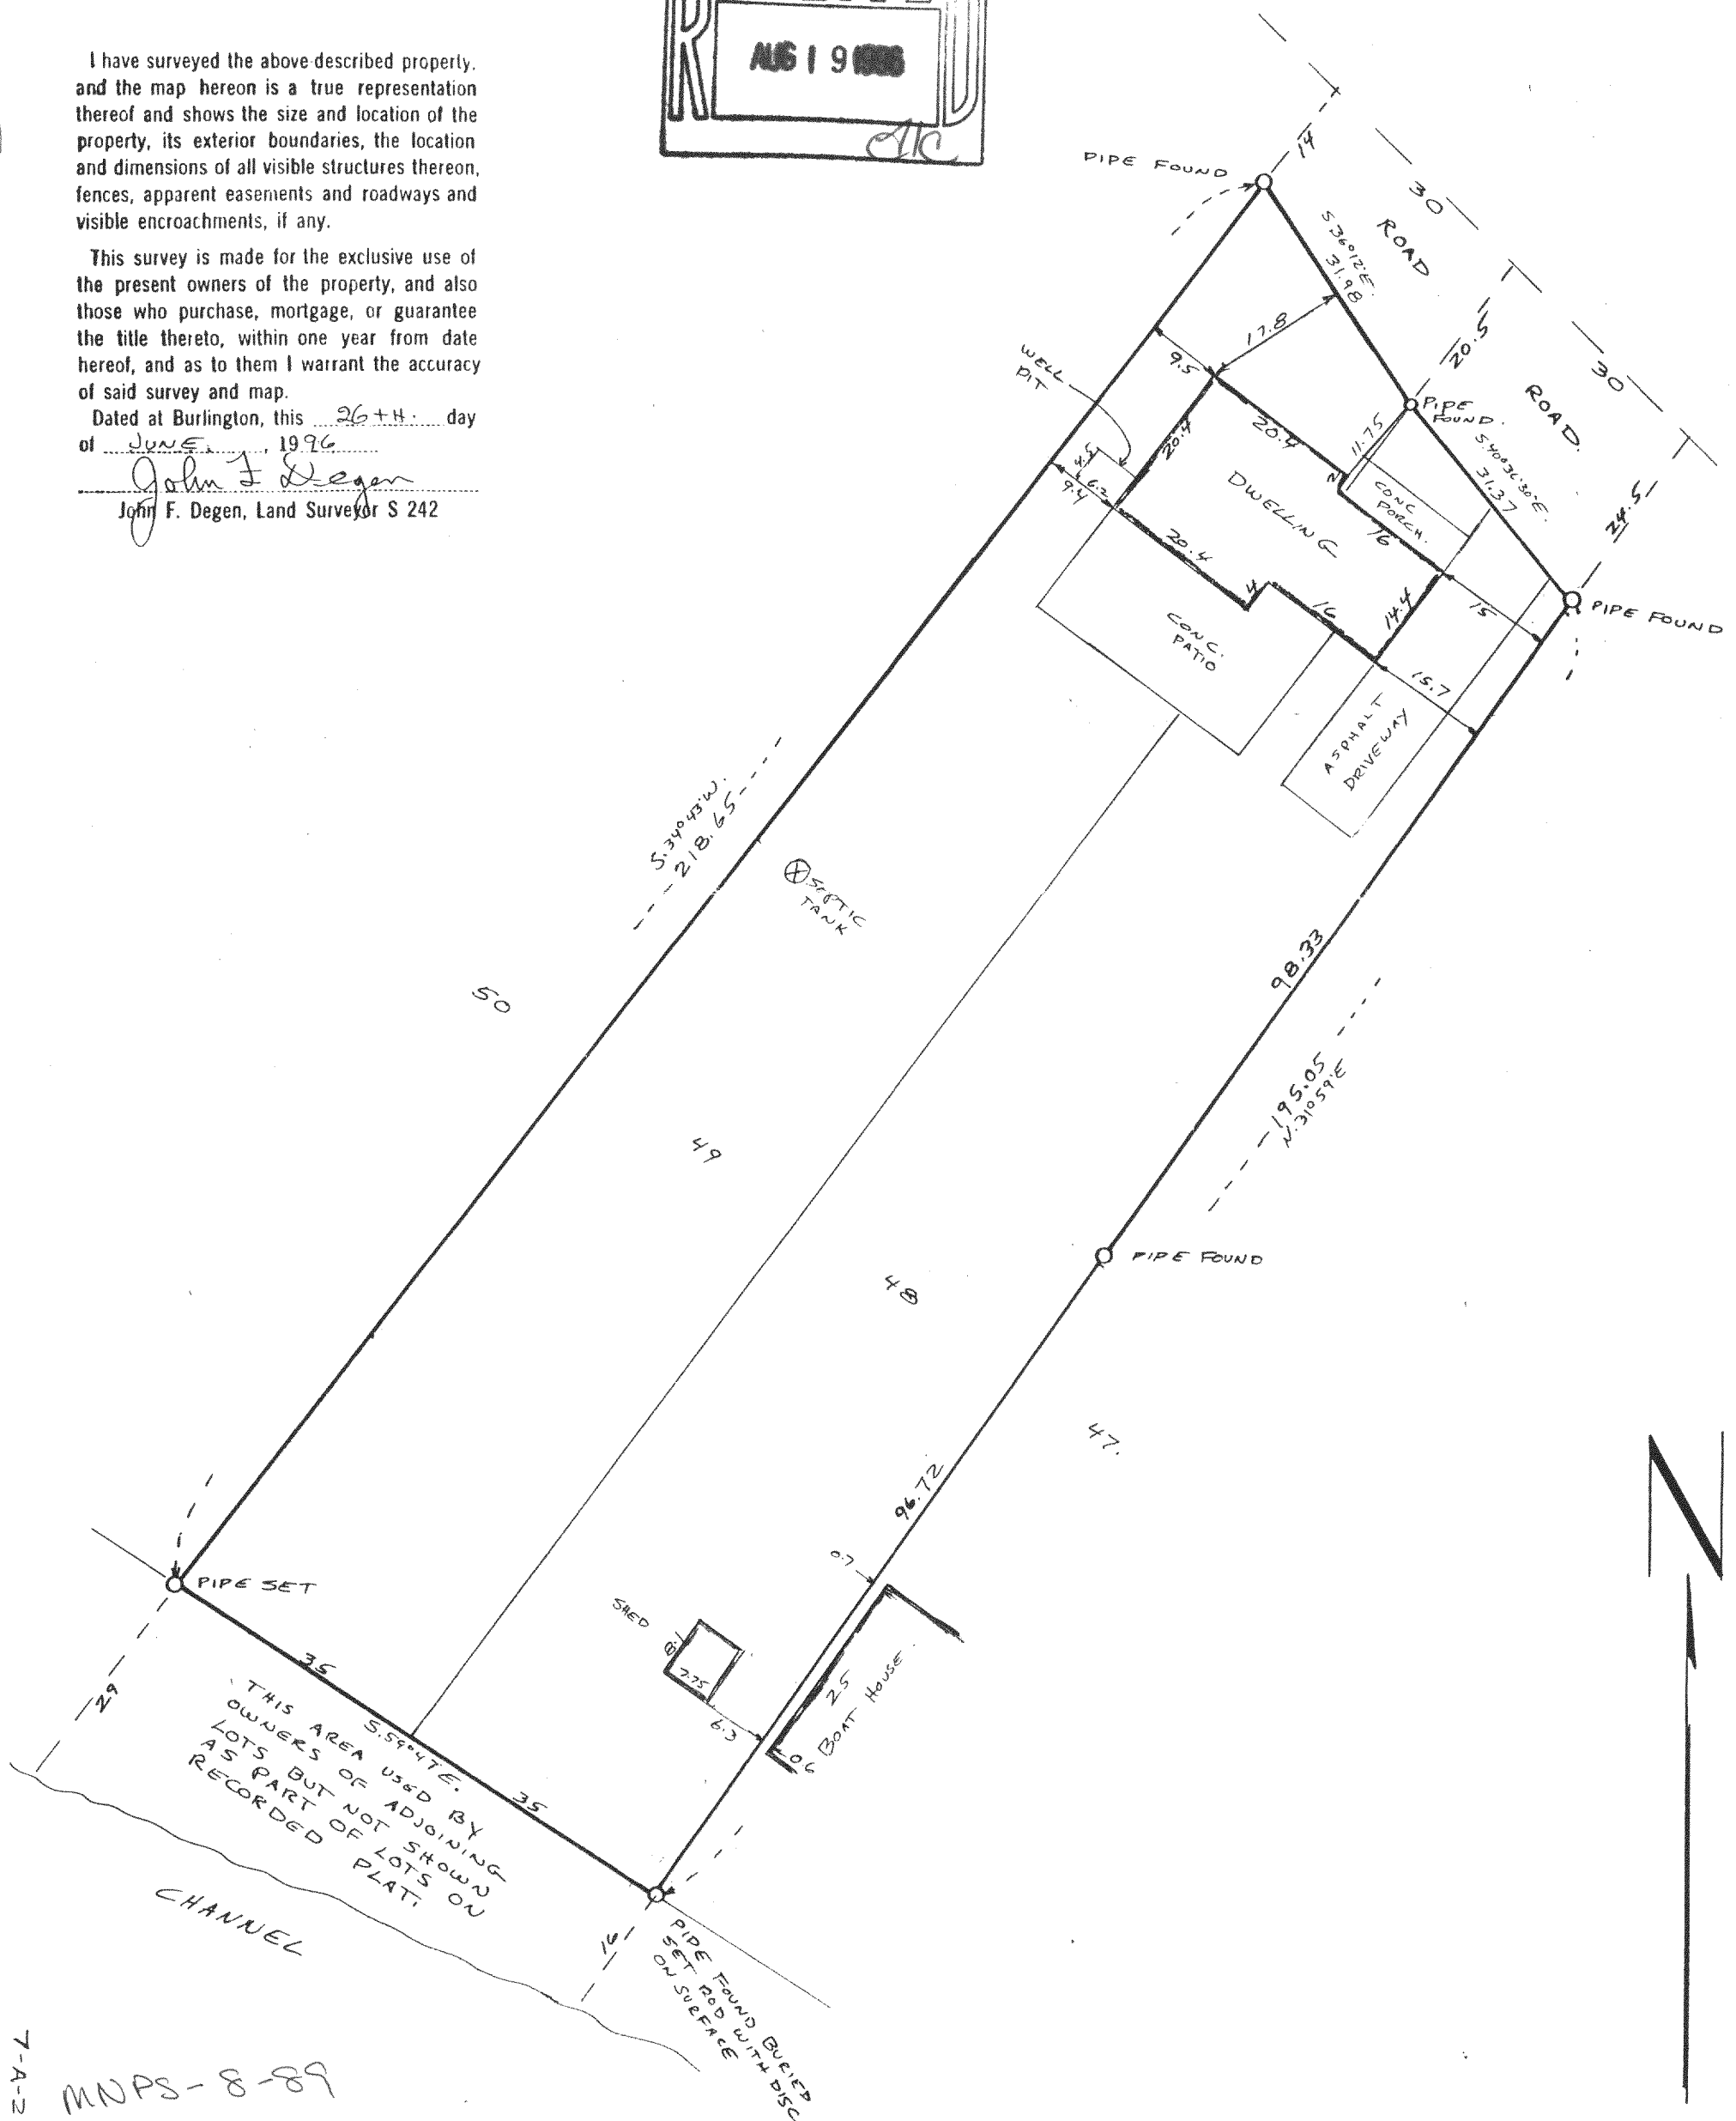

7-A-2 #14A

MNPS-8-89
118-1570