
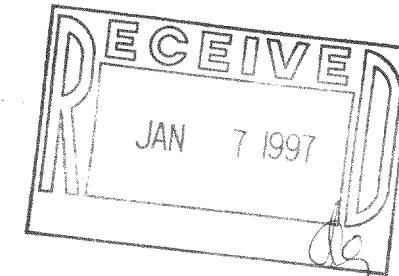


LOTS 22,23,24, IN BLOCK 6, OF ROSE NIPPERSINK GARDENS, A SUBDIVISION OF PART OF SECTION 24, T. 1 N., R. 18 E. OF THE 4TH P.M., TOWNSHIP OF BLOOMFIELD, COUNTY OF WALWORTH, STATE OF WIS. CONSIDERED.

♂ = IRON PIPE FOUND.

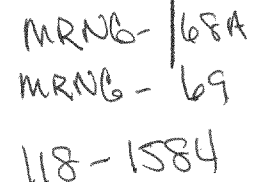

This survey is made for the exclusive use of the present owners of the property, and also those who purchase, mortgage, or guarantee the title thereto, within one year from date hereof.

REVISED TO SHOW PROPOSED GARAGE