

PLAT OF SURVEY
OF

LOTS 412 THROUGH 416 AND LOTS 444 THROUGH 446, IN BLOCK 9 OF SECTION 1 OF PELL LAKE
SUBDIVISION, LOCATED IN THE TOWN OF BLOOMFIELD, WALWORTH COUNTY, WISCONSIN.

FOR: RADA

SCALE 1" = 30'

o = IRON PIPE SET.



⊘ = IRON PIPE FOUND.

I have surveyed the above-described property,
and the map hereon is a true representation
thereof and shows the size and location of the
property, its exterior boundaries, the location
and dimensions of all visible structures thereon,
fences, apparent easements and roadways and
visible encroachments, if any.

This survey is made for the exclusive use of
the present owners of the property, and also
those who purchase, mortgage, or guarantee
the title thereto, within one year from date
hereof,

Dated at Burlington, this 6th day,
of DECEMBER 19 96

John F. Degen
John F. Degen, Land Surveyor S 242
589 N. Pine St. Burlington, WI 53105

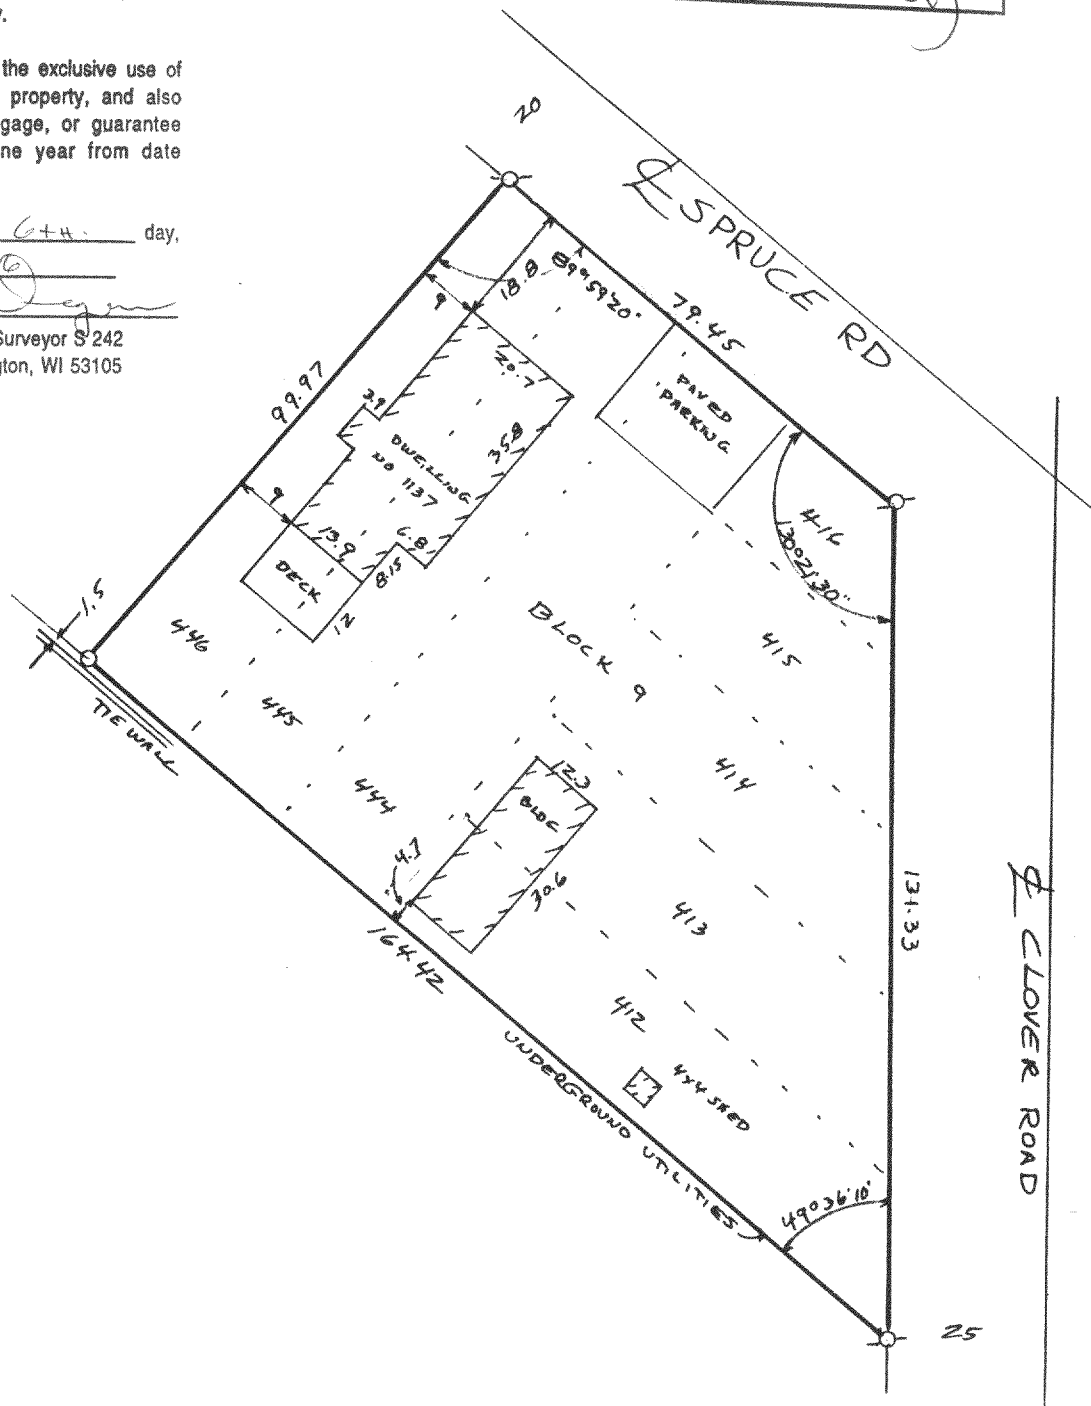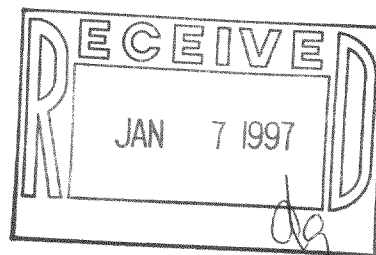

MPL-90
11.8-1585