

PLAT OF SURVEY

OF



LOTS 7 & 10 IN NIPPERSINK HIGHLANDS, A SUBDIVISION LOCATED IN THE NE 1/4 OF THE NE 1/4 AND IN THE NW 1/4 OF THE NE 1/4 IN SECTION 24, T. 1 N., R. 18 E. OF THE 4TH P.M., TOWNSHIP OF BLOOMFIELD, COUNTY OF WALWORTH, WISCONSIN.

FOR: KIELHACK

SCALE 1" = 40'

⊘ = IRON PIPE FOUND

✕ = POWER POLE

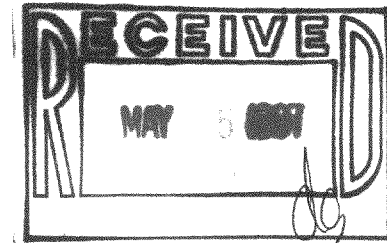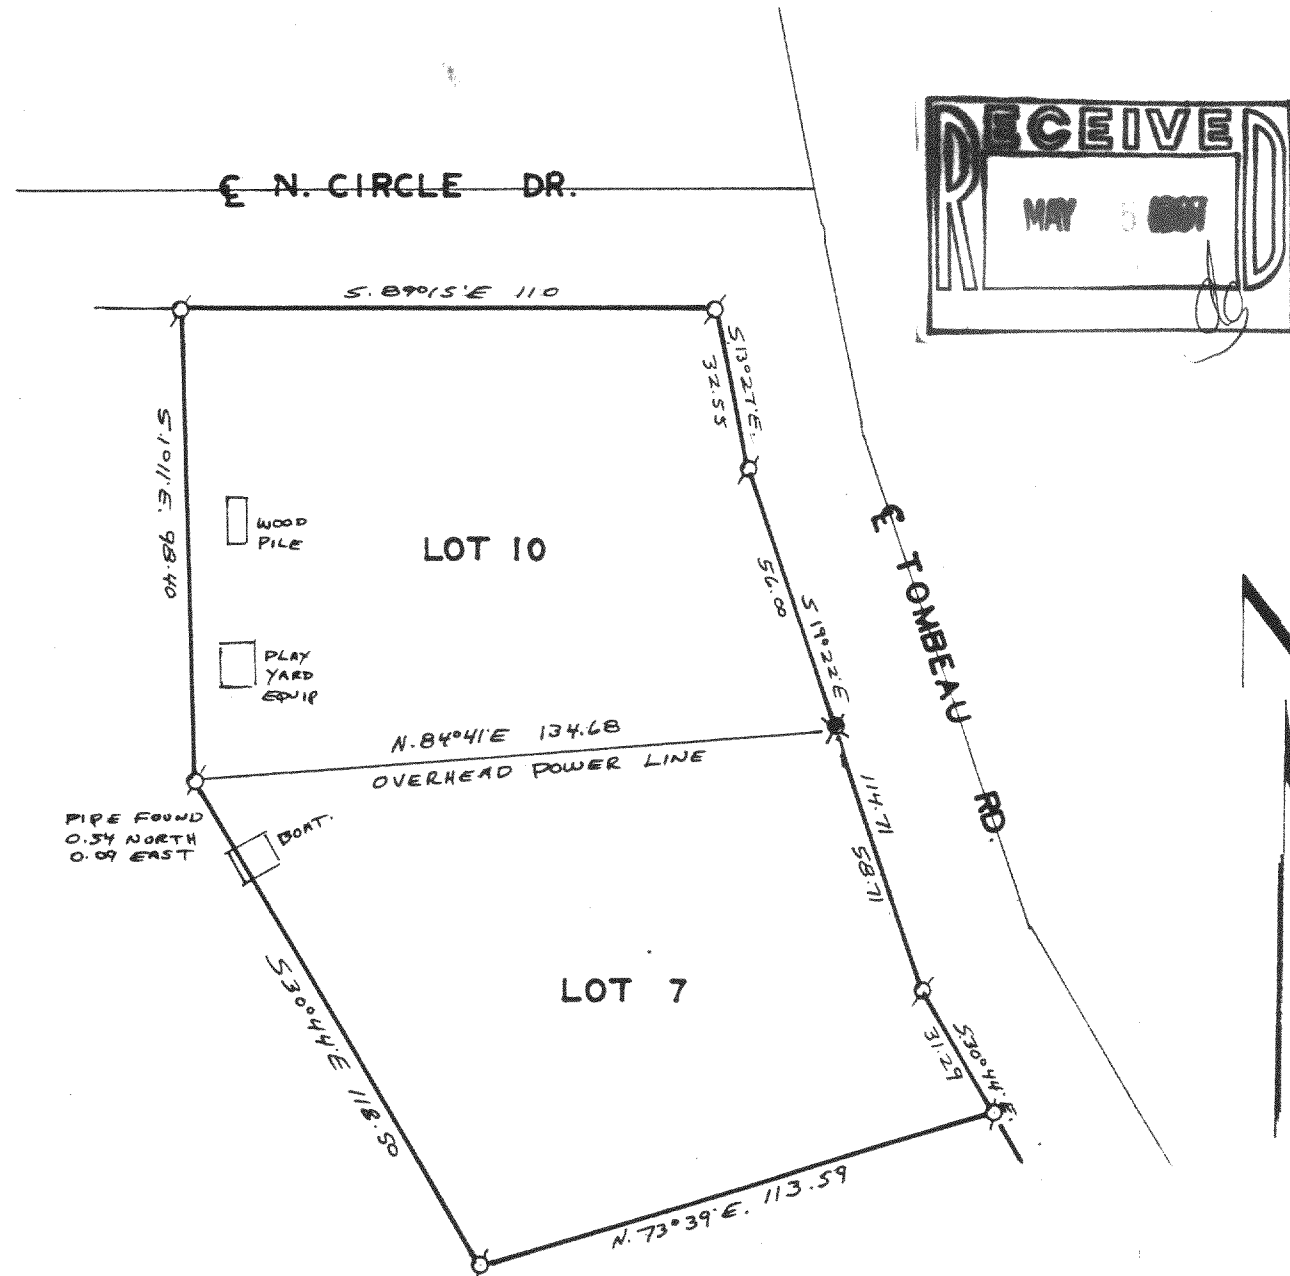

I have surveyed the above-described property, and the map hereon is a true representation thereof and shows the size and location of the property, its exterior boundaries, the location and dimensions of all visible structures thereon, fences, apparent easements and roadways and visible encroachments, if any.

This survey is made for the exclusive use of the present owners of the property, and also those who purchase, mortgage, or guarantee the title thereto, within one year from date hereof.

Dated at Burlington, this 2ND day,

of MAY 1997

John F. Degen
John F. Degen, Land Surveyor S 242
589 N. Pine St. Burlington, WI 53105

19-A-3 #25

MNH-7
MNH-10

118-1620