



HOME OFFICE
109 SOUTH SPRING STREET
BURLINGTON, WISCONSIN 53105
PHONE: 414-763-2652
414-763-7834

ROBERS & BOYD, INC.
CONSULTING ENGINEERS
LAND SURVEYORS

BRANCH OFFICE
809 - 43RD STREET
KENOSHA, WISCONSIN 53140
PHONE: 414-658-4488

PLAT OF SURVEY
For
CENTURY 21
of

Lot 1, and the West 1/2 of Lot 2, Block 3, Rose Nippersink Gardens
Subdivision, located in the Southeast 1/4 and the Southwest 1/4 of
the Southeast 1/4 of Section 24, Town 1 North, Range 13 East, of
the 4th P.M., Town of Bloomfield, County of Walworth, State of
Wisconsin.

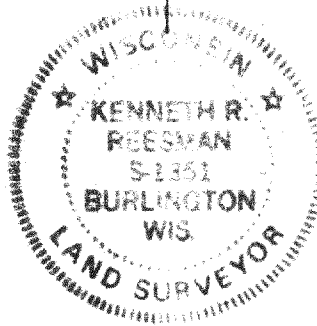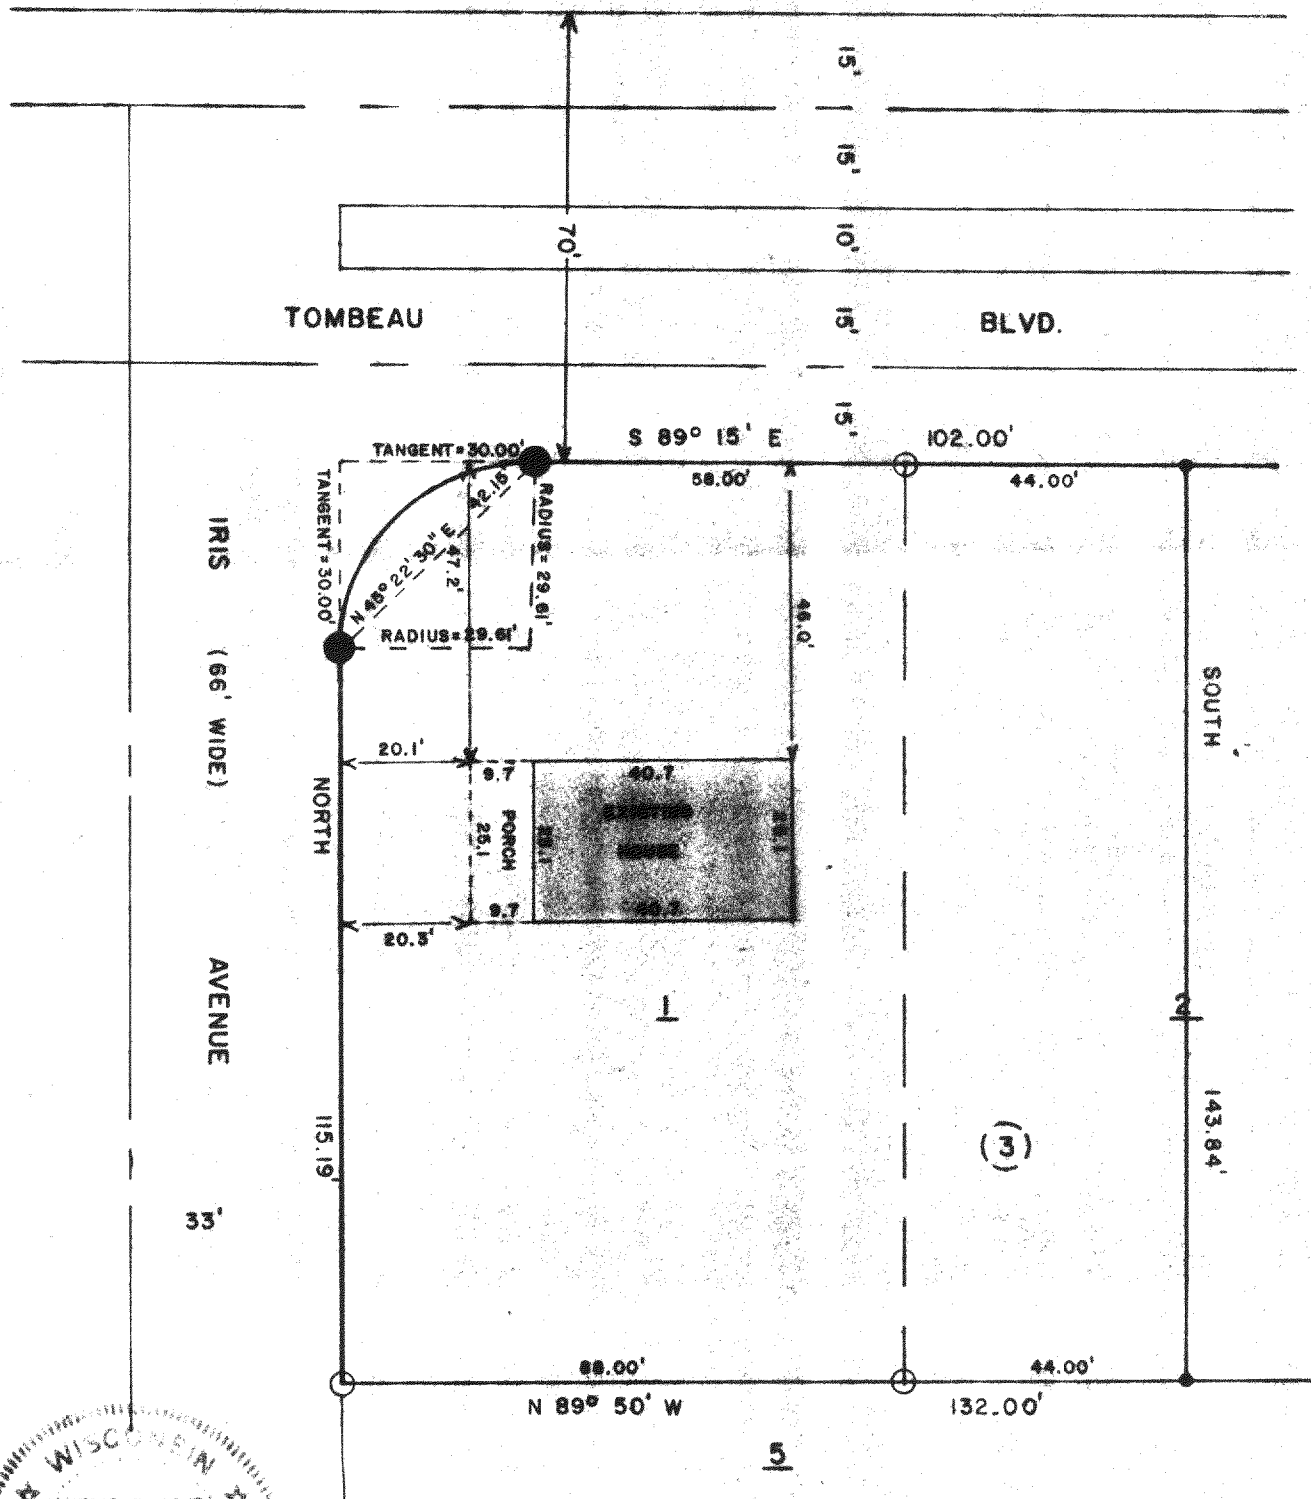

"I CERTIFY THAT I HAVE SURVEYED THE ABOVE DESCRIBED
PROPERTY AND THAT THE ABOVE PLAT IS AN ACCURATE
SURVEY AND A TRUE REPRESENTATION THEREOF AND COR-
RECTLY SHOWS THE EXTERIOR BOUNDARY LINES AND LOCA-
TION OF BUILDINGS ON SAID PROPERTY AND THE CORRECT
MEASUREMENTS THEREOF."

9-18-78
DATE

78223
JOB NUMBER GJA