

DEGEN, FOAT SURVEYING ASSOCIATES

100 SOUTH SECOND STREET

WATERFORD, WISCONSIN

763-6737


534-5404

000000
000000S1.DWG

PLAT OF SURVEY

LOTS 7956 THRU 7963, BLOCK 154, SECTION 5 OF PELL LAKE,
A SUBDIVISION LOCATED IN TOWN 1 NORTH, RANGE 18 EAST,
WALWORTH COUNTY, WISCONSIN.


SURVEYED FOR: MICKEY HORGAN
RE/MAX REALTY
101 BROAD STREET, SUITE 102
LAKE GENEVA, WI 53147

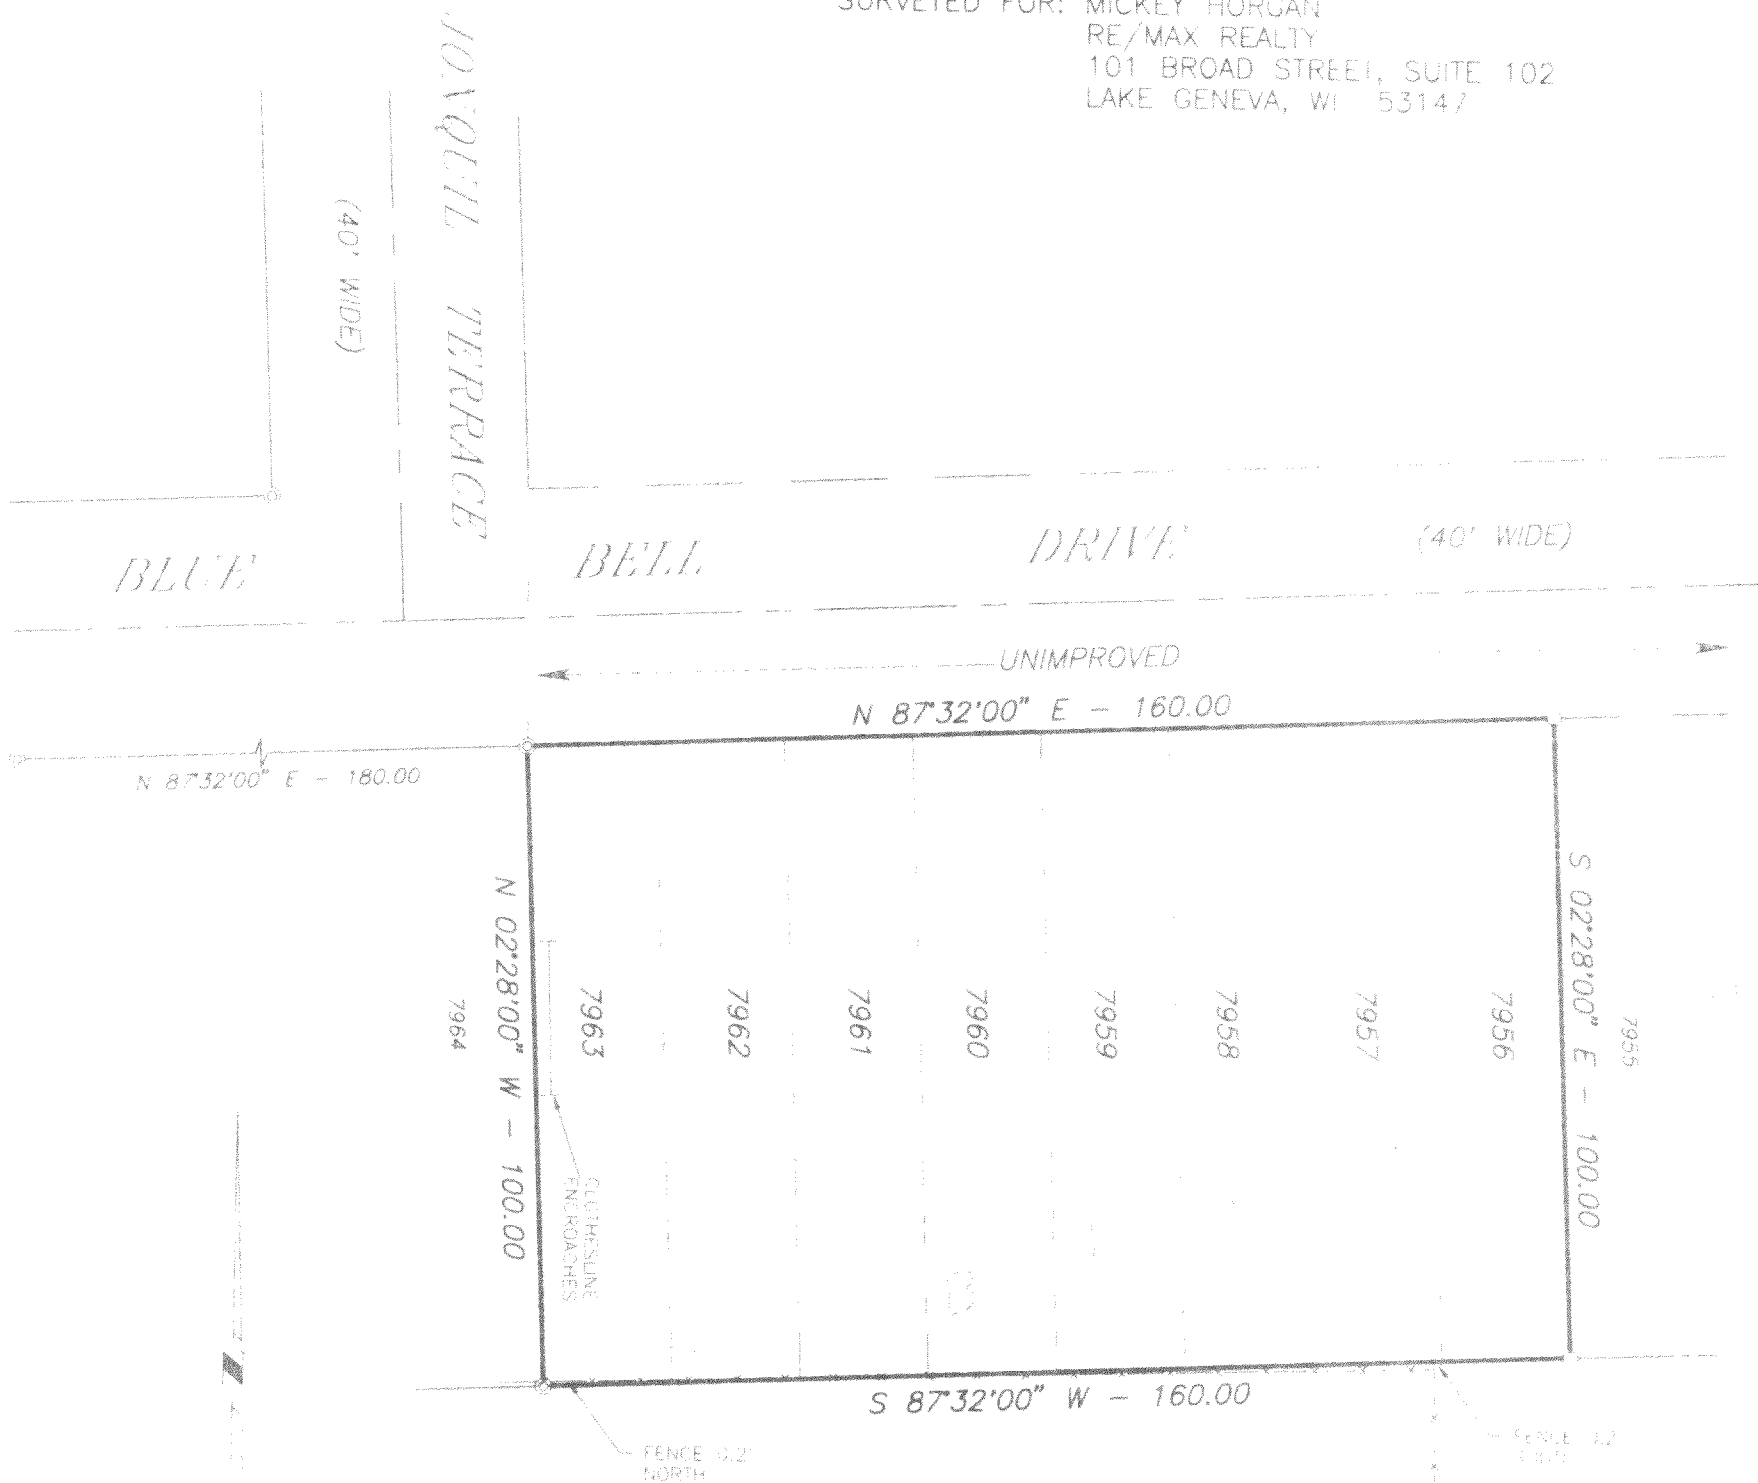

SCALE: 1" = 30'

LEGEND

- + - CROSS CUT IN CONCRETE
- o - PK NAIL
- ⊙ - FOUND 2" IRON PIPE
- - FOUND IRON PIPE
- - SET IRON PIPE
- - FENCE
- () - RECORDED AS

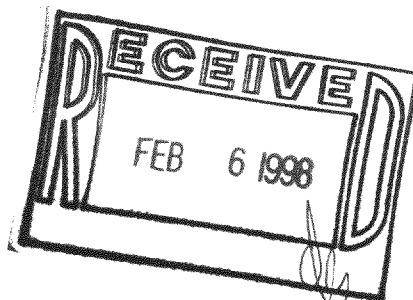

I HEREBY CERTIFY THAT I HAVE SURVEYED THE ABOVE DESCRIBED PROPERTY AND THE ABOVE MAP IS A TRUE REPRESENTATION THEREOF AND SHOWS THE SIZE AND LOCATION OF THE PROPERTY, THE LOCATION OF ALL VISIBLE STRUCTURES AND DIMENSIONS OF ALL PRINCIPAL BUILDINGS THEREON, BOUNDARY FENCES, APPARENT EASEMENTS, ROADWAY AND VISIBLE ENCROACHMENTS, IF ANY.

THIS SURVEY IS MADE FOR THE PRESENT OWNERS OF THE PROPERTY, AND ALSO THOSE WHO PURCHASE OR GUARANTEE THE TITLE THERETO WITHIN (1) YEAR FROM THE DATE HEREOF.

DATED AT WATERFORD THIS 19TH DAY OF NOVEMBER 1997

RECERTIFIED

Jay B. Foat

MP1-1614

118-1697

975093