


DEGEN, FOAT SURVEYING ASSOCIATES

100 SOUTH SECOND STREET
WATERFORD, WISCONSIN
(414)534-5404 (FAX)534-2022

975137
975137S1.DWG

PLAT OF SURVEY

LOTS 731 AND 732, BLOCK 12, PELL LAKE ADDITION, A SUBDIVISION
LOCATED IN THE SOUTHWEST 1/4 OF SECTION 14, TOWN 1 NORTH,
RANGE 18 EAST, OF THE FOURTH PRINCIPAL MERIDIAN, TOWN OF
BLOOMFIELD, WALWORTH COUNTY, WISCONSIN.

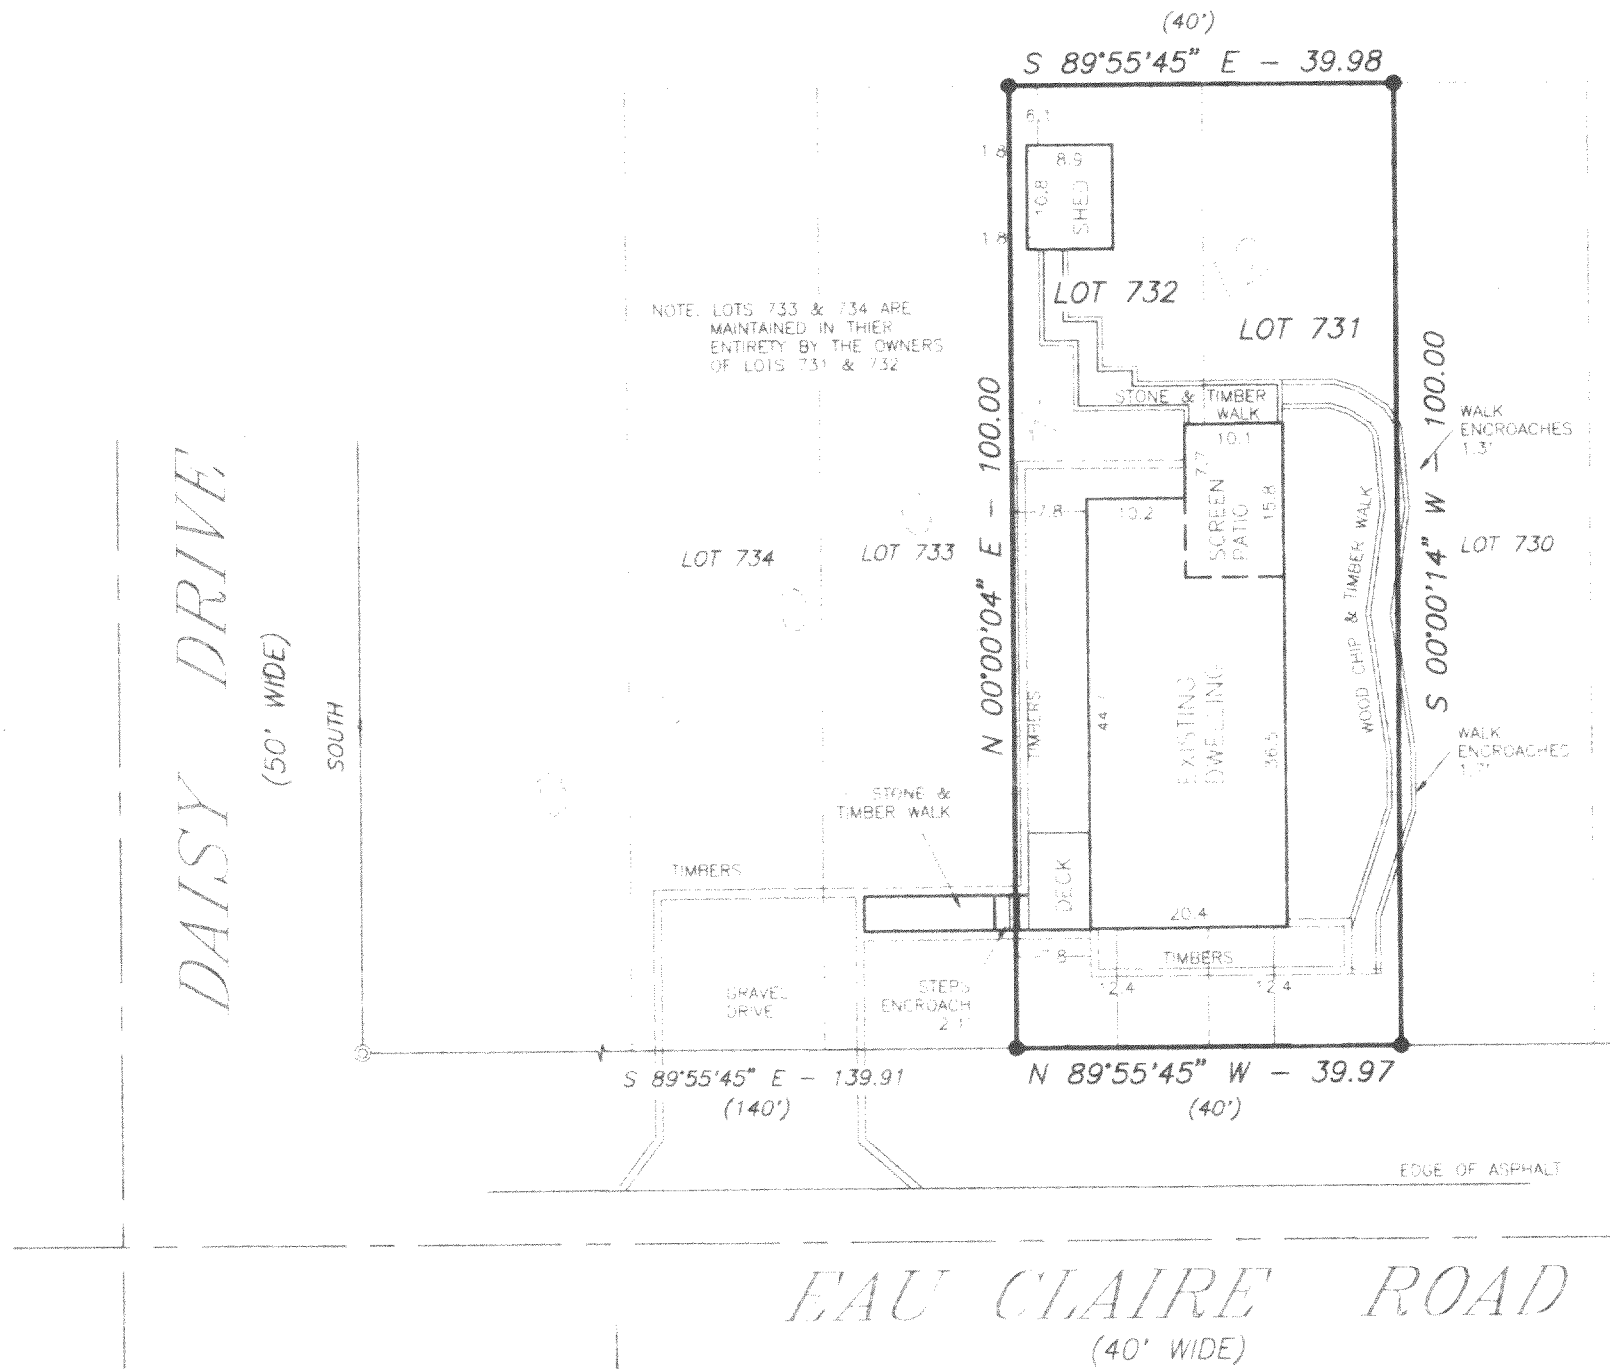


LEGEND

- + - CROSS CUT IN CONCRETE
- o - PK NAIL
- ⊙ - FOUND IRON PIPE
- - SET IRON ROD
- - SET IRON PIPE
- - FENCE
- () - RECORDED AS

SURVEYED FOR: GARY GROLLE
CENTURY 21 - ZENK REALTY
100 ELIZABETH LANE
GENOA CITY, WI 53128

SCALE: 1" = 20'

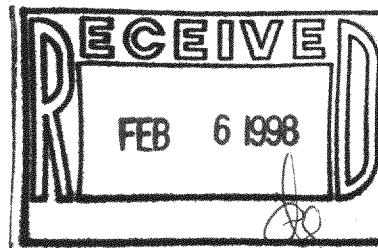

I HEREBY CERTIFY THAT I HAVE SURVEYED THE ABOVE DESCRIBED PROPERTY AND THE ABOVE MAP IS A TRUE REPRESENTATION THEREOF AND SHOWS THE SIZE AND LOCATION OF THE PROPERTY, THE LOCATION OF ALL VISIBLE STRUCTURES AND DIMENSIONS OF ALL PRINCIPAL BUILDINGS THEREON, BOUNDARY FENCES, APPARENT EASEMENTS, ROADWAY AND VISIBLE ENCROACHMENTS, IF ANY

THIS SURVEY IS MADE FOR THE PRESENT OWNERS OF THE PROPERTY, AND ALSO THOSE WHO PURCHASE, OR GUARANTEE THE TITLE THERETO WITHIN (1) YEAR FROM THE DATE HEREOF

DATED AT WATERFORD THIS 22ND DAY OF DECEMBER 1997

RECERTIFIED

James R. Deat

MPLA-150
118-1699