


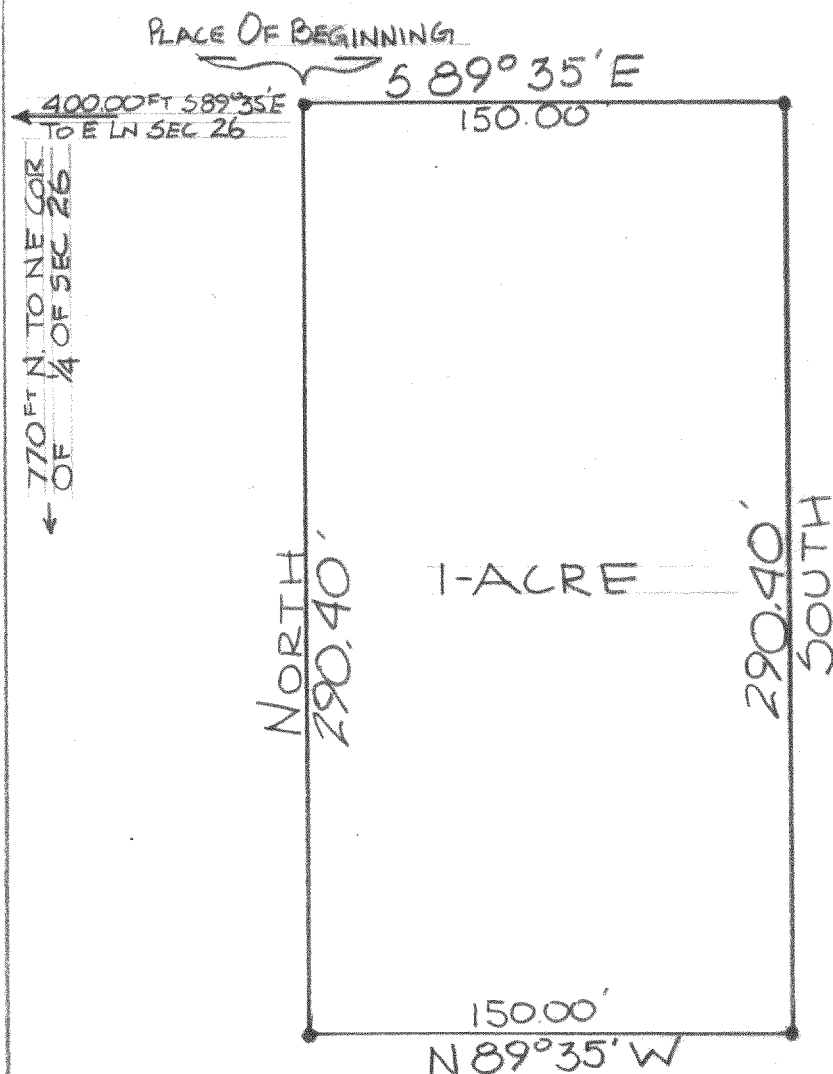


• - INDICATES IRON STAKE

DESCRIPTION:

Commencing at a point that is 770.00 feet South of and 400.00 feet, N. 89° 35' W., of the northeast corner of the S.E. 1/4 of Section 26, Town 1 north, Range 18 east, Walworth County, Wisconsin; thence North 290.40 feet, thence N. 89° 35' W., 150.00 feet, thence South 290.40 feet, thence S. 89° 35' E., 150.00 feet to the place of beginning.

CERTIFICATE:

I, James F. Biagi, do hereby certify that I have on this the 28th day of December, 1960 surveyed the above described property.
Signed and sealed on this the 1st day of January 1961.

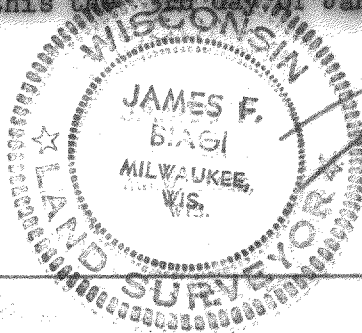

James F. Biagi RLS 272
Elkhorn, Wisconsin.