
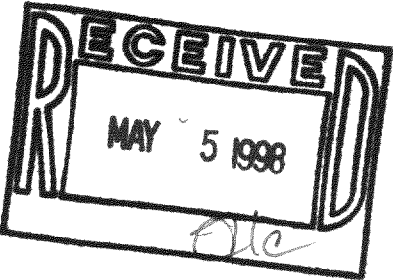


AMBIT LAND SURVEYING
P. O. Box 42
Bassett, WI. 53101

PHONE 414-537-4874
FAX 414-537-4221

PLAT OF SURVEY OF

Lots 25 through 30, both inclusive, Block 6 of ROSE NIPPERSINK GARDENS, being a subdivision located in the Southeast Quarter and the Southwest Quarter of the Southeast Quarter in Section 24, Township 1 North, Range 18 East of the 4th Principal Meridian, Township of Bloomfield, County of Walworth, State of Wisconsin.

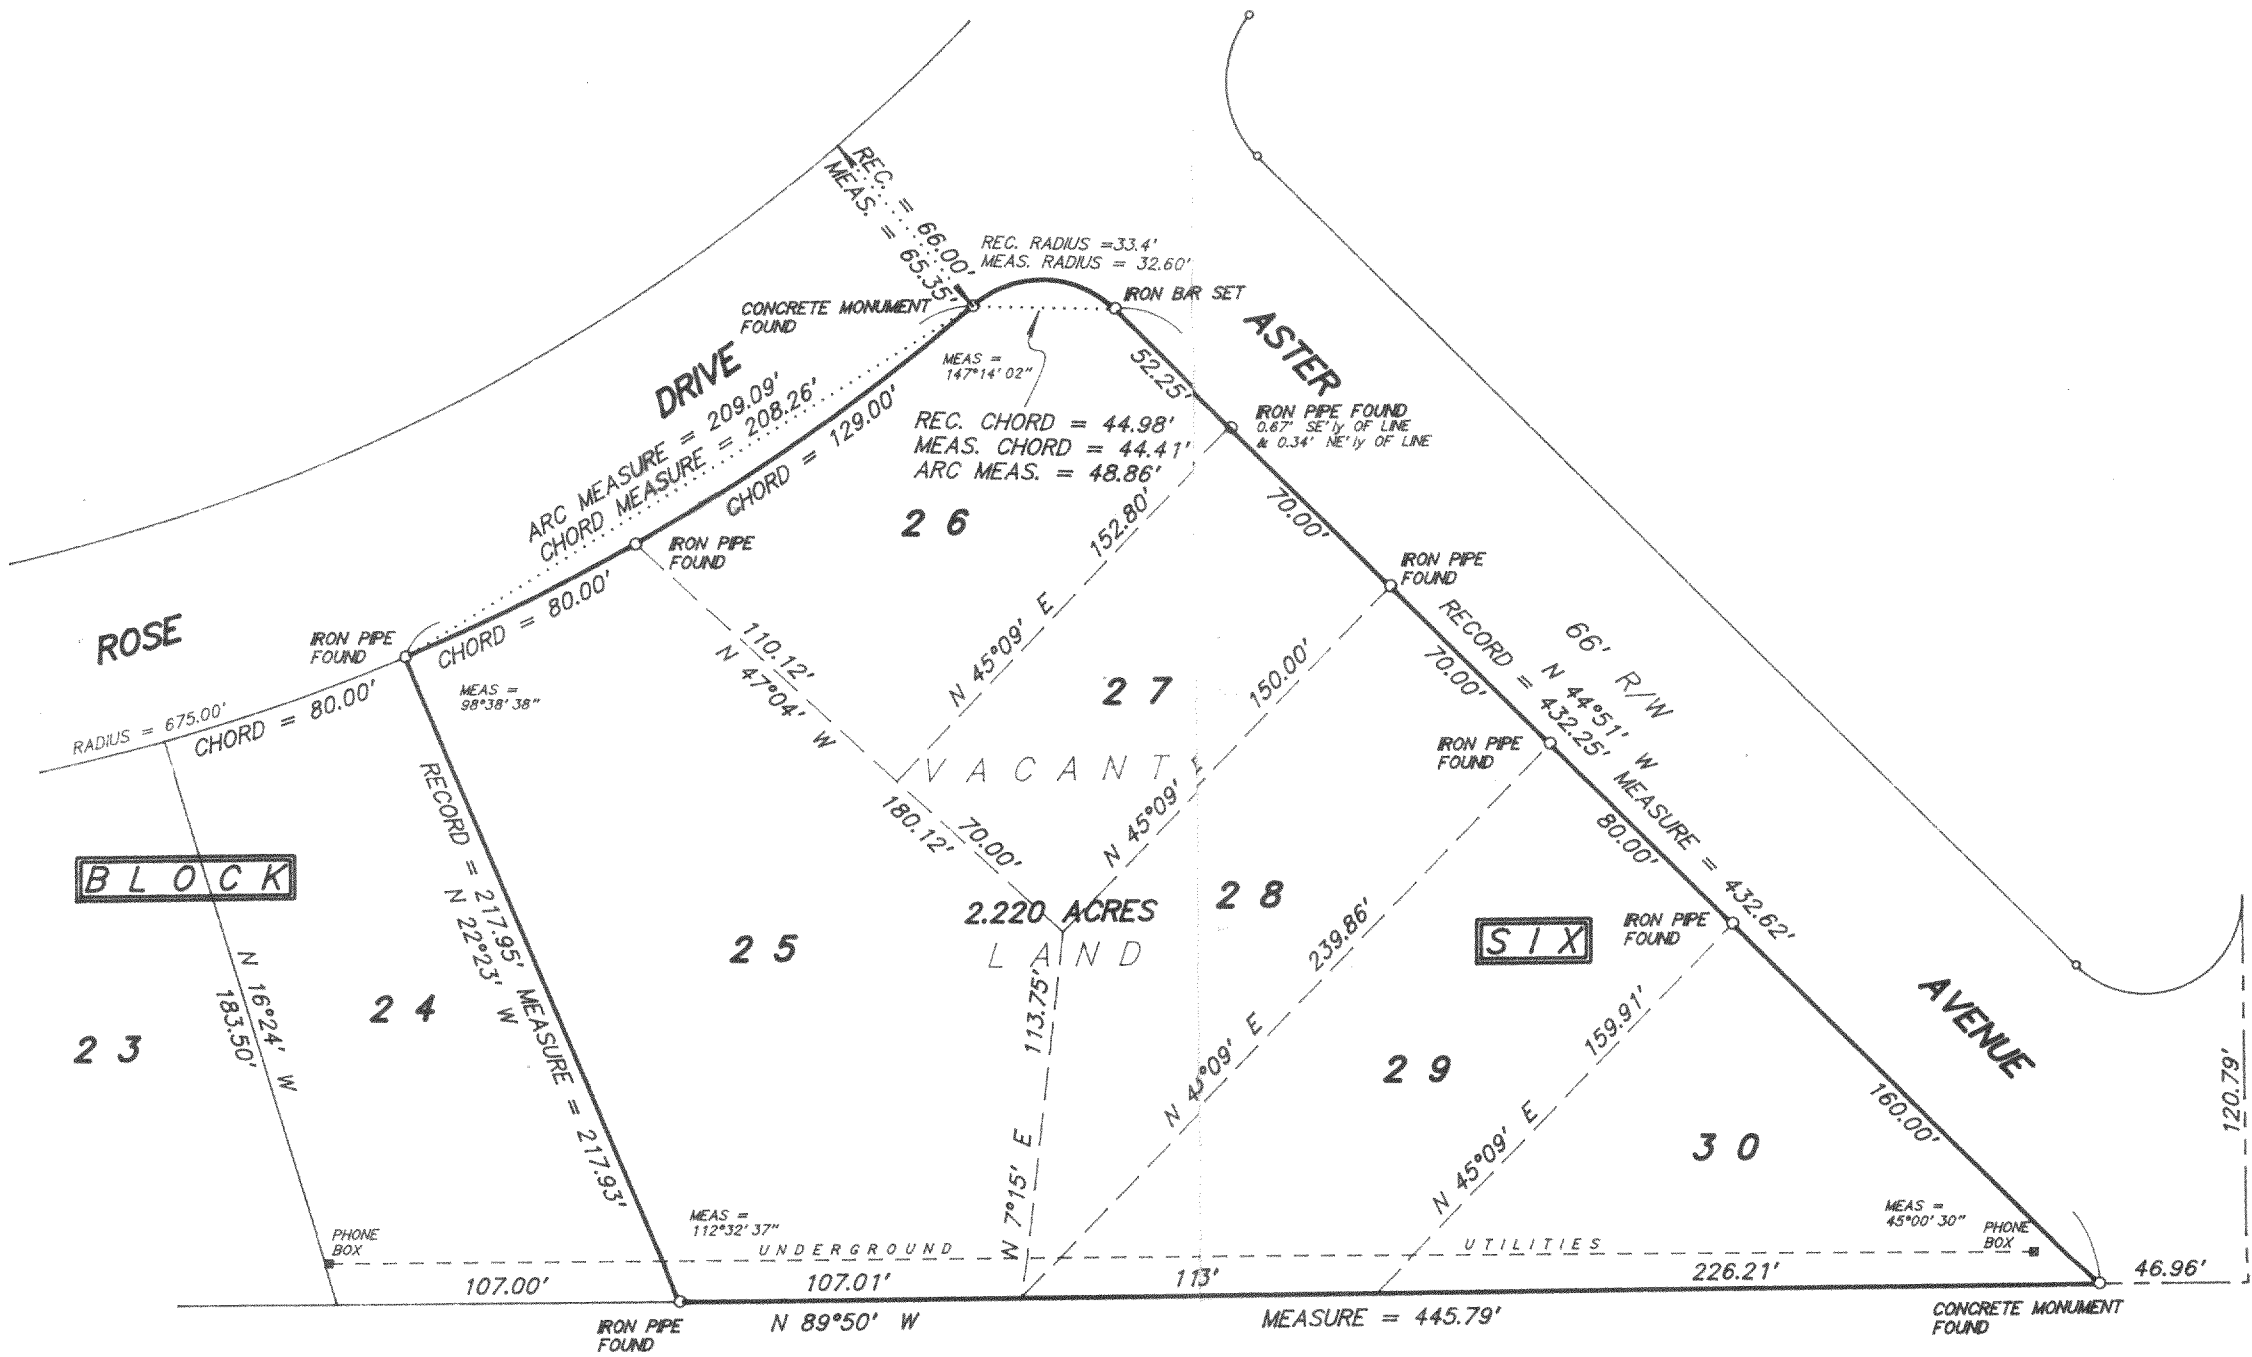

SCALE 1 inch = 60 feet
ORDERED BY R. Janci - Attorney at Law
JOB NO. 97470

NOTE: NOT ALL PHONE BOXES LOCATED DUE TO HEAVY BRUSH



I hereby certify that I have surveyed the above described property and the above plat is a true representation thereof and shows the size and location of the property, its exterior boundaries, the location and dimensions of all visible structures thereon, boundary fences, apparent easements and roadways and visible encroachments, if any.

This survey is made for the exclusive use of the present owners of the property, and also those who purchase, mortgage, or guarantee the title thereto within one year from the date hereof.

Dated at Bassett, Wisconsin this 17th day of DECEMBER 1997.

Mark A. Bolender
Mark A. Bolender
Wisconsin Registered Land Surveyor S - 1784

MRNG-70

118-1712