

FARRIS, HANSEN & ASSOCIATES, INC.

ENGINEERING, ARCHITECTURE, SURVEYING

7 RIDGEWAY COURT - P.O. BOX 437, ELKHORN, WISCONSIN, 53121

PHONE: (414) 723-2098 FAX: (414) 723-5886



PLAT OF SURVEY

LOT 15

GRA DEN WOODS

LOCATED IN THE N 1/2 OF THE SE 1/4 SEC. 26
TOWN 1 NORTH, RANGE 18 EAST
WALWORTH COUNTY, WISCONSIN

TWIN LAKES ROAD 66' WIDE

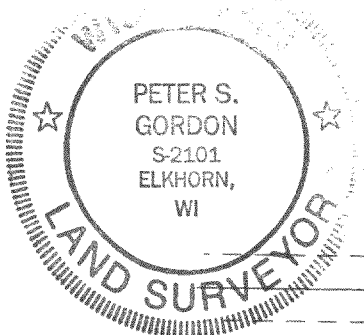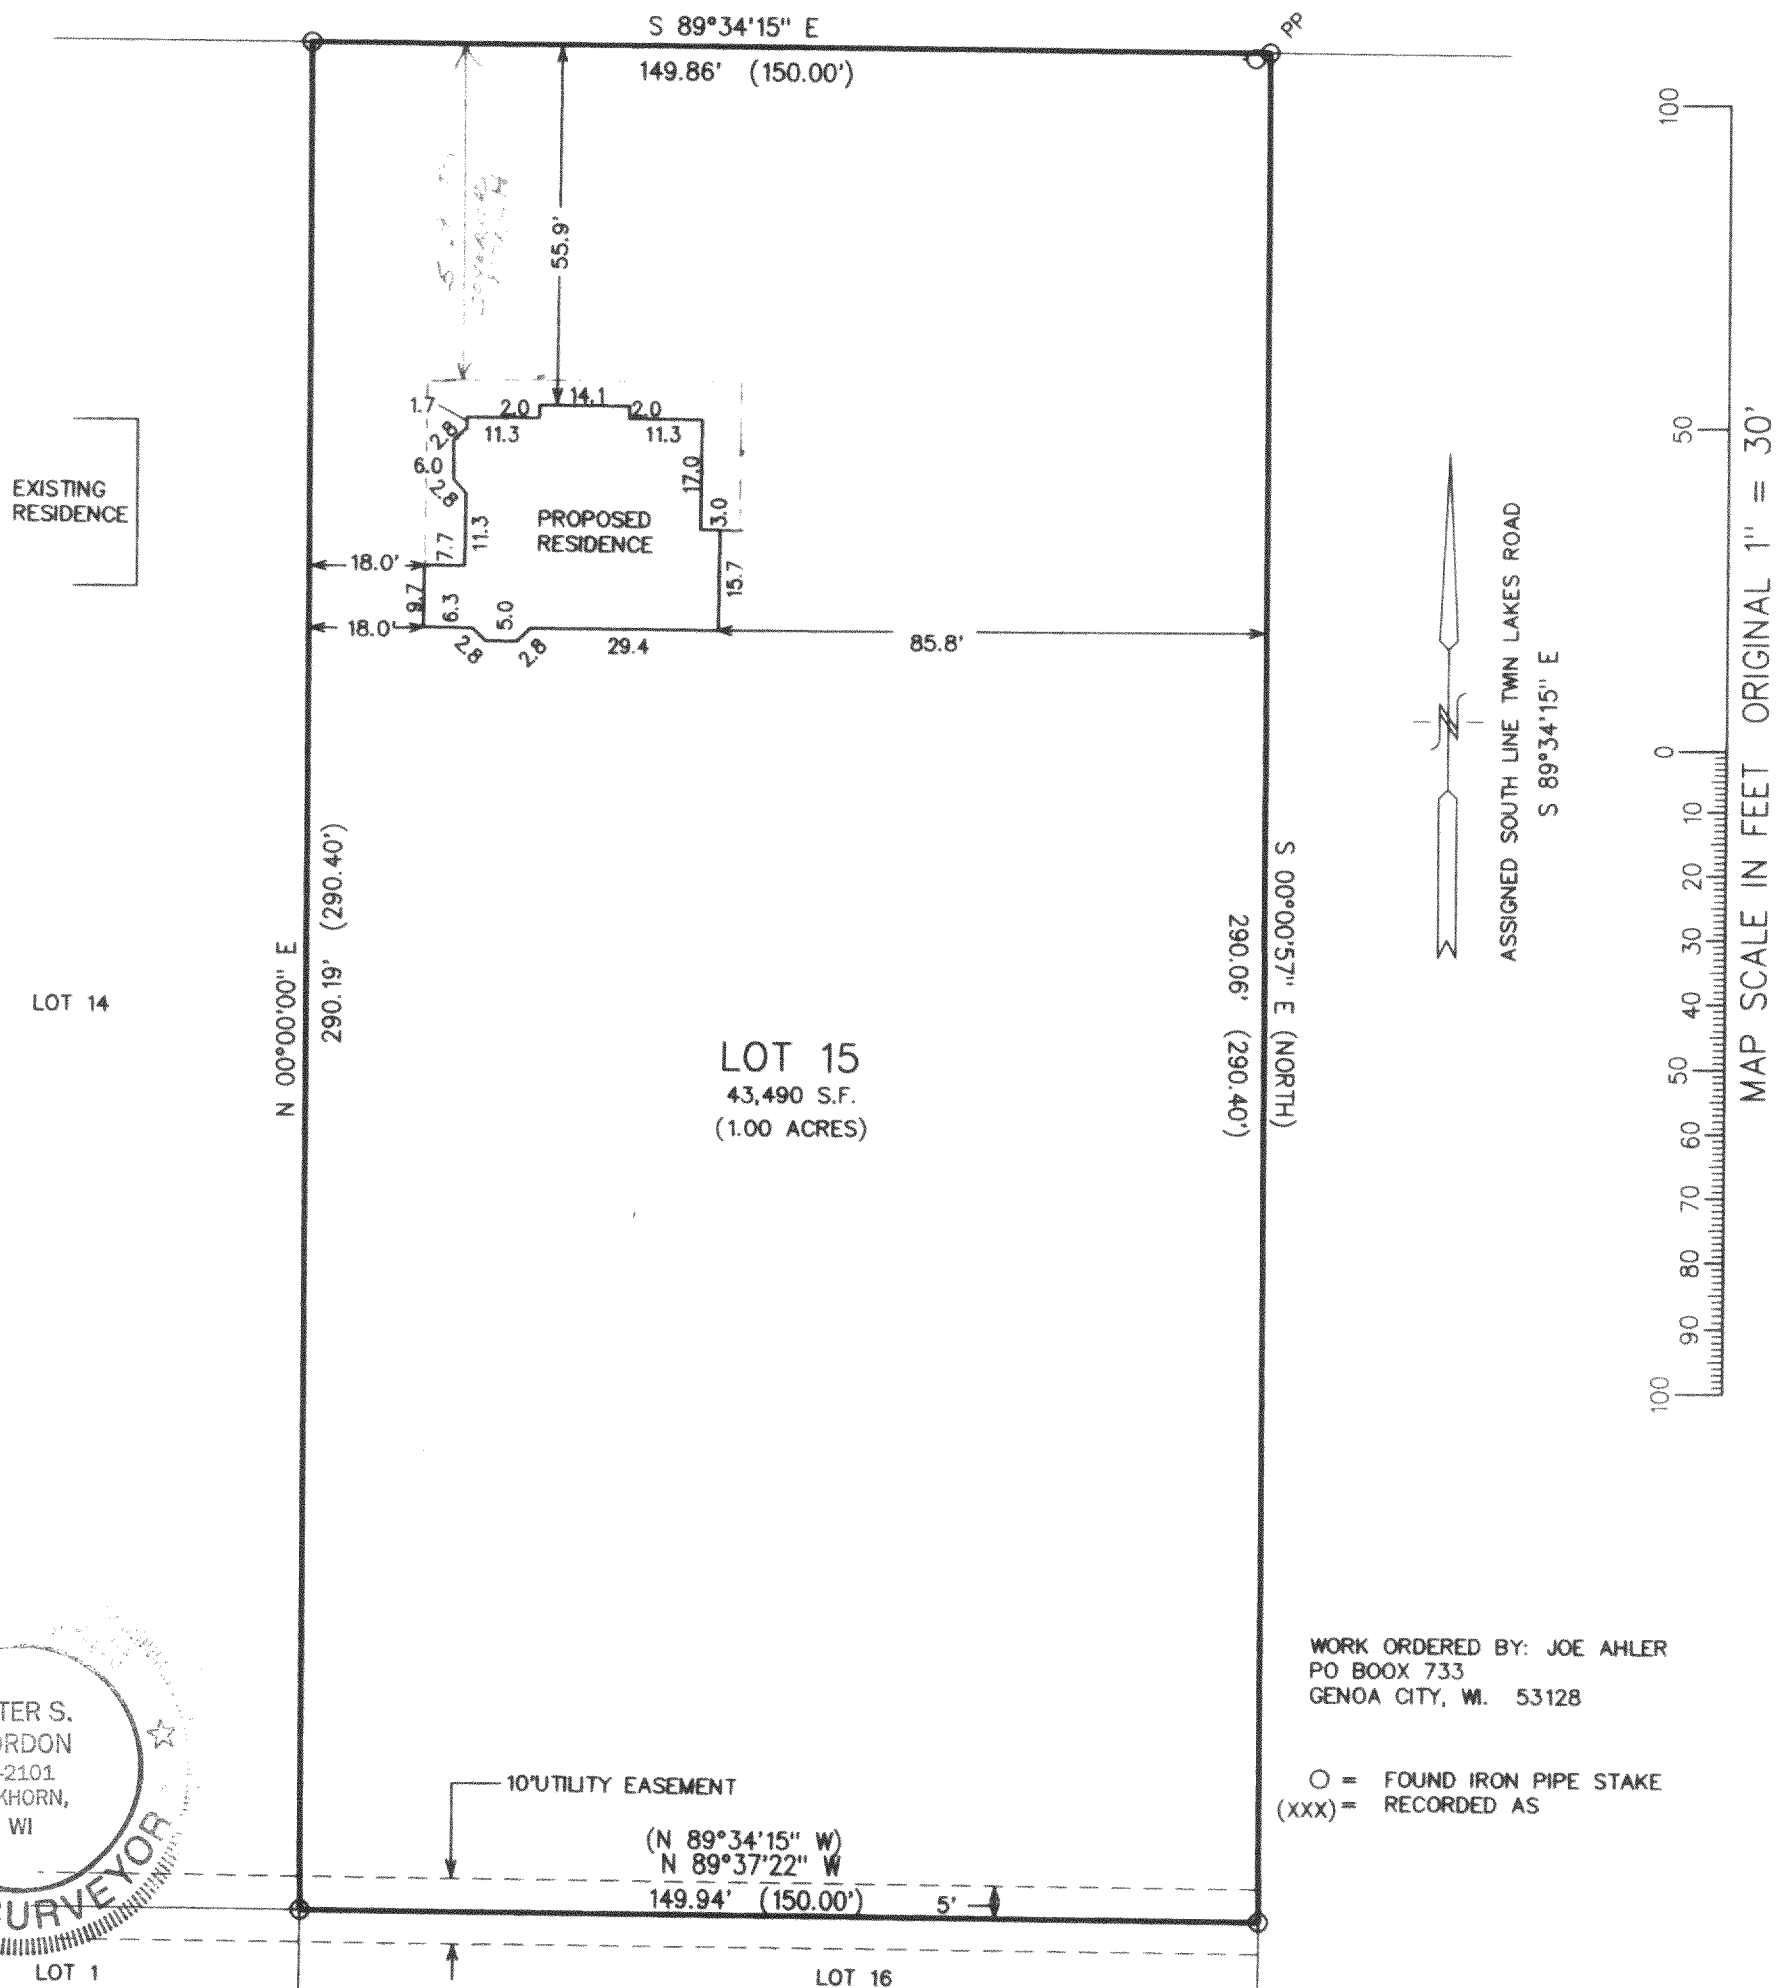

WORK ORDERED BY: JOE AHLER
PO BOX 733
GENOA CITY, WI. 53128

○ = FOUND IRON PIPE STAKE
(xxx) = RECORDED AS

NOTE: COPIES OF THIS MAP TO WHICH THE FOLLOWING CERTIFICATE WILL APPLY ARE BLUE LINE PRINTS SHOWING SURVEYOR'S ORIGINAL SEAL AND SIGNATURE IN BLACK INK. COPIES BY ANY OTHER MEANS MAY HAVE ALTERATIONS WHICH DO NOT REPRESENT THE SURVEYOR'S WORK PRODUCT.

I HEREBY CERTIFY THAT THE ABOVE DESCRIBED PROPERTY HAS BEEN SURVEYED UNDER MY DIRECTION AND THAT THE ABOVE MAP IS A TRUE REPRESENTATION THEREOF AND SHOWS THE SIZE AND LOCATION OF THE PROPERTY AND ITS EXTERIOR BOUNDARIES. THIS SURVEY IS MADE FOR THE USE OF THE PRESENT OWNERS OF THE PROPERTY, AND ALSO THOSE WHO PURCHASE, MORTGAGE, OR GUARANTEE THE TITLE THERETO WITHIN ONE YEAR FROM THE DATE HEREOF.


DATED: 3-12-98

REVISED LOCATION OF PROPOSED RESIDENCE - 3/17/98

PETER S. GORDON R.L.S. 2101

PROJECT 4947

SHEET 1 OF 1

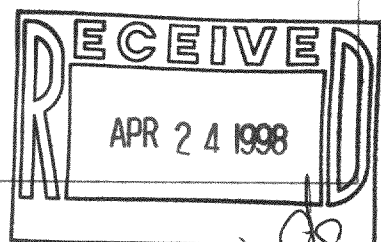

MCDW-15
118-1713