



PATHFINDER SURVEYING
FORMERLY KOLB LAND CONSULTING
929 WILLIAMS STREET LAKE GENEVA, WI. 53147
(414) 248-3697

DATE: 5/7/1998


LOTS 4724-4730 INCLUSIVE , BLOCK 91, SECTION 3 PELL LAKE SUBDIVISION , T1N ,R18E. WALWORTH COUNTY , WISCONSIN.

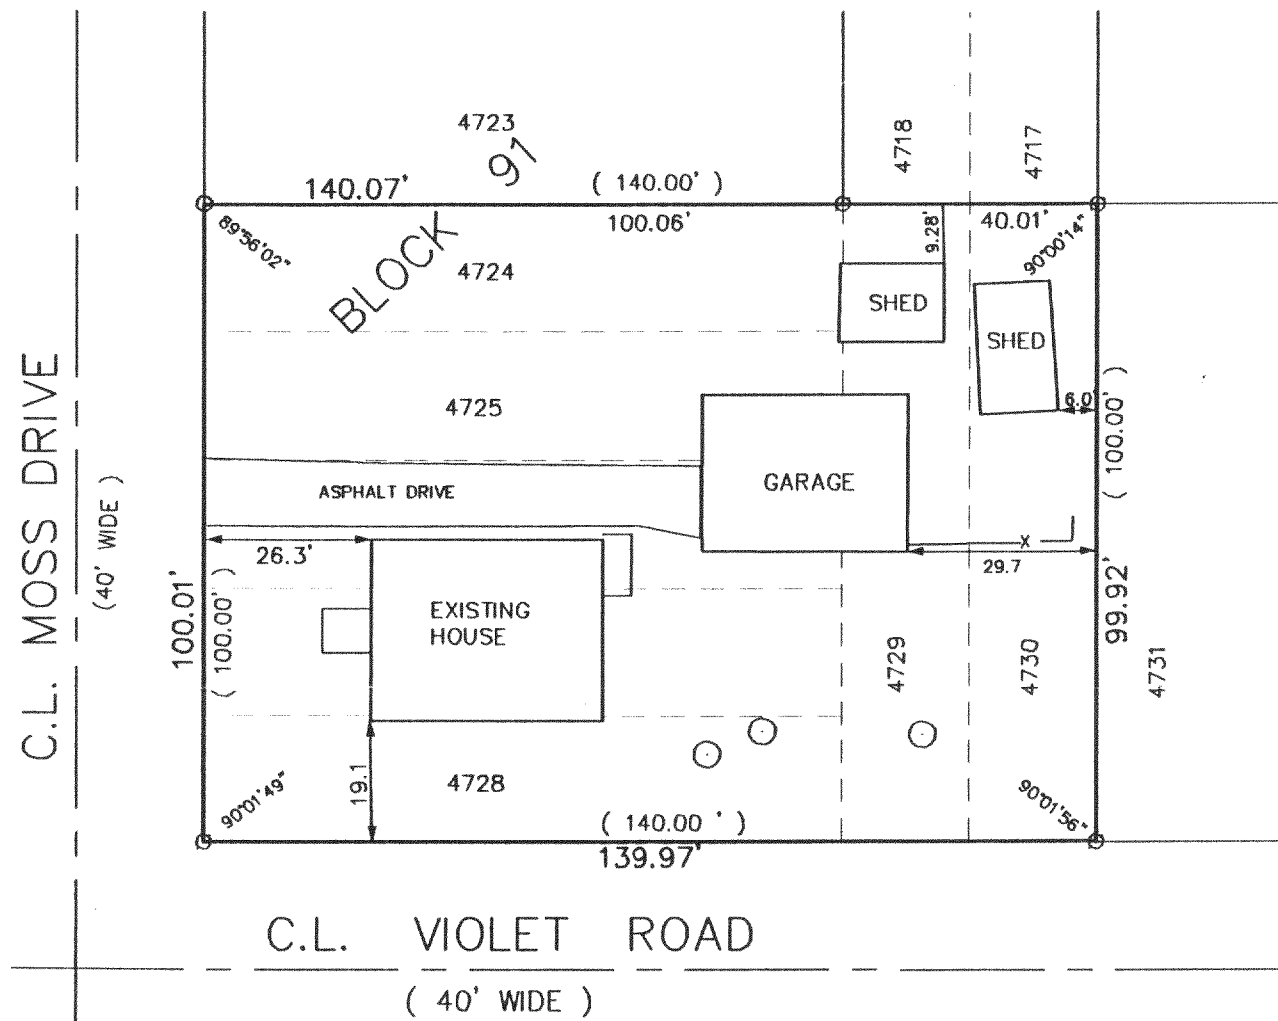

□ IRON PIPE FOUND
 ○ SEPTIC MANHOLE
 (XXXX) RECORDED AS
 — x — FENCE

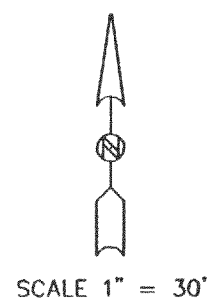

RECEIVED
MAY 26 1998

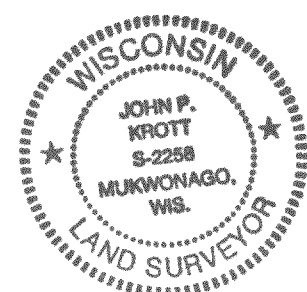

NOTE: THIS IS NOT A CERTIFIED COPY
UNLESS SEAL IS IN RED.

JOB NUMBER: 98069 1-18-MPI-1007

MP-1007
118-1717