

PLAT OF SURVEY

PATHFINDER SURVEYING
FORMERLY KOLB LAND CONSULTING
929 WILLIAMS STREET LAKE GENEVA, WI. 53147
(414) 248-3697



ORDERED BY:
CENTURY 21 LARRY HODGES REALTY
P.O. BOX 939
TWIN LAKES, WI. 53181

DATE: 4-22-1998

DESCRIPTION:

LOTS 5931-5941 INCLUSIVE, BLOCK 133, SECTION 4 OF PELL LAKE SUBDIVISION, T1N, R18E, WALWORTH COUNTY, WISCONSIN.

AREA OF LOTS 5931-5935 = 10,001 SQ.FT.

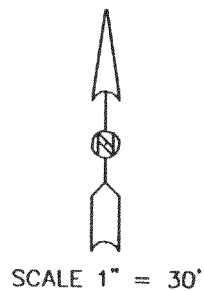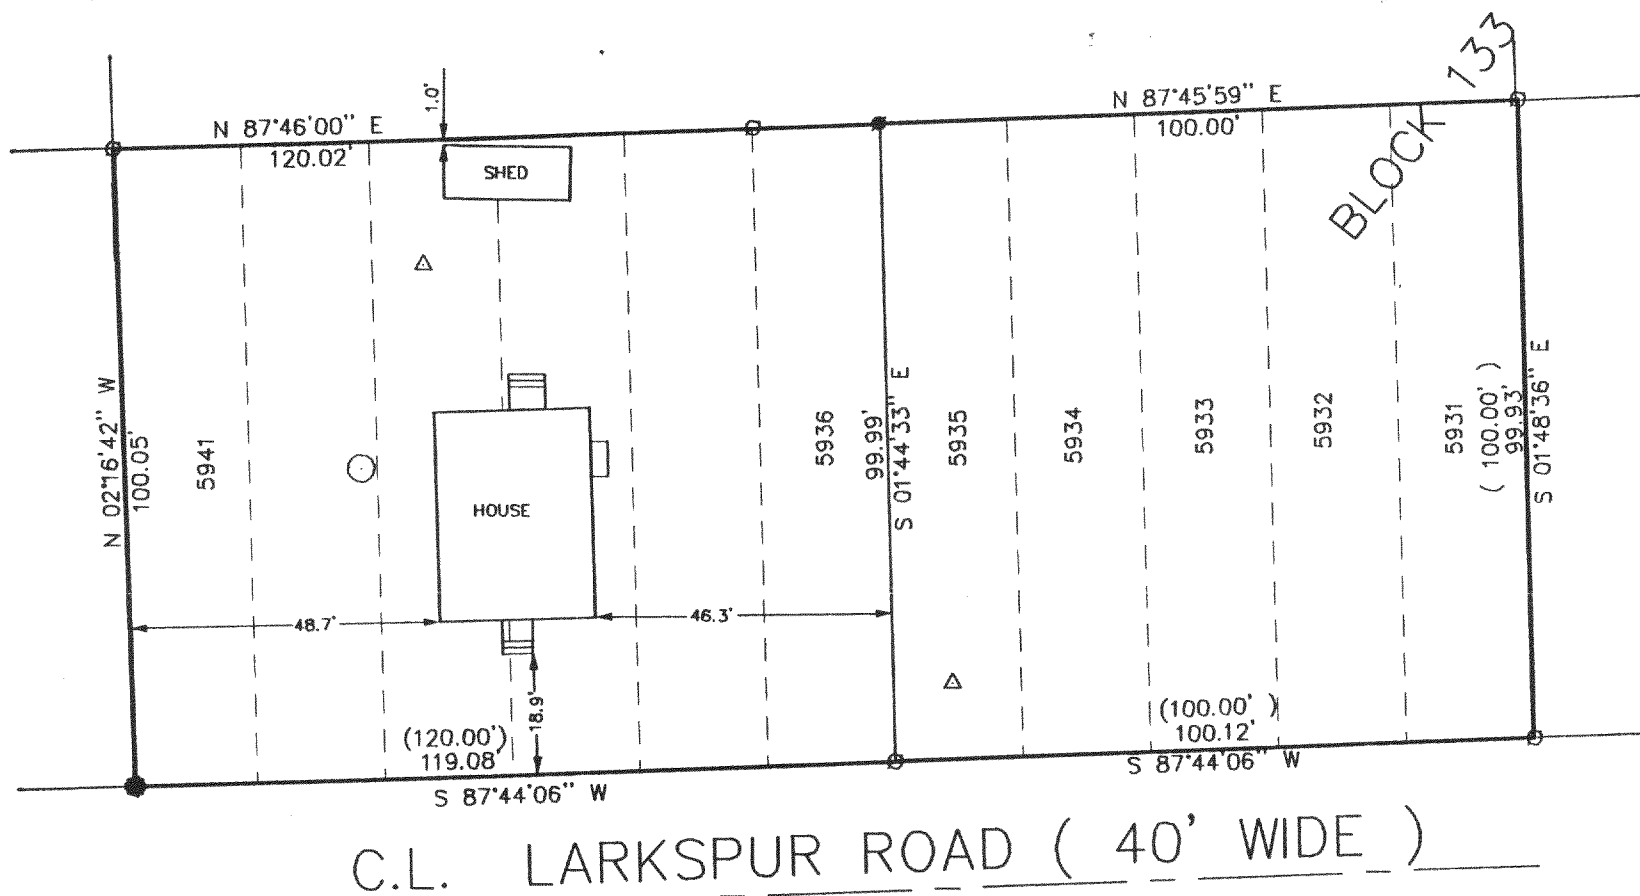



- LEGEND**
- FOUND IRON ROD
 - FOUND IRON PIPE
 - SET 1 IN. DIA. IRON PIPE
 - SEPTIC TANK MANHOLE
 - (XXXX) RECORDED AS

BEARINGS ARE REFERENCED TO THE RECORD PLAT OF PELL LAKE SUBDIVISION

THE ABOVE MAP IS A TRUE REPRESENTATION THEREOF AND SHOWS THE SIZE AND LOCATION OF ALL THE PROPERTY, EXTERIOR BOUNDARIES, THE LOCATION OF ALL VISIBLE BOUNDARY FENCES, APPARENT EASEMENTS, ROADWAYS AND VISIBLE ENCROACHMENTS, IF ANY

THIS SURVEY IS MADE FOR THE USE OF THE PRESENT OWNERS OF THE PROPERTY, AND ALSO THOSE WHO PURCHASE, MORTGAGE OR GUARANTEE TITLE THERETO WITHIN ONE (1) YEAR FROM DATE HERETO.

JOHN P. KROTT, R.L.S. 2258

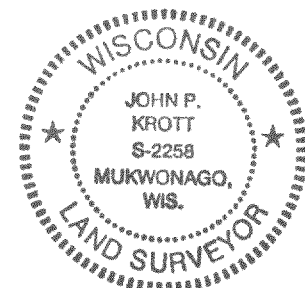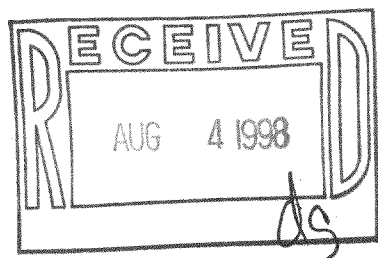

NOTE: THIS IS NOT A CERTIFIED COPY
UNLESS SEAL IS IN RED.
JOB NUMBER: 98060 1-18-MPL-1288 & 1289

118-1735

MPL-1288
MPL-1289

MPL-1290 (10x5.941)