

PLAT OF SURVEY


PATHFINDER SURVEYING
FORMERLY KOLB LAND CONSULTING
929 WILLIAMS STREET LAKE GENEVA, WI. 53147
(414) 248-3697

ORDERED BY: WALTER FITSCHEN
1397 BERNICE RD.
PELL LAKE

DATE: 1/26/1999

DESCRIPTION: LOTS 419-425 AND 474-476
BLOCK 18 PELL LAKE HIGHLANDS,
LOCATED IN SECTION 16, T1N,
R18E WALWORTH COUNTY, WISCONSIN.

C.L. HONEYSUCKLE ROAD (40' WIDE)

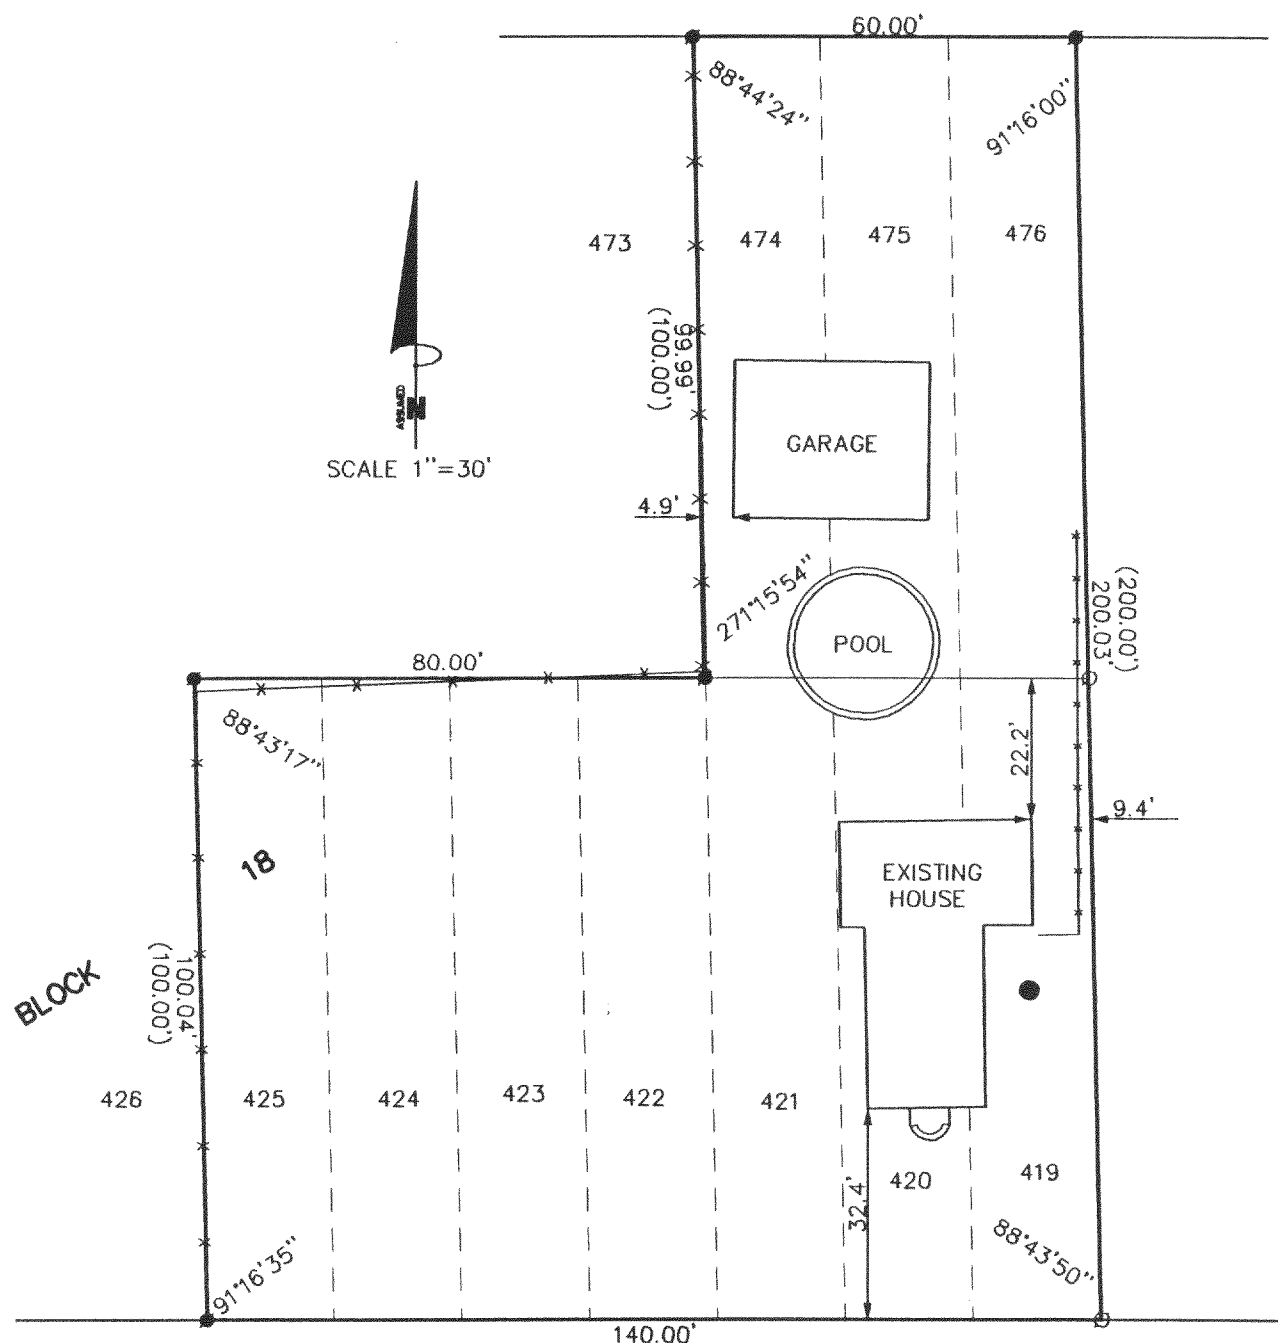

C.L. BERENICE ROAD (40' WIDE)



LEGEND

- FOUND IRON PIPE
- SET IRON PIPE
- (XXX) RECORDED AS
- X— FENCE
- WELL

THE ABOVE MAP IS A TRUE REPRESENTATION THEREOF AND SHOWS THE SIZE AND LOCATION OF ALL THE PROPERTY, EXTERIOR BOUNDARIES, THE LOCATION OF ALL VISIBLE BOUNDARY FENCES, APPARENT EASEMENTS, ROADWAYS AND VISIBLE ENCROACHMENTS, IF ANY

THIS SURVEY IS MADE FOR THE USE OF THE PRESENT OWNERS OF THE PROPERTY, AND ALSO THOSE WHO PURCHASE, MORTGAGE OR GUARANTEE TITLE THERETO WITHIN ONE (1) YEAR FROM DATE HERETO.

John P. Krott
JOHN P. KROTT, R.L.S. 2258

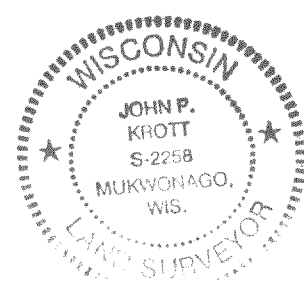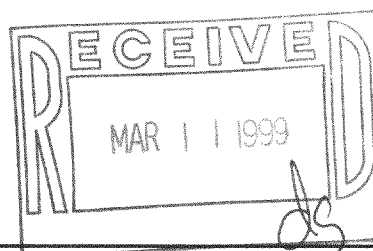

NOTE: THIS IS NOT A CERTIFIED COPY
UNLESS SEAL IS IN RED.
JOB NUMBER #99014 MPLH 00093

MPLH-93

118-1793