


HAROLD H. KOLB

REGISTERED PROFESSIONAL LAND SURVEYOR
LAKE GENEVA, WISCONSIN

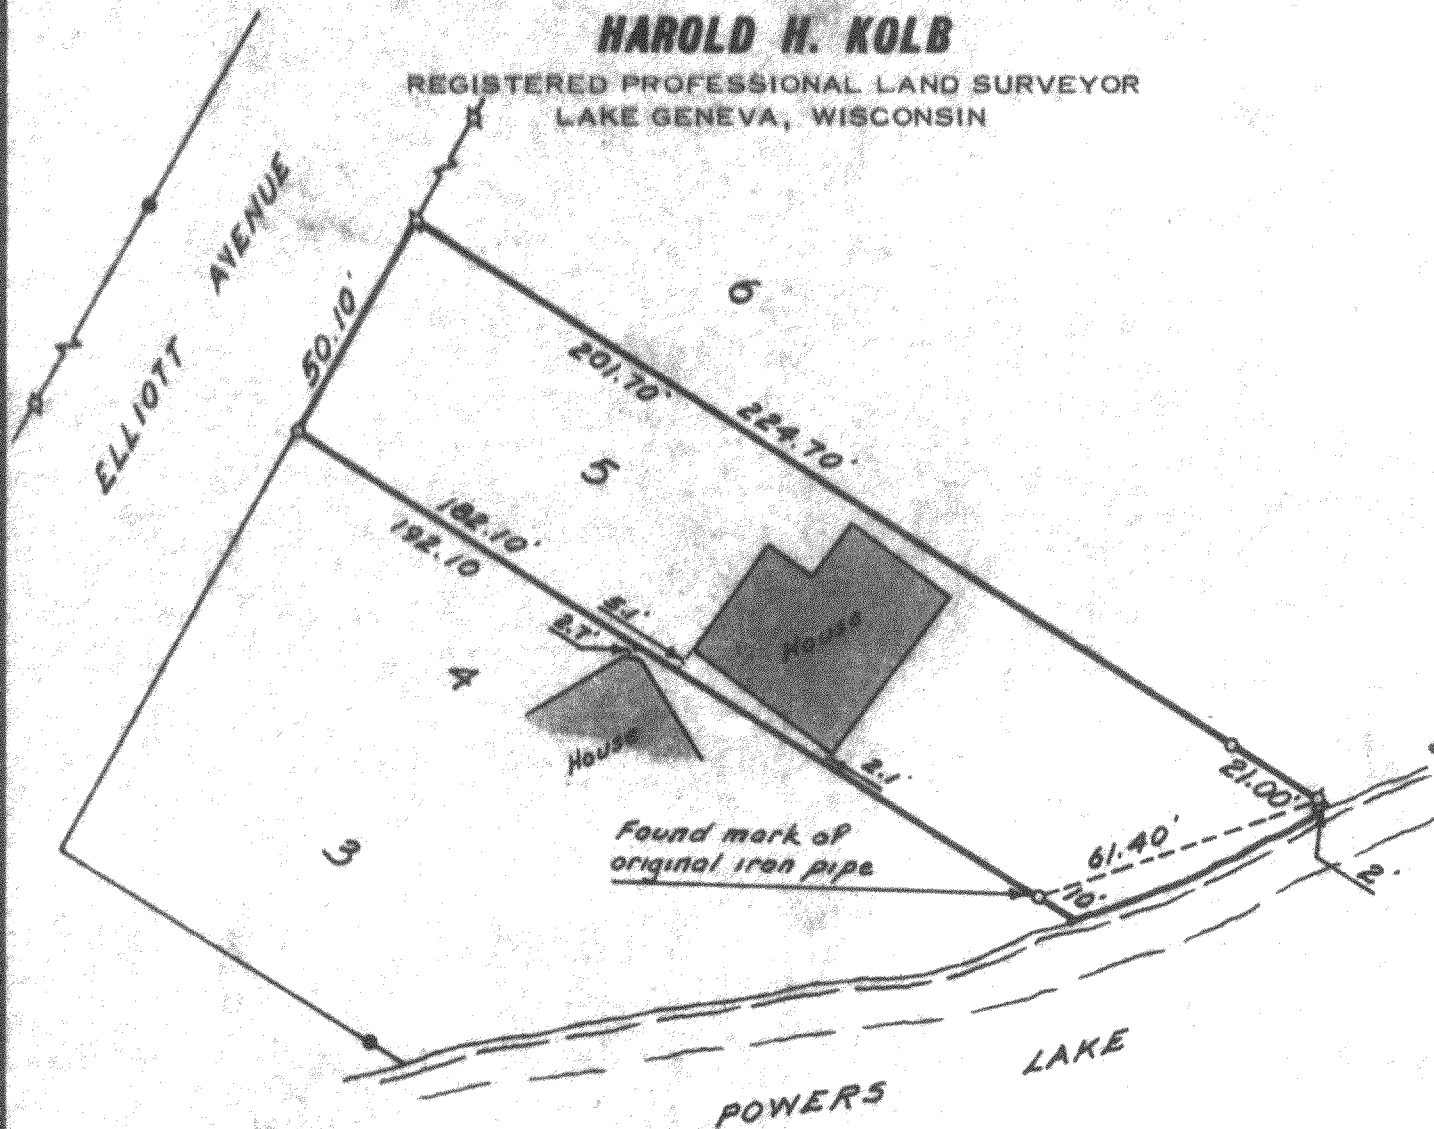

SCALE: 1" = 40'

LEGEND

- Ø - IRON PIPE FOUND
 ⊙ - IRON PIPE PLACED
 ● - CONCRETE MONUMENT *FOUND*
 X - SPIKE

PLAT OF SURVEY OF

Lot 5, William Elliott's Powers Lake
Subdivision, located in Section 13,
T 1 N, R 18 E, Walworth County,
Wisconsin.

I, HAROLD H. KOLB, DO HEREBY CERTIFY THAT I HAVE SURVEYED THE PROPERTY HEREON DESCRIBED ACCORDING TO THE OFFICIAL RECORDS, AND THAT THE PLAT HEREON IS A CORRECT REPRESENTATION OF THE LOT LINES.

Harold H. Kolb

HAROLD H. KOLB

WISCONSIN REGISTERED LAND SURVEYOR, S-187

DATE March 26, 1966

REVISED: March 29, 1966

MS-5

118-183

~~118-102~~