


**PLAT OF SURVEY**  
LOTS 5489 THRU 5496, BLOCK 100 OF  
SECTION 3 PELL LAKE SUBDIVISION  
LOCATED IN SECTION 15, TOWN 1 NORTH, RANGE 18 EAST  
TOWN OF BLOOMFIELD, WALWORTH COUNTY, WISCONSIN



FARRIS, HANSEN & ASSOC. INC.  
ENGINEERS • SURVEYORS • ARCHITECTS

7 Ridgway Court  
P.O. Box 437  
Elkhorn, WI. 53121  
Tel. 414-723-2098  
Fax. 414-723-5886  
Proj. No. 5378  
Date: 08/30/99

PREPARED FOR:  
**FRANK GARDNER**

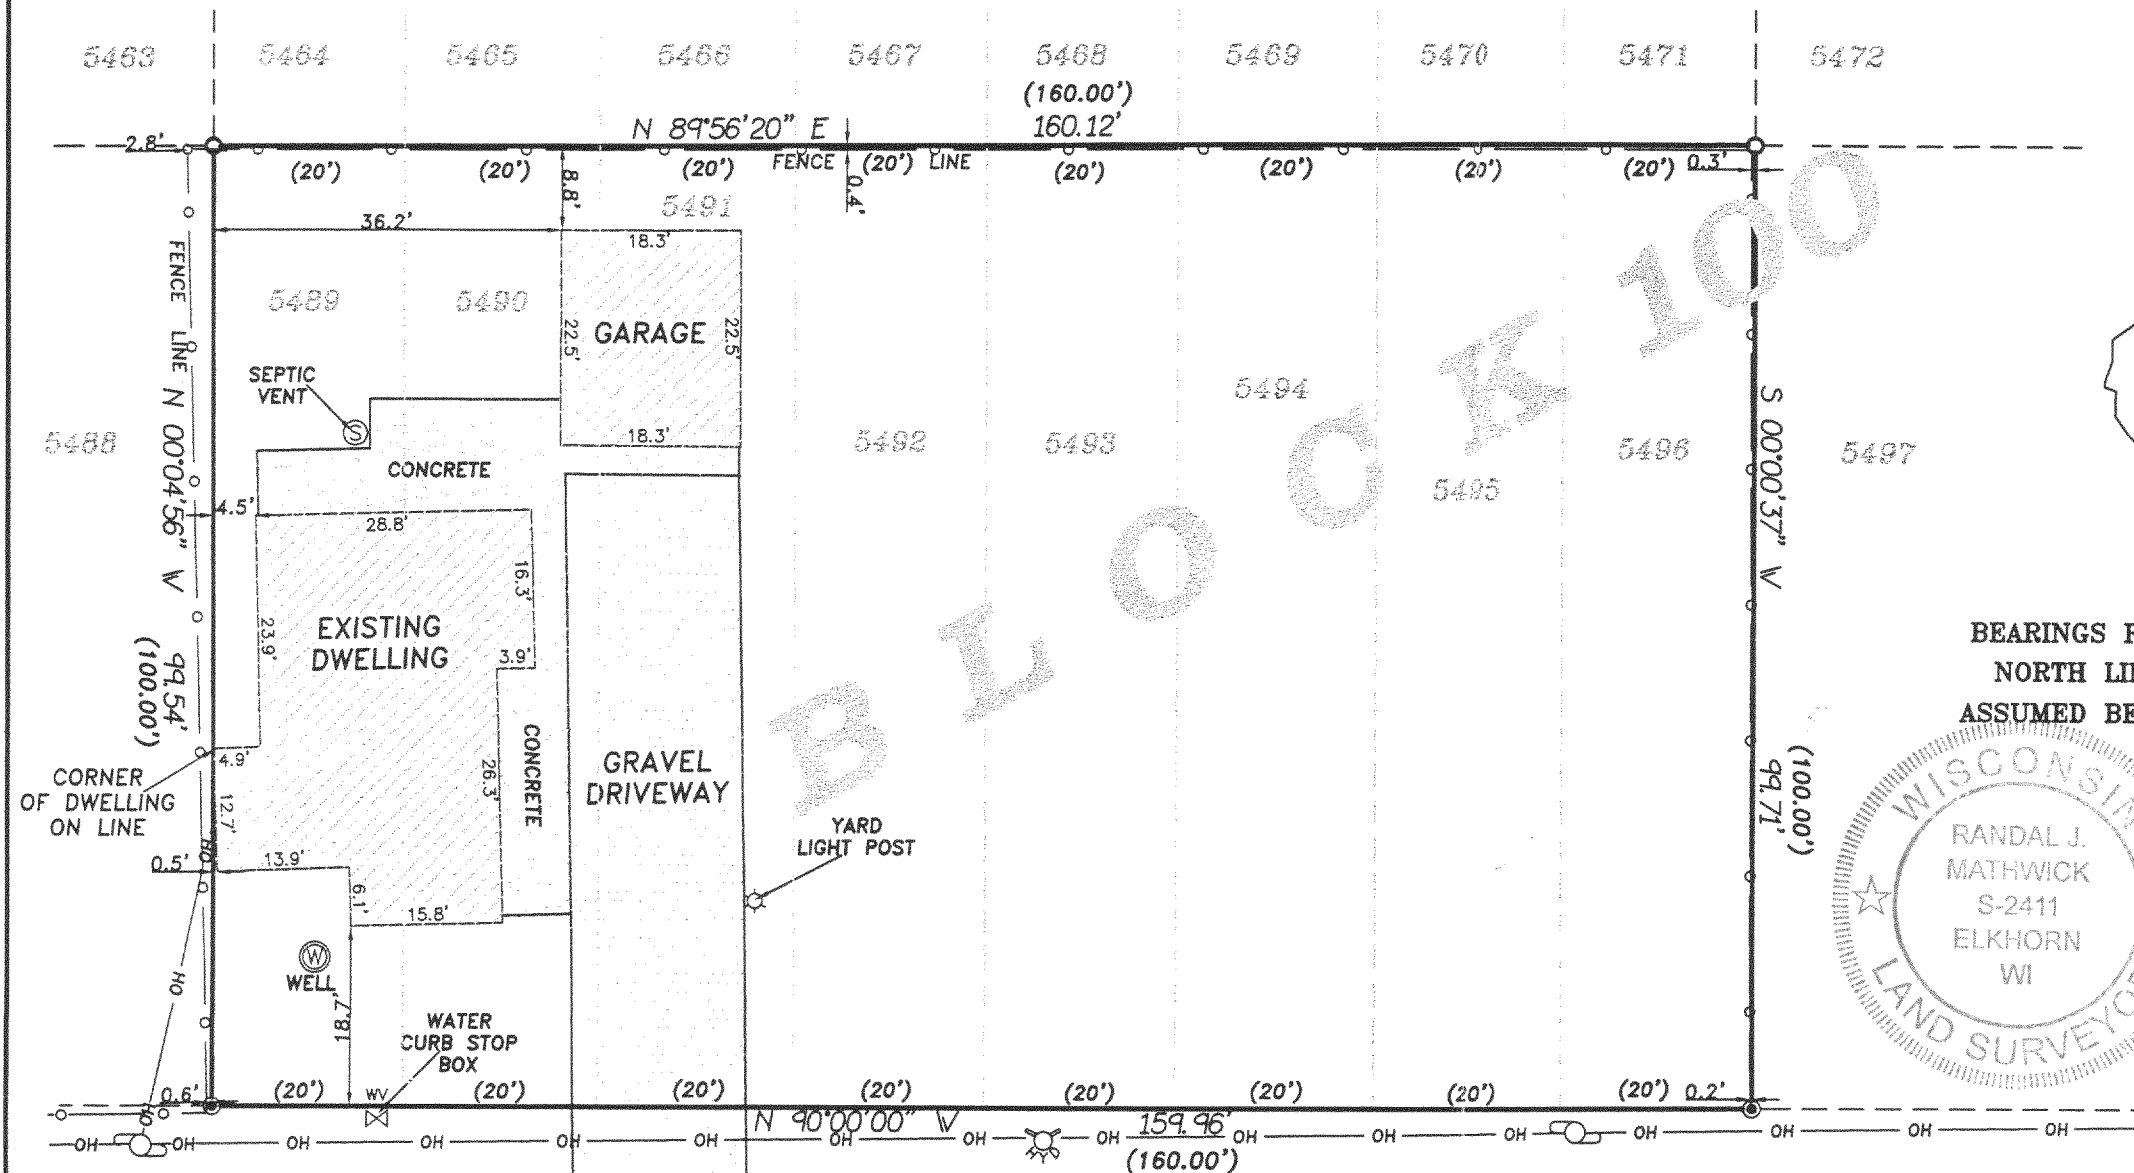

BEARINGS REFERENCED TO THE  
NORTH LINE OF GREEN ROAD  
ASSUMED BEARING: N 90°00'00" W



- LEGEND
- - FOUND IRON PIPE
  - - SET 3/4" IRON REBAR
  - - POWER POLE
  - OH— - OVERHEAD WIRES
  - ⊗ - HYDRANT
  - ( ) - RECORDED AS



SCALE: 1" = 20'


NOTE: COPIES OF THIS MAP TO WHICH THE FOLLOWING CERTIFICATE  
WILL APPLY ARE PRINTS SHOWING SURVEYOR'S ORIGINAL SEAL AND  
SIGNATURE IN RED INK. COPIES BY ANY OTHER MEANS MAY HAVE  
ALTERATIONS WHICH DO NOT REPRESENT THE SURVEYOR'S WORK PRODUCT.

I HEREBY CERTIFY THAT THE ABOVE DESCRIBED PROPERTY HAS BEEN  
SURVEYED UNDER MY DIRECTION AND THAT THE ABOVE MAP IS A TRUE  
REPRESENTATION THEREOF AND SHOWS THE SIZE AND LOCATION OF  
THE PROPERTY AND ITS EXTERIOR BOUNDARIES. THIS SURVEY IS  
MADE FOR THE USE OF THE PRESENT OWNERS OF THE PROPERTY, AND  
ALSO THOSE WHO PURCHASE, MORTGAGE, OR GUARANTEE THE TITLE  
THERE TO WITHIN ONE YEAR FROM THE DATE HEREOF.

DATED: AUGUST 30, 1999

*Randal J. Mathwick*  
RANDAL J. MATHWICK

R.L.S. 2411

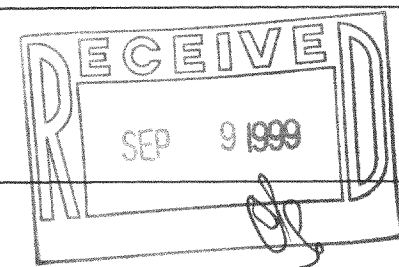

**GREEN ROAD**  
(40' WIDE R.O.W.)

ASPHALT PAVEMENT

MPL-1187

118-1846