


PLAT OF SURVEY

PATHFINDER SURVEYING
FORMERLY KOLB LAND CONSULTING
929 WILLIAMS STREET LAKE GENEVA, WI. 53147
(414) 248-3697



ORDERED BY: BRADEN & OLSON
716 WISCONSIN
LAKE GENEVA, WI. 53147

DATE: 7-7-1999

DESCRIPTION: LOTS 1721 THRU 1728 BLOCK 23 OF PELL LAKE
HIGHLANDS, A SUBDIVISION LOCATED IN SECTION
18, T1N, R18E, TOWN OF BLOOMFIELD, WALWORTH
COUNTY, WISCONSIN.

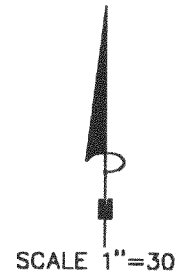

C.L. EASTWOOD ROAD (40') WIDE

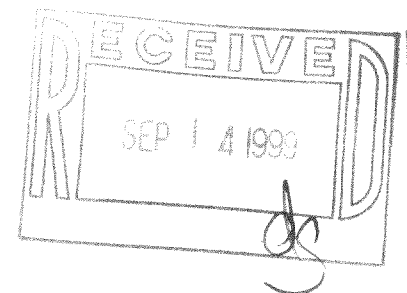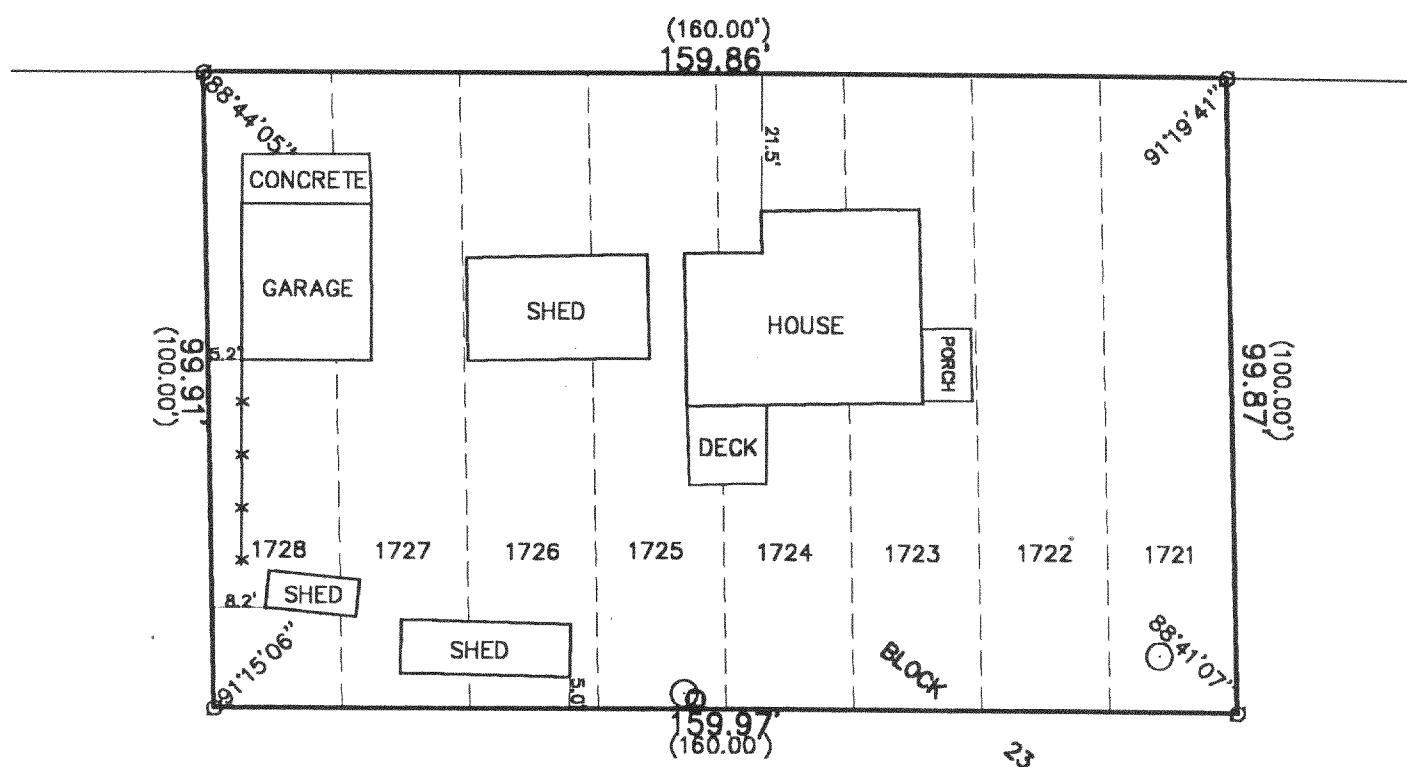


- LEGEND
- FOUND IRON PIPE
 - MANHOLE
 - (XXX) RECORDED AS
 - VENT
 - WELL

THE ABOVE MAP IS A TRUE REPRESENTATION THEREOF AND
SHOWS THE SIZE AND LOCATION OF ALL THE PROPERTY,
EXTERIOR BOUNDARIES, THE LOCATION OF ALL VISIBLE
BOUNDARY FENCES, APPARENT EASEMENTS, ROADWAYS
AND VISIBLE ENCROACHMENTS, IF ANY

THIS SURVEY IS MADE FOR THE USE OF THE PRESENT
OWNERS OF THE PROPERTY, AND ALSO THOSE WHO
PURCHASE, MORTGAGE OR GUARANTEE TITLE THERETO
WITHIN ONE (1) YEAR FROM DATE HERETO.

John P. Krott
JOHN P. KROTT, R.L.S. 2258

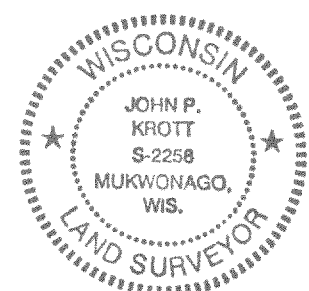

NOTE: THIS IS NOT A CERTIFIED COPY
UNLESS SEAL IS IN RED.
JOB NUMBER 98140 1-18 MPLH 0303

MPLH-303

118-1851