


PLAT OF SURVEY

- OF -

LOTS 8427-8436, BLOCK 178 OF PELL LAKE
SUBDIVISION LOCATED IN THE TOWN OF BLOOM-
FIELD, WALWORTH COUNTY, WISCONSIN.

SURVEY FOR: ZENK REALTY


SURVEY ADDRESS: N1104 SPRUCE ROAD

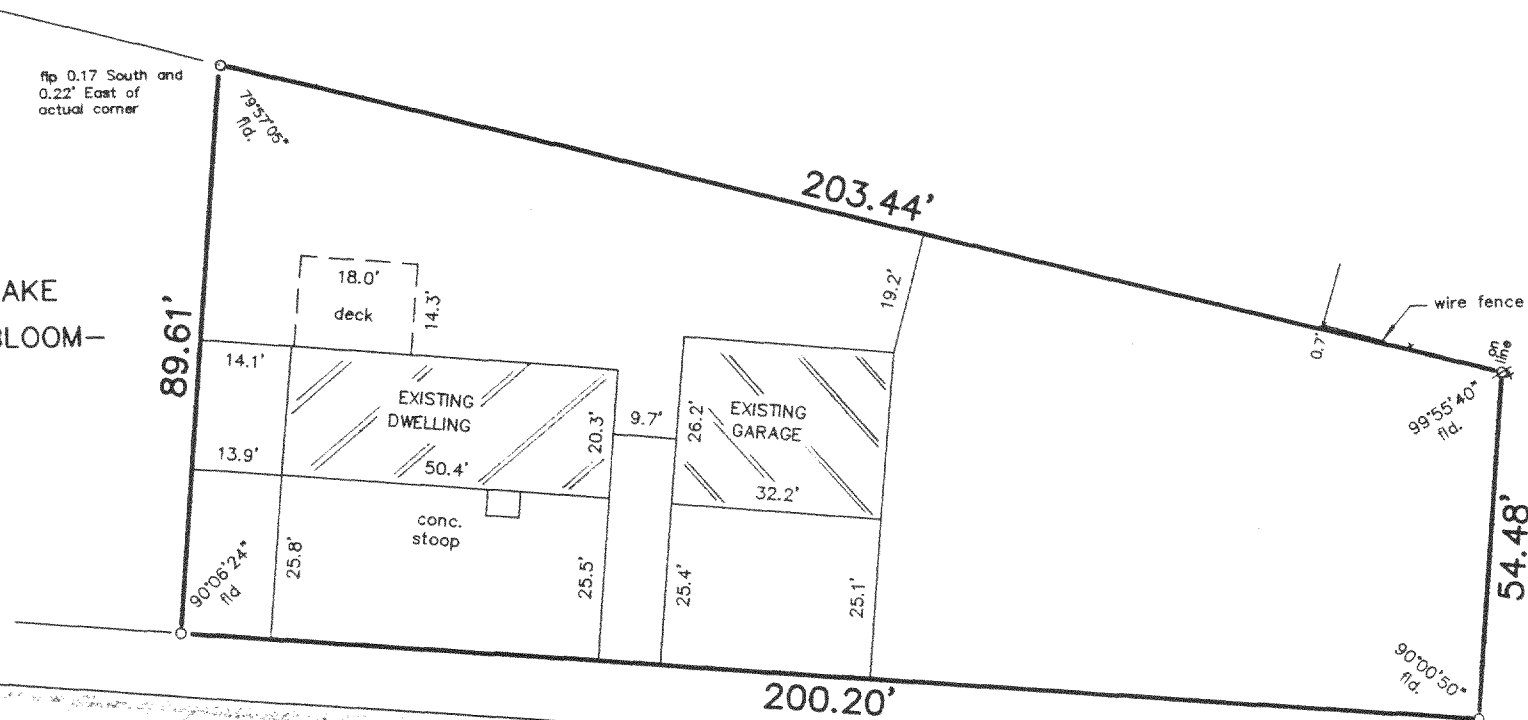

SPRUCE ROAD
40' WIDE

"I hereby certify that I have surveyed the above described property and that the above map is a correct representation thereof and shows the size and location of the property, its exterior boundaries, the location of all visible structures and dimensions of all principal buildings thereon, boundary fences, apparent easements, roadways and encroachments, if any."

"This survey is made for the use of the present owners of the property, and those who purchase, mortgage, or guarantee the title thereto within one year from date hereof."

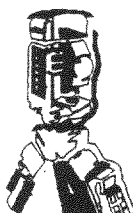

B.W. SURVEYING



412 N. PINE STREET
BURLINGTON, WI 53105
(414)-767-0225

SCALE

1" = 30'

LEGEND

- FOUND IRON PIPE
- Ø FOUND .38 DIA. IRON ROD

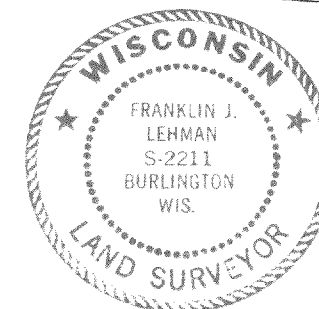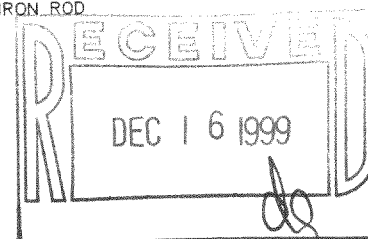

Franklin J. Lehman
FRANKLIN J. LEHMAN S-2211

7-15-99
DATE

4082
JOB NUMBER

MAP-1689

118-1873