
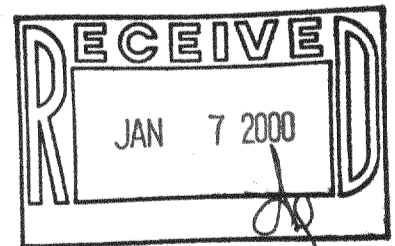


# PLAT OF SURVEY

OF

Lots 710 through 720, Block 12 of PELL LAKE ADDITION, being a subdivision in the West Half of the Southeast Quarter of Section 14, and in the North Half of the Northwest Quarter of Section 23, Township 1 North, Range 18 East of the 4th Principal Meridian, Town of Bloomfield, County of Walworth and State of Wisconsin.

FLORENCE ROAD

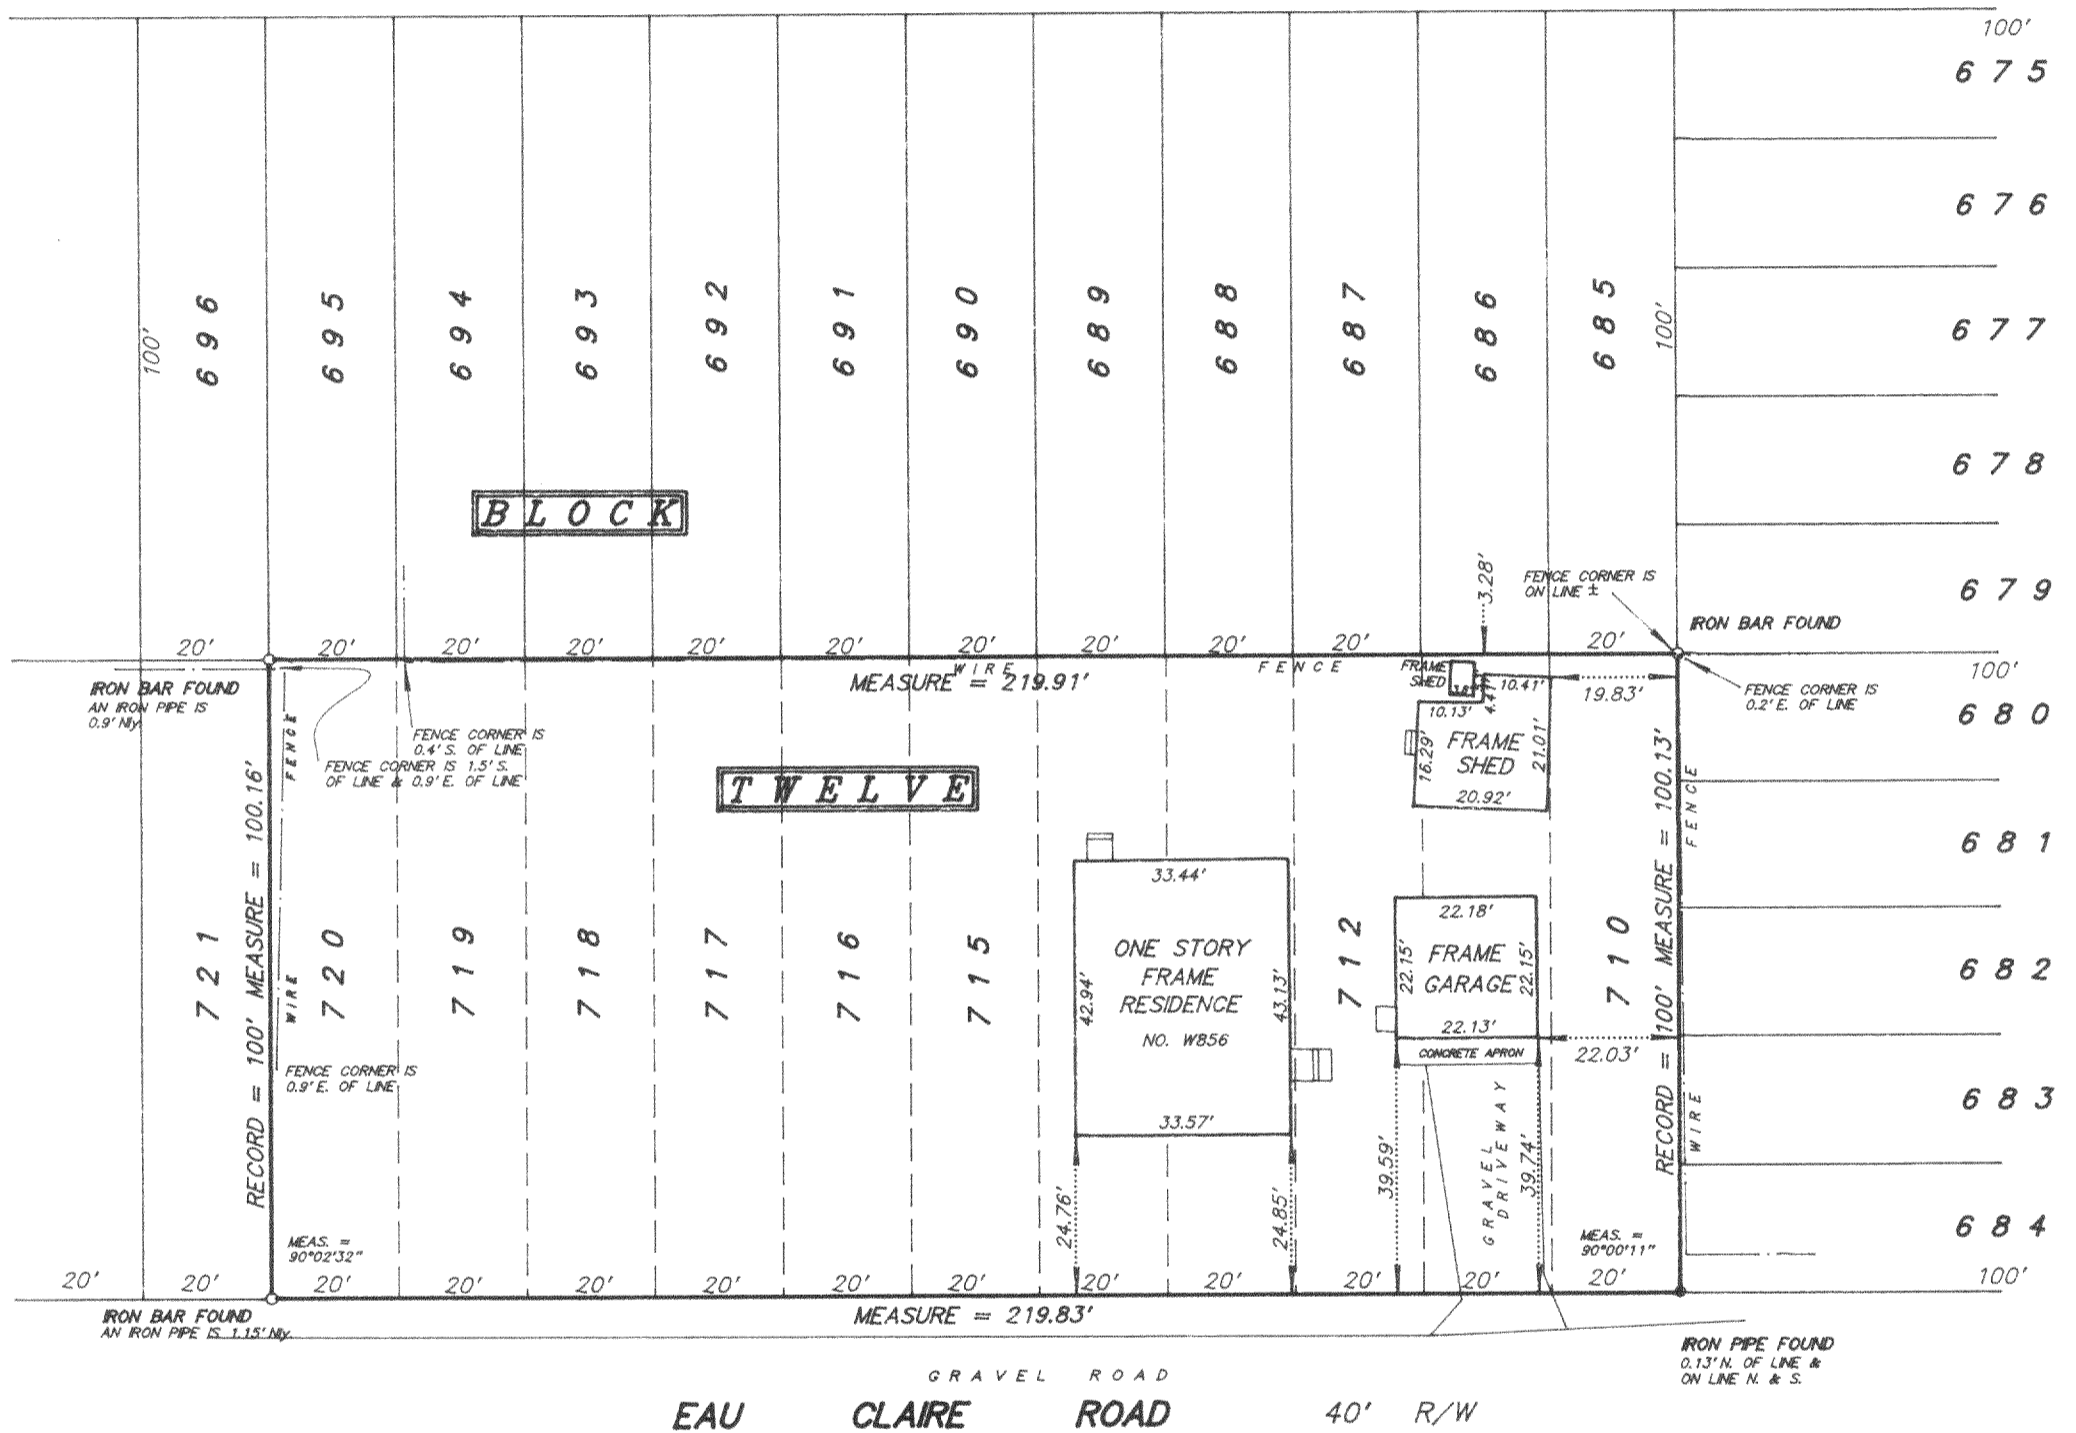

SCALE 1 inch = 30 feet

ORDERED BY J. Krasne / REMAX - Advantage

JOB NO. 99146

I hereby certify that I have surveyed the above described property and the above plat is a true representation thereof and shows the size and location of the property, its exterior boundaries, the location and dimensions of all visible structures thereon, boundary fences, apparent easements and roadways and visible encroachments, if any.

This survey is made for the exclusive use of the present owners of the property, and also those who purchase, mortgage, or guarantee the title thereto within one year from the date hereof.

Dated at Bassett, Wisconsin this \_\_\_\_\_ day of \_\_\_\_\_ 1999.

Mark A. Bolender  
Wisconsin Registered Land Surveyor S - 1784

118-1883  
MPLA-145