


PLAT OF SURVEY

Lot 1 and the east 50 feet of Lot 25 of WILLIAM ELLIOTT'S POWERS LAKE SUBDIVISION,
being a subdivision of part of the Northeast Fractional Quarter of Section 13,
Township 1 North, Range 18 East of the 4th Principal Meridian, Town of Bloomfield,
Walworth County, Wisconsin

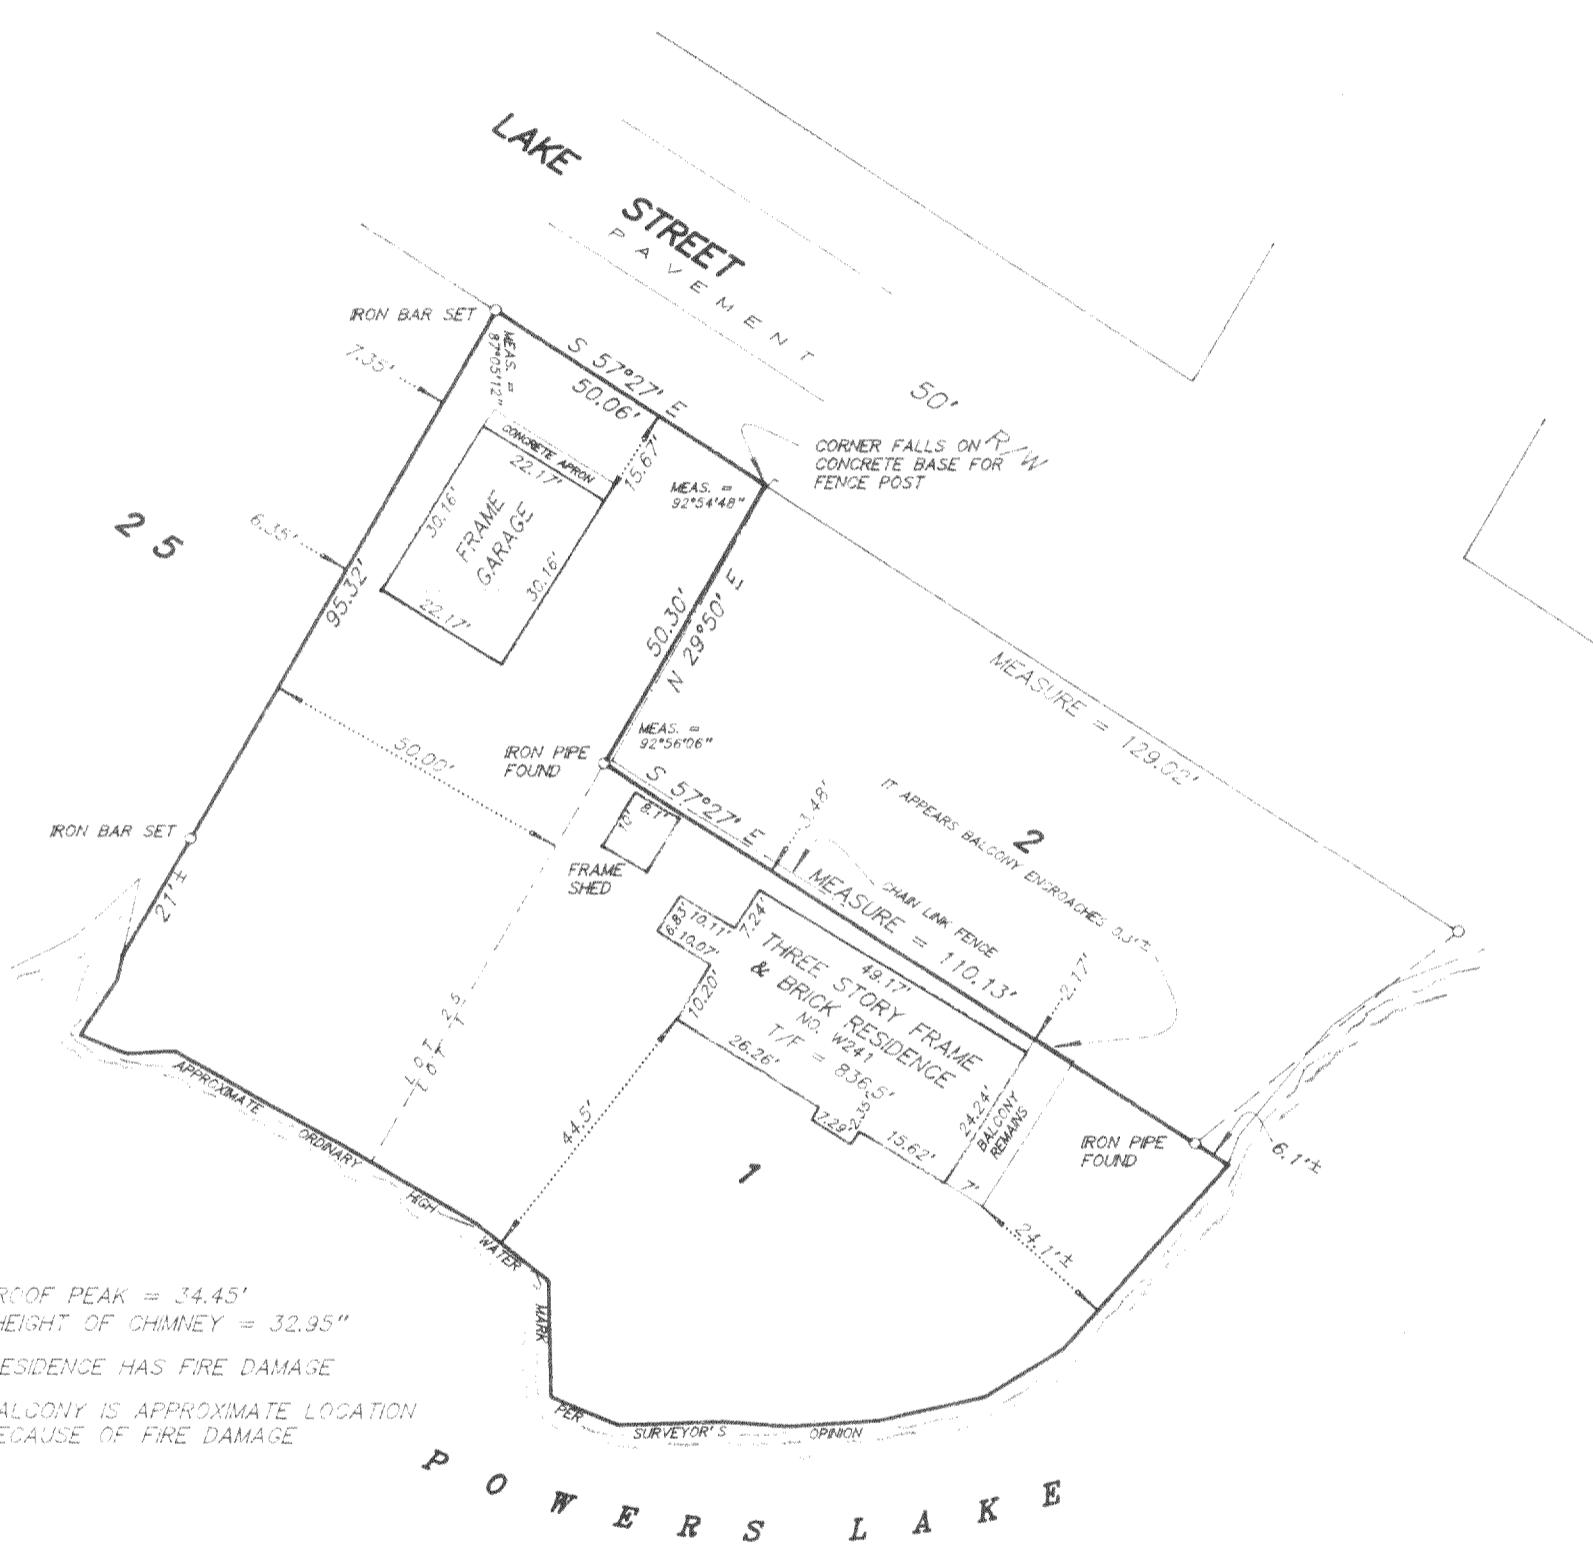


BENCH MARKS

BENCH MARK: Chiseled square north side concrete wall of corrugated metal culvert on Powers Lake Road bridge over East Branch Nippersink Creek Reference Mark RMSC of FIRM map.

Powers Lake 100 year base flood elevation is 833.0' per FIRM map, Panel 135 of 145, Community-Panel Number 550462 0135B, effective date August 15, 1983

LOWEST ELEVATION FOUND ON LOT WAS 833.57'

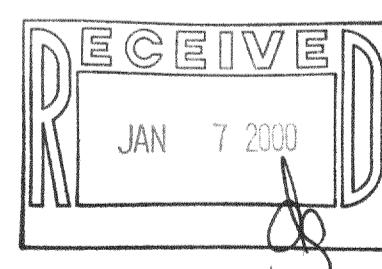

SCALE 1 inch = 30 feet

ORDERED BY F Kline

JOB NO 99197

I hereby certify that I have surveyed the above described property and the above plat is a true representation thereof and shows the size and location of the property, its exterior boundaries, the location and dimensions of all visible structures thereon, boundary fences, apparent easements and roadways and visible encroachments, if any.

This survey is made for the exclusive use of the present owners of the property, and also those who purchase, mortgage, or guarantee the title thereto within one year from the date hereon.

Dated at Bennett, Wisconsin this 11th day of July, 1908.

Mark A. Bolender
Wisconsin Registered Land Surveyor S - 1784