
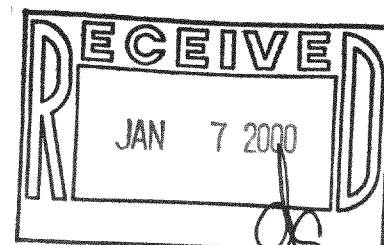


PLAT OF SURVEY
OF

PHONE 414-537-4874
FAX 414-537-4221

Lots 6688-6700, Block 146, PELL LAKE SUBDIVISION, located in Section 15, Township 1 North, Range 18 East of the 4th Principal Meridian, Town of Bloomfield, Walworth County, Wisconsin.

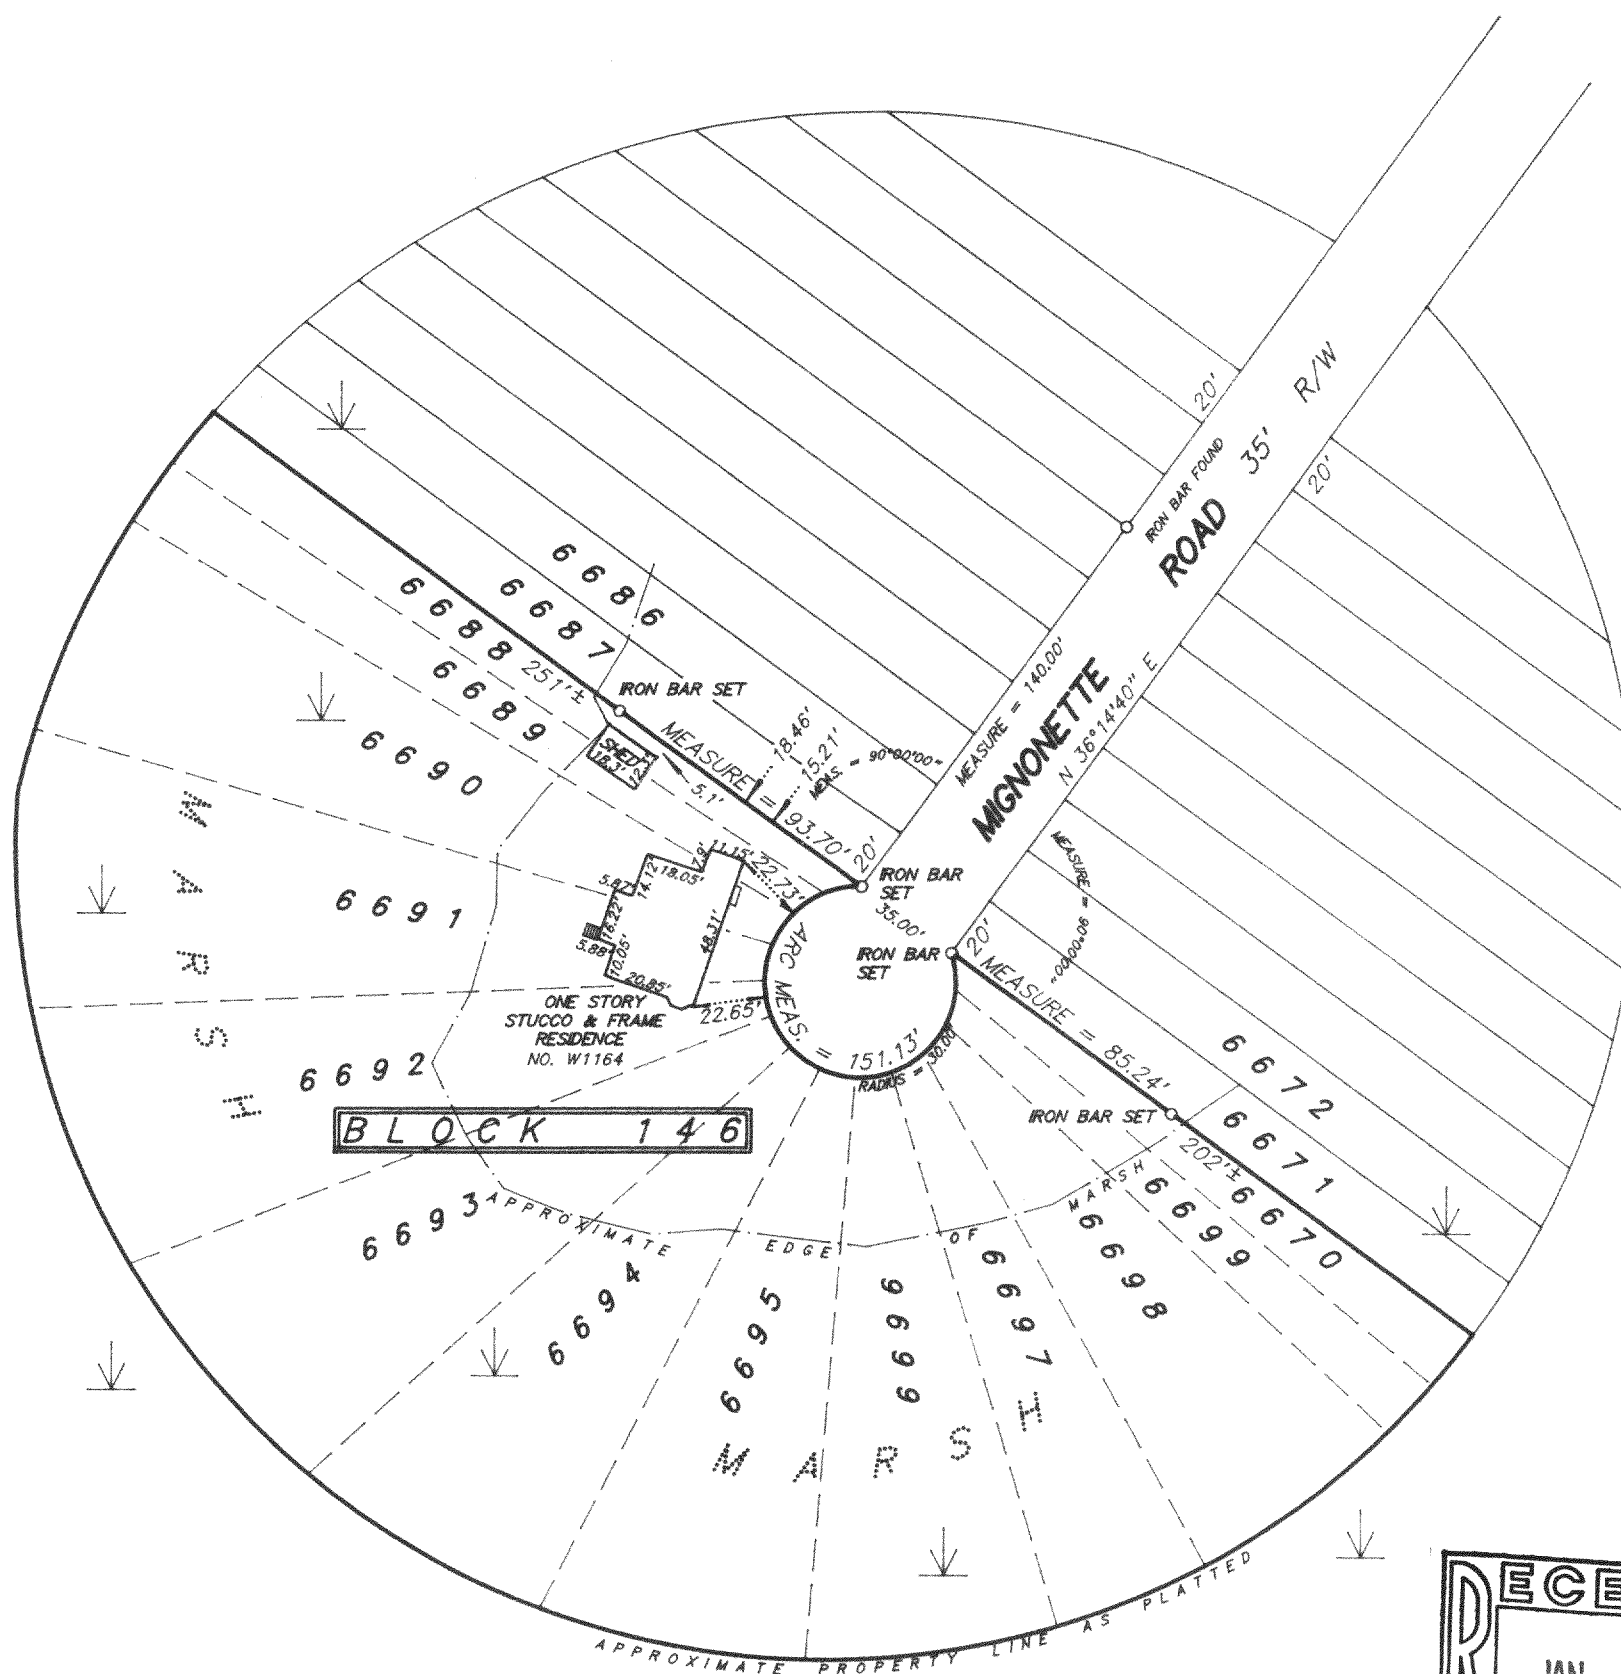

SCALE 1 inch = 60 feet
 ORDERED BY A. Pierce / Pierce Construction
 JOB NO. 9 9 2 1 1

I hereby certify that I have surveyed the above described property and the above plat is a true representation thereof and shows the size and location of the property, its exterior boundaries, the location and dimensions of all visible structures thereon, boundary fences, apparent easements and roadways and visible encroachments, if any.

This survey is made for the exclusive use of the present owners of the property, and also those who purchase, mortgage, or guarantee the title thereto within one year from the date hereof.

Dated at Bassett, Wisconsin this _____ day of _____ 1999.

Mark A. Bolender
Wisconsin Registered Land Surveyor S - 1784

118-1885
NPL-1460