

HAWTHORNE


ROAD

N

SANDLEWOOD DRIVE

SCALE-1"=20'
O=IRON PIPE

MULBERRY DRIVE

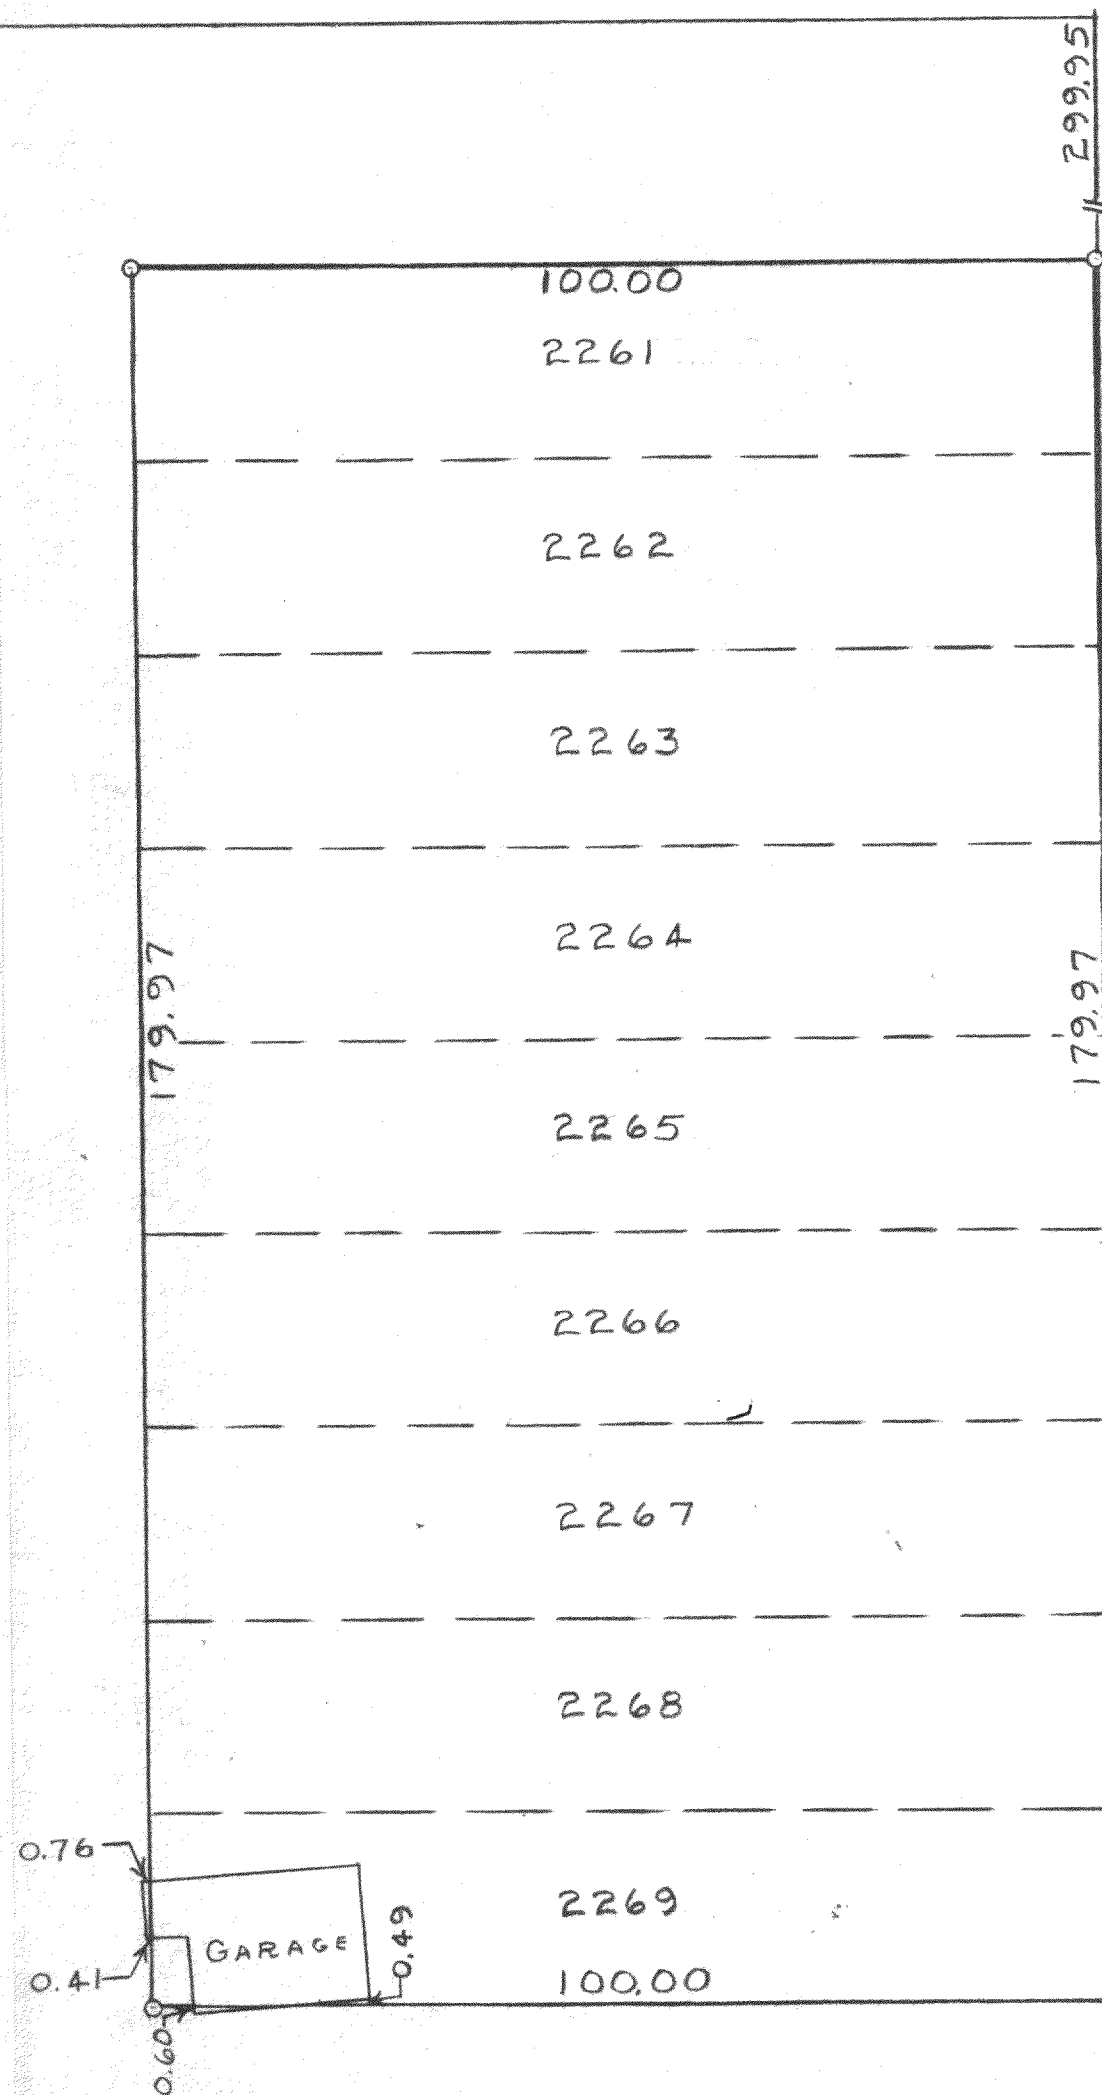

PLAT OF SURVEY OF LOTS 2261-2269 INCLUSIVE OF SECTION 2 OF PELL
LAKE SUBDIVISIONS, T1N18E OF WALWORTH COUNTY, WISCONSIN
OCTOBER 21, 1955

George T. Dunham
GEORGE T. DUNHAM, SURVEYOR
DELAVER, WISCONSIN

118-19