


993349
99334981.DWG

PLAT OF SURVEY

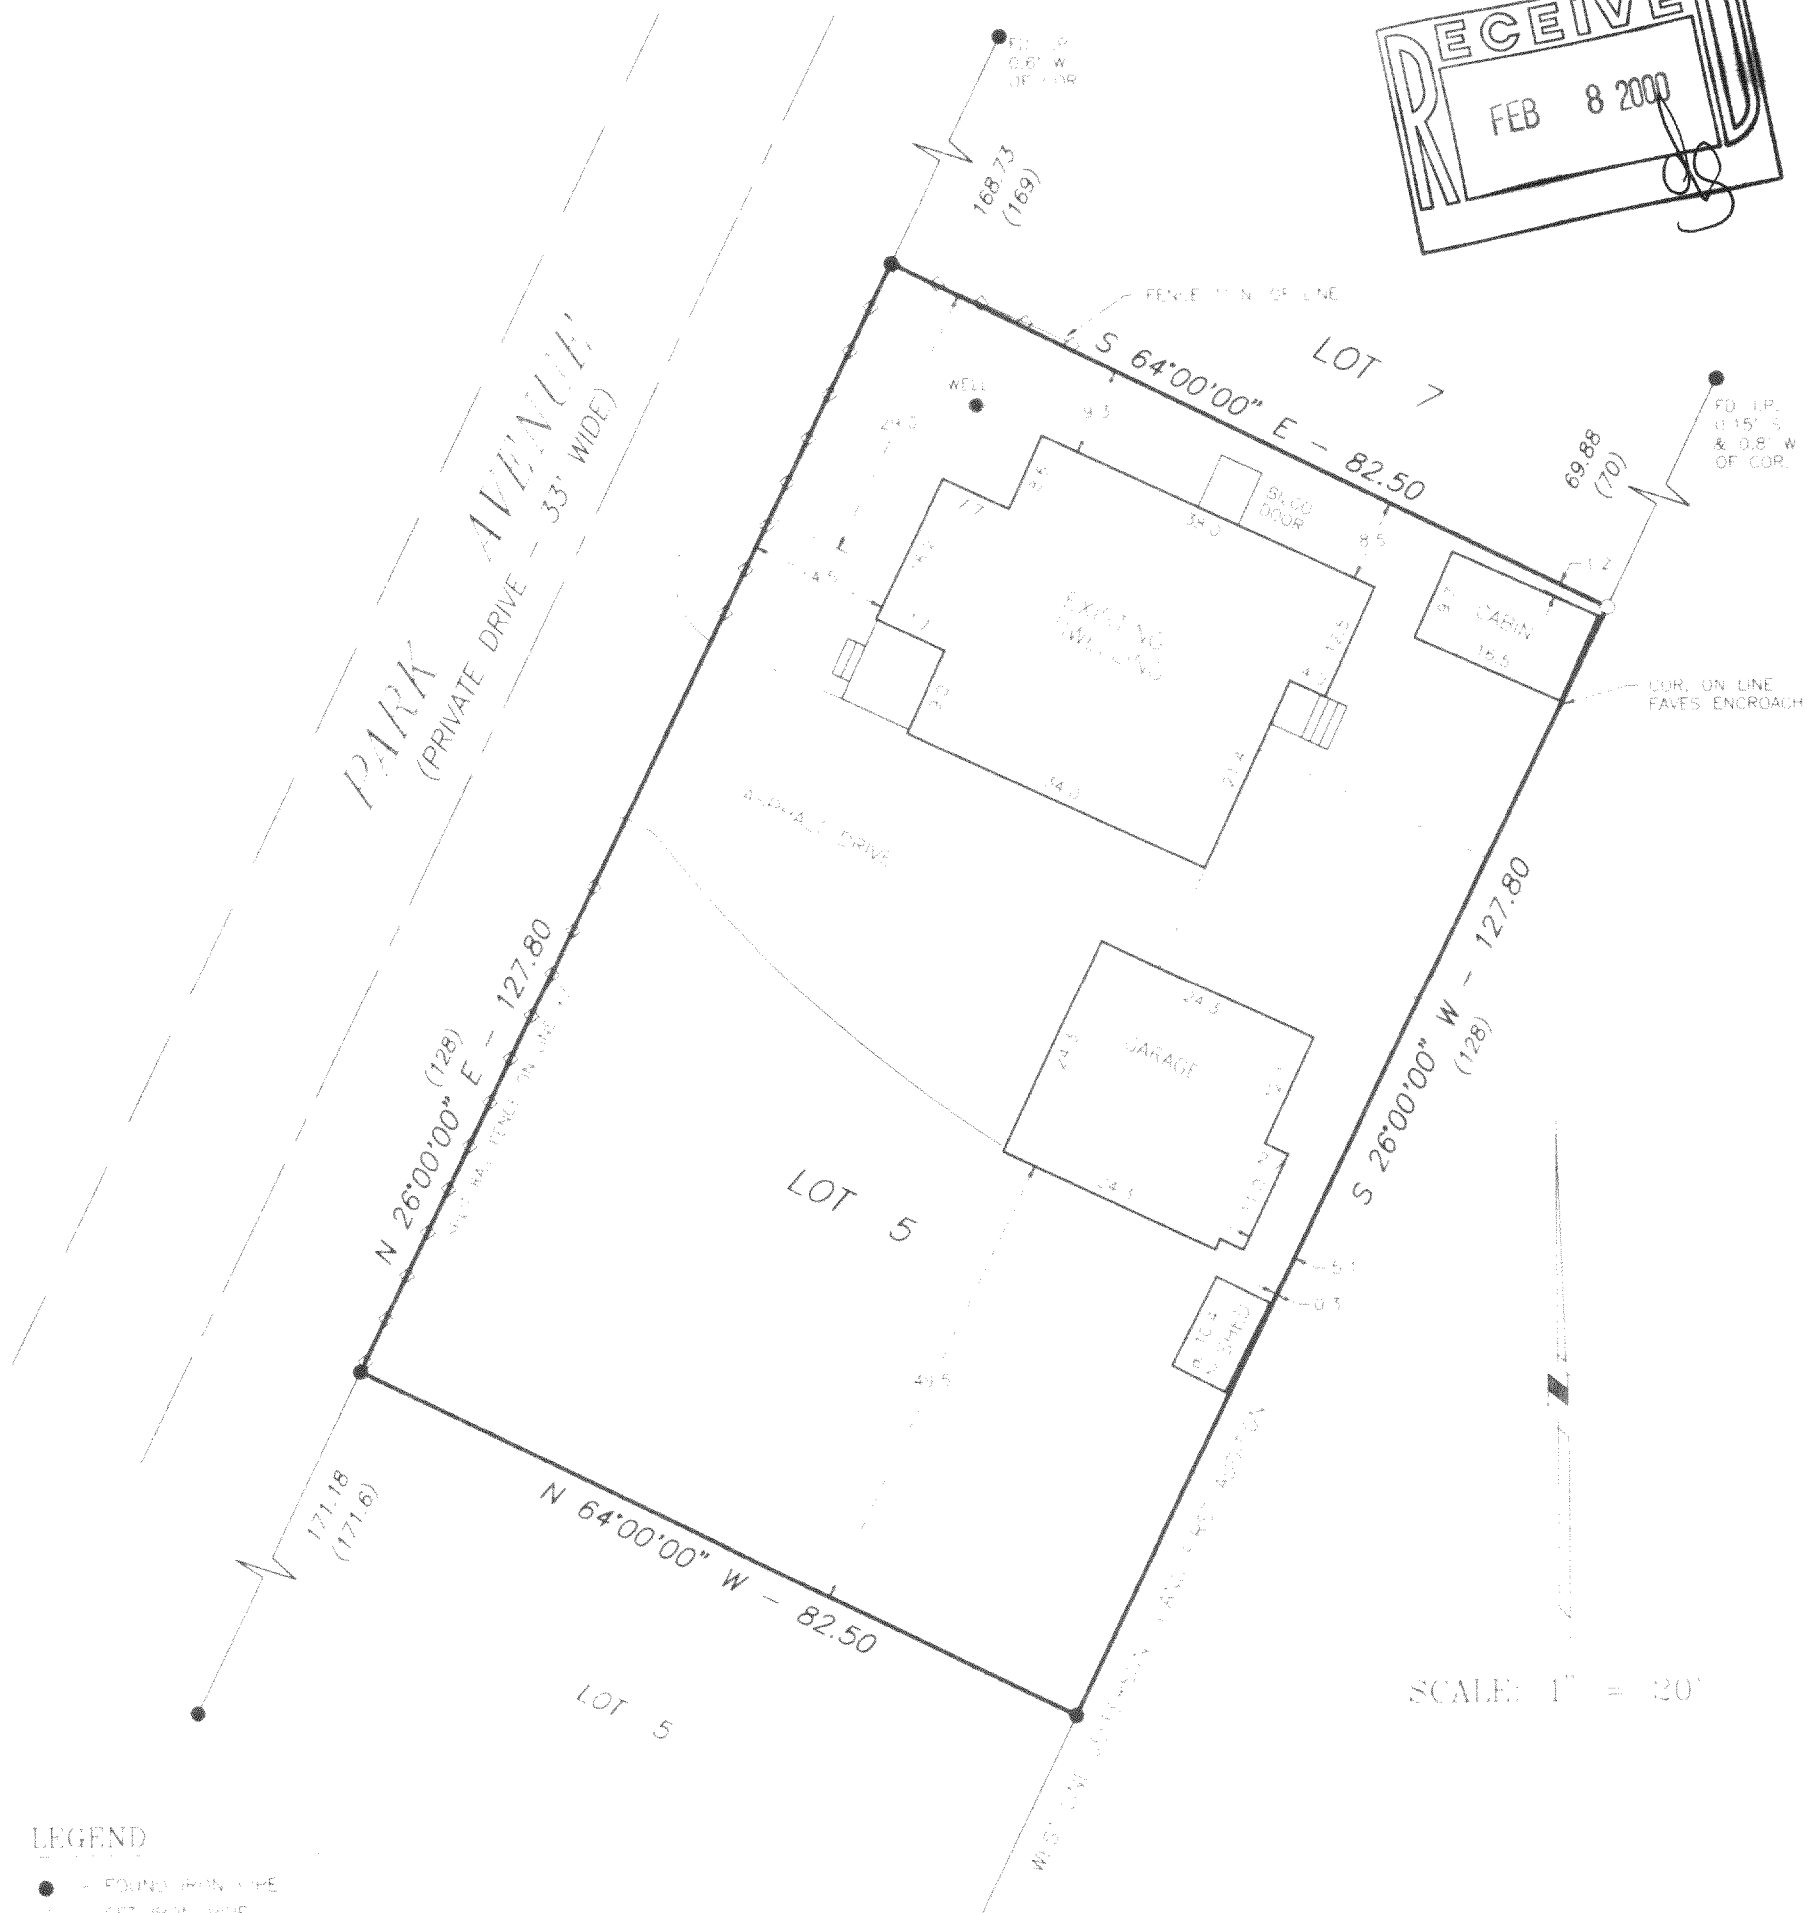

LEGEND

- - FOUND FROM CASE
- - SET FROM CASE
- - RELIANCE ON

SURVEY PREPARED FOR: GARY WIER - BEAR REALTY
25110 75TH STREET
SALEM, WI 53168

HEREBY CERTIFY THAT I HAVE SURVEYED THE ABOVE DESCRIBED PROPERTY AND THE ABOVE MAP IS A TRUE REPRESENTATION THEREOF AND SHOWS THE SIZE AND LOCATION OF THE PROPERTY, THE LOCATION OF ALL VISIBLE STRUCTURES AND DIMENSIONS OF ALL PRINCIPAL BUILDINGS THEREON, BOUNDARY FENCES, APPARENT EASEMENTS, ROADWAY AND VISIBLE ENCROACHMENTS, IF ANY.

THIS SURVEY IS MADE FOR THE PRESENT OWNERS OF THE PROPERTY AND ALSO THOSE WHO MAY PURCHASE OR GUARANTEE THE TITLE THERETO WITHIN (1) YEAR FROM THE DATE HEREOF

MAILED AT WATERFORD 1945 8TH . A. D. OCTOBER

RECERTIFIED

8TH OCTOBER 1999
Jerry E Boat

MLC-5

118-1904