
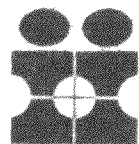
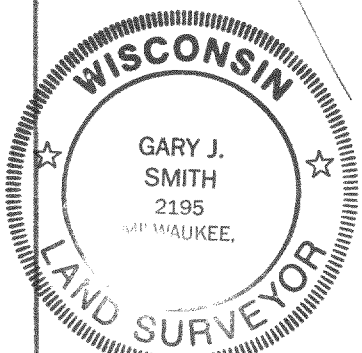
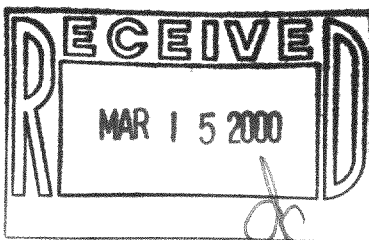


"RECERTIFICATION"
Plat of Survey

Survey For: WOLTER BROS. BUILDERS
 Location: LYNN LANE

SEYENSKE/DASSOW

Description: LOT 3 LAKE GENEVA AIRE ESTATES, a subdivision located in the Southeast
 1/4 of Section 4, Town 1 North, Range 18 East, Walworth County, Wisconsin.

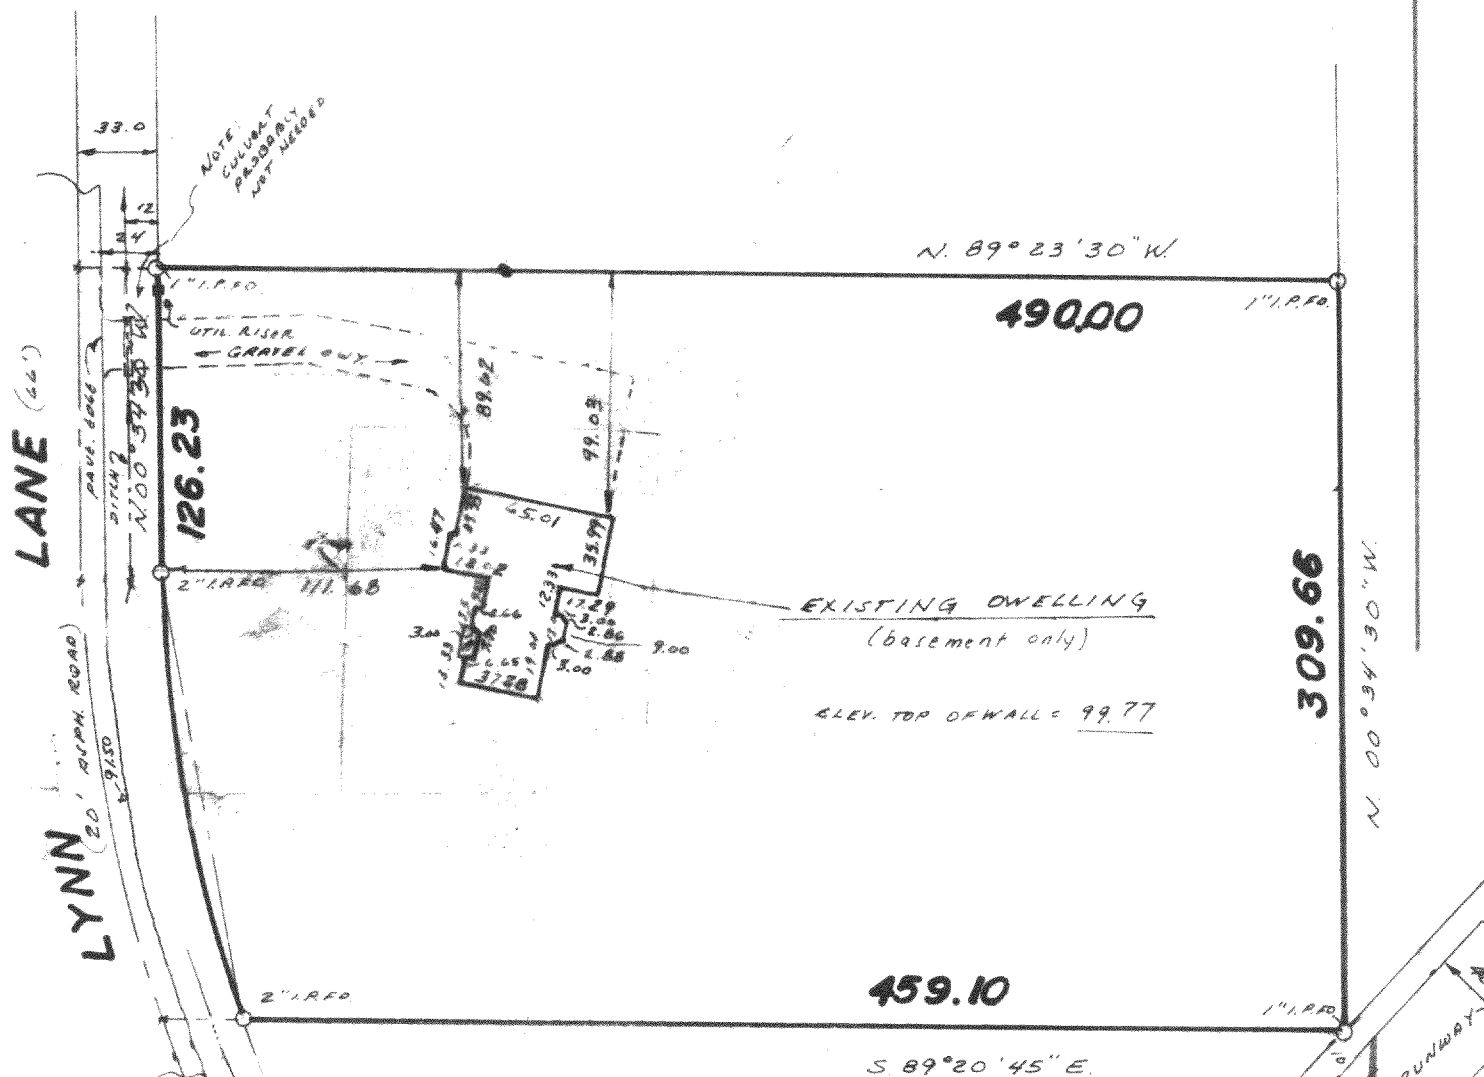

INTERLINE SURVEY SERVICES, INC.
 11221 W. FOREST HOME AVE.
 FRANKLIN, WISCONSIN 53132
 PHONE 425-2060

CURVE DATA
 RAD. = 561.39
 CHD. = 186.28
 Δ = 19° 06' 00"
 BRG. = S. 10° 07' 30" E.

State of Wisconsin) ss
 Milwaukee County

SURVEY CERTIFICATE

Scale: 1" = 80'

We, Interline Survey Services, Inc., certify that we have surveyed the above described property and the above map is a true representation thereof, and shows the size and location of the property, its exterior boundaries, the location and dimensions of all visible structures thereon, fences, apparent easements and roadways and visible encroachments, if any.

This survey is made for the exclusive use of the present owners of the Property, and also those who purchase, mortgage, or guarantee the title thereto, within one (1) year from date hereof.

Gary J. Smith

Wisconsin Registered Land Surveyor


Date: 7-22-99
 Job No: 27061

Plat of Survey


Survey For: WOLTER BROS. BUILDERS
Location: LYNN LANE

SEYENSKE/DASSOW

Description: LOT 3 LAKE GENEVA AIRE ESTATES, a subdivision located in the Southeast 1/4 of Section 4, Town 1 North, Range 18 East, Walworth County, Wisconsin.

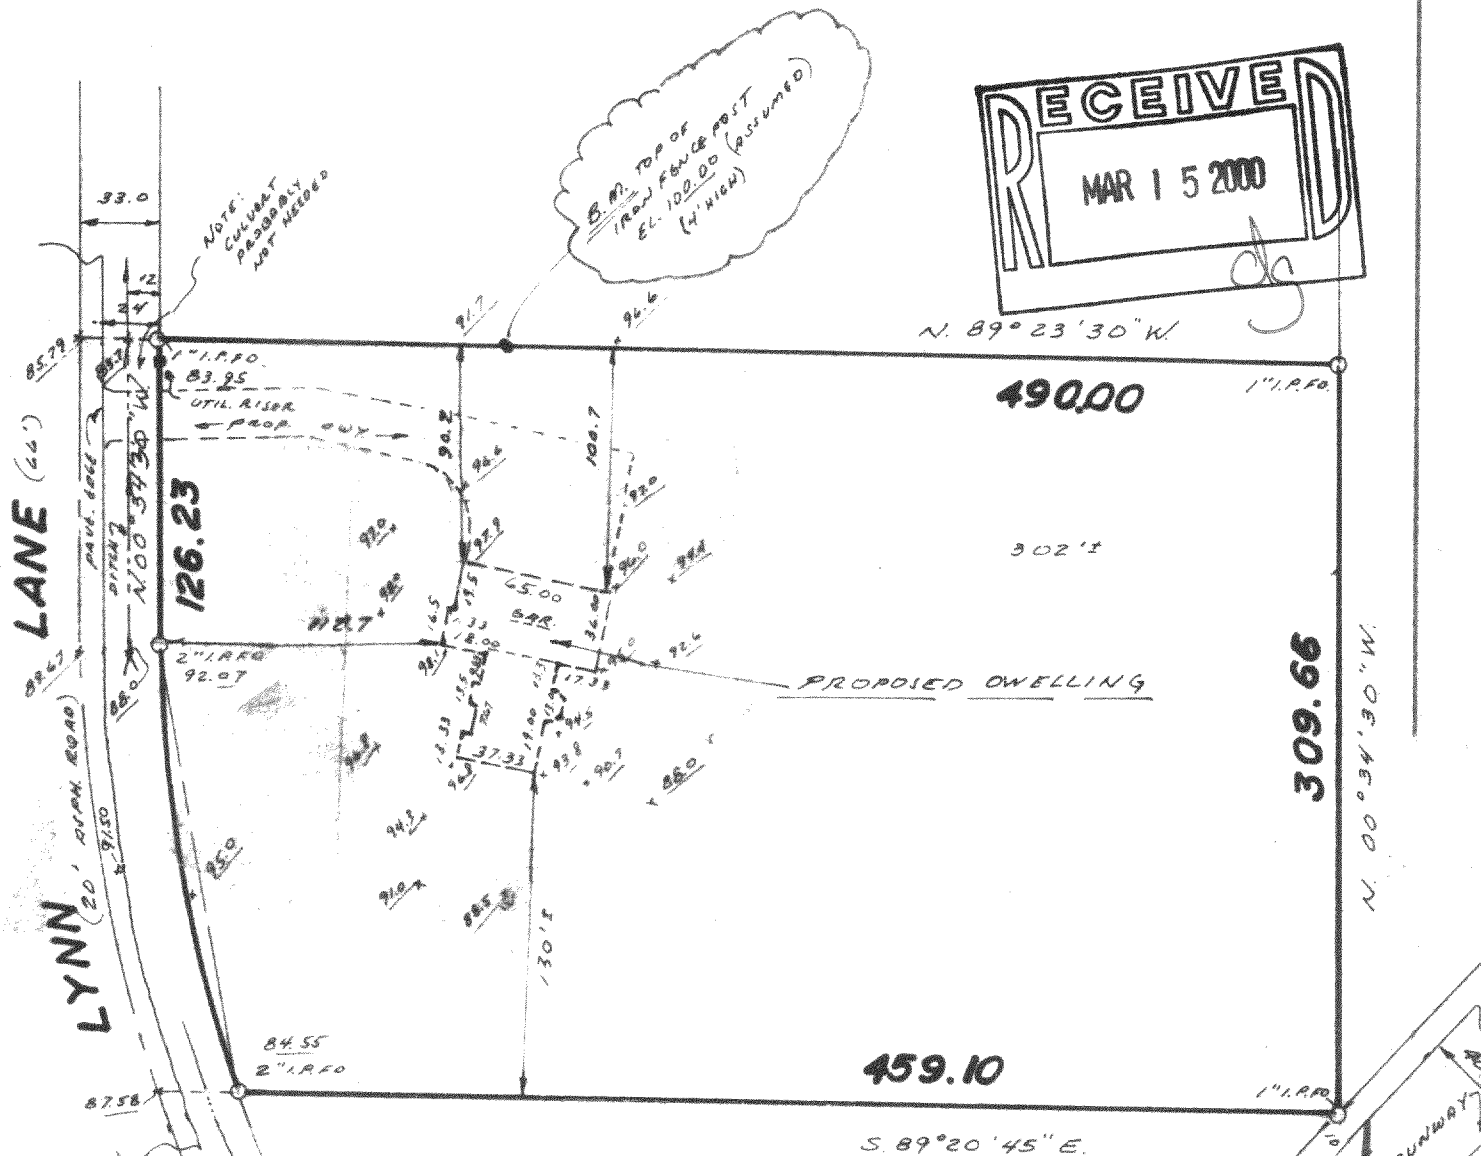

State of Wisconsin) ss
Milwaukee County

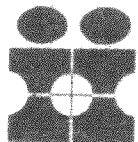

INTERLINE SURVEY SERVICES, INC.
11221 W. FOREST HOME AVE
FRANKLIN, WISCONSIN 53132
PHONE 425-2050

SURVEY CERTIFICATE

CURVE DATA
R.A.D. = $56^{\circ}13'39''$
C.H.D. = 186.28
 $\Delta = 19^{\circ}06'00''$
B.A.G. = $S. 10^{\circ}07'30''E.$

Scale: 1" = 80'

We, Interline Survey Services, Inc., certify that we have surveyed the above described property and the above map is a true representation thereof, and shows the size and location of the property, its exterior boundaries, the location and dimensions of all visible structures thereon, fences, apparent easements and roadways and visible encroachments, if any.

This survey is made for the exclusive use of the present owners of the Property, and also those who purchase, mortgage, or guarantee the title thereto, within one (1) year from date hereof.

Gary J. Smith

Wisconsin Registered Land Surveyor

REV. 6/24/99

Date: 6/17/99

Job No.: 26843