
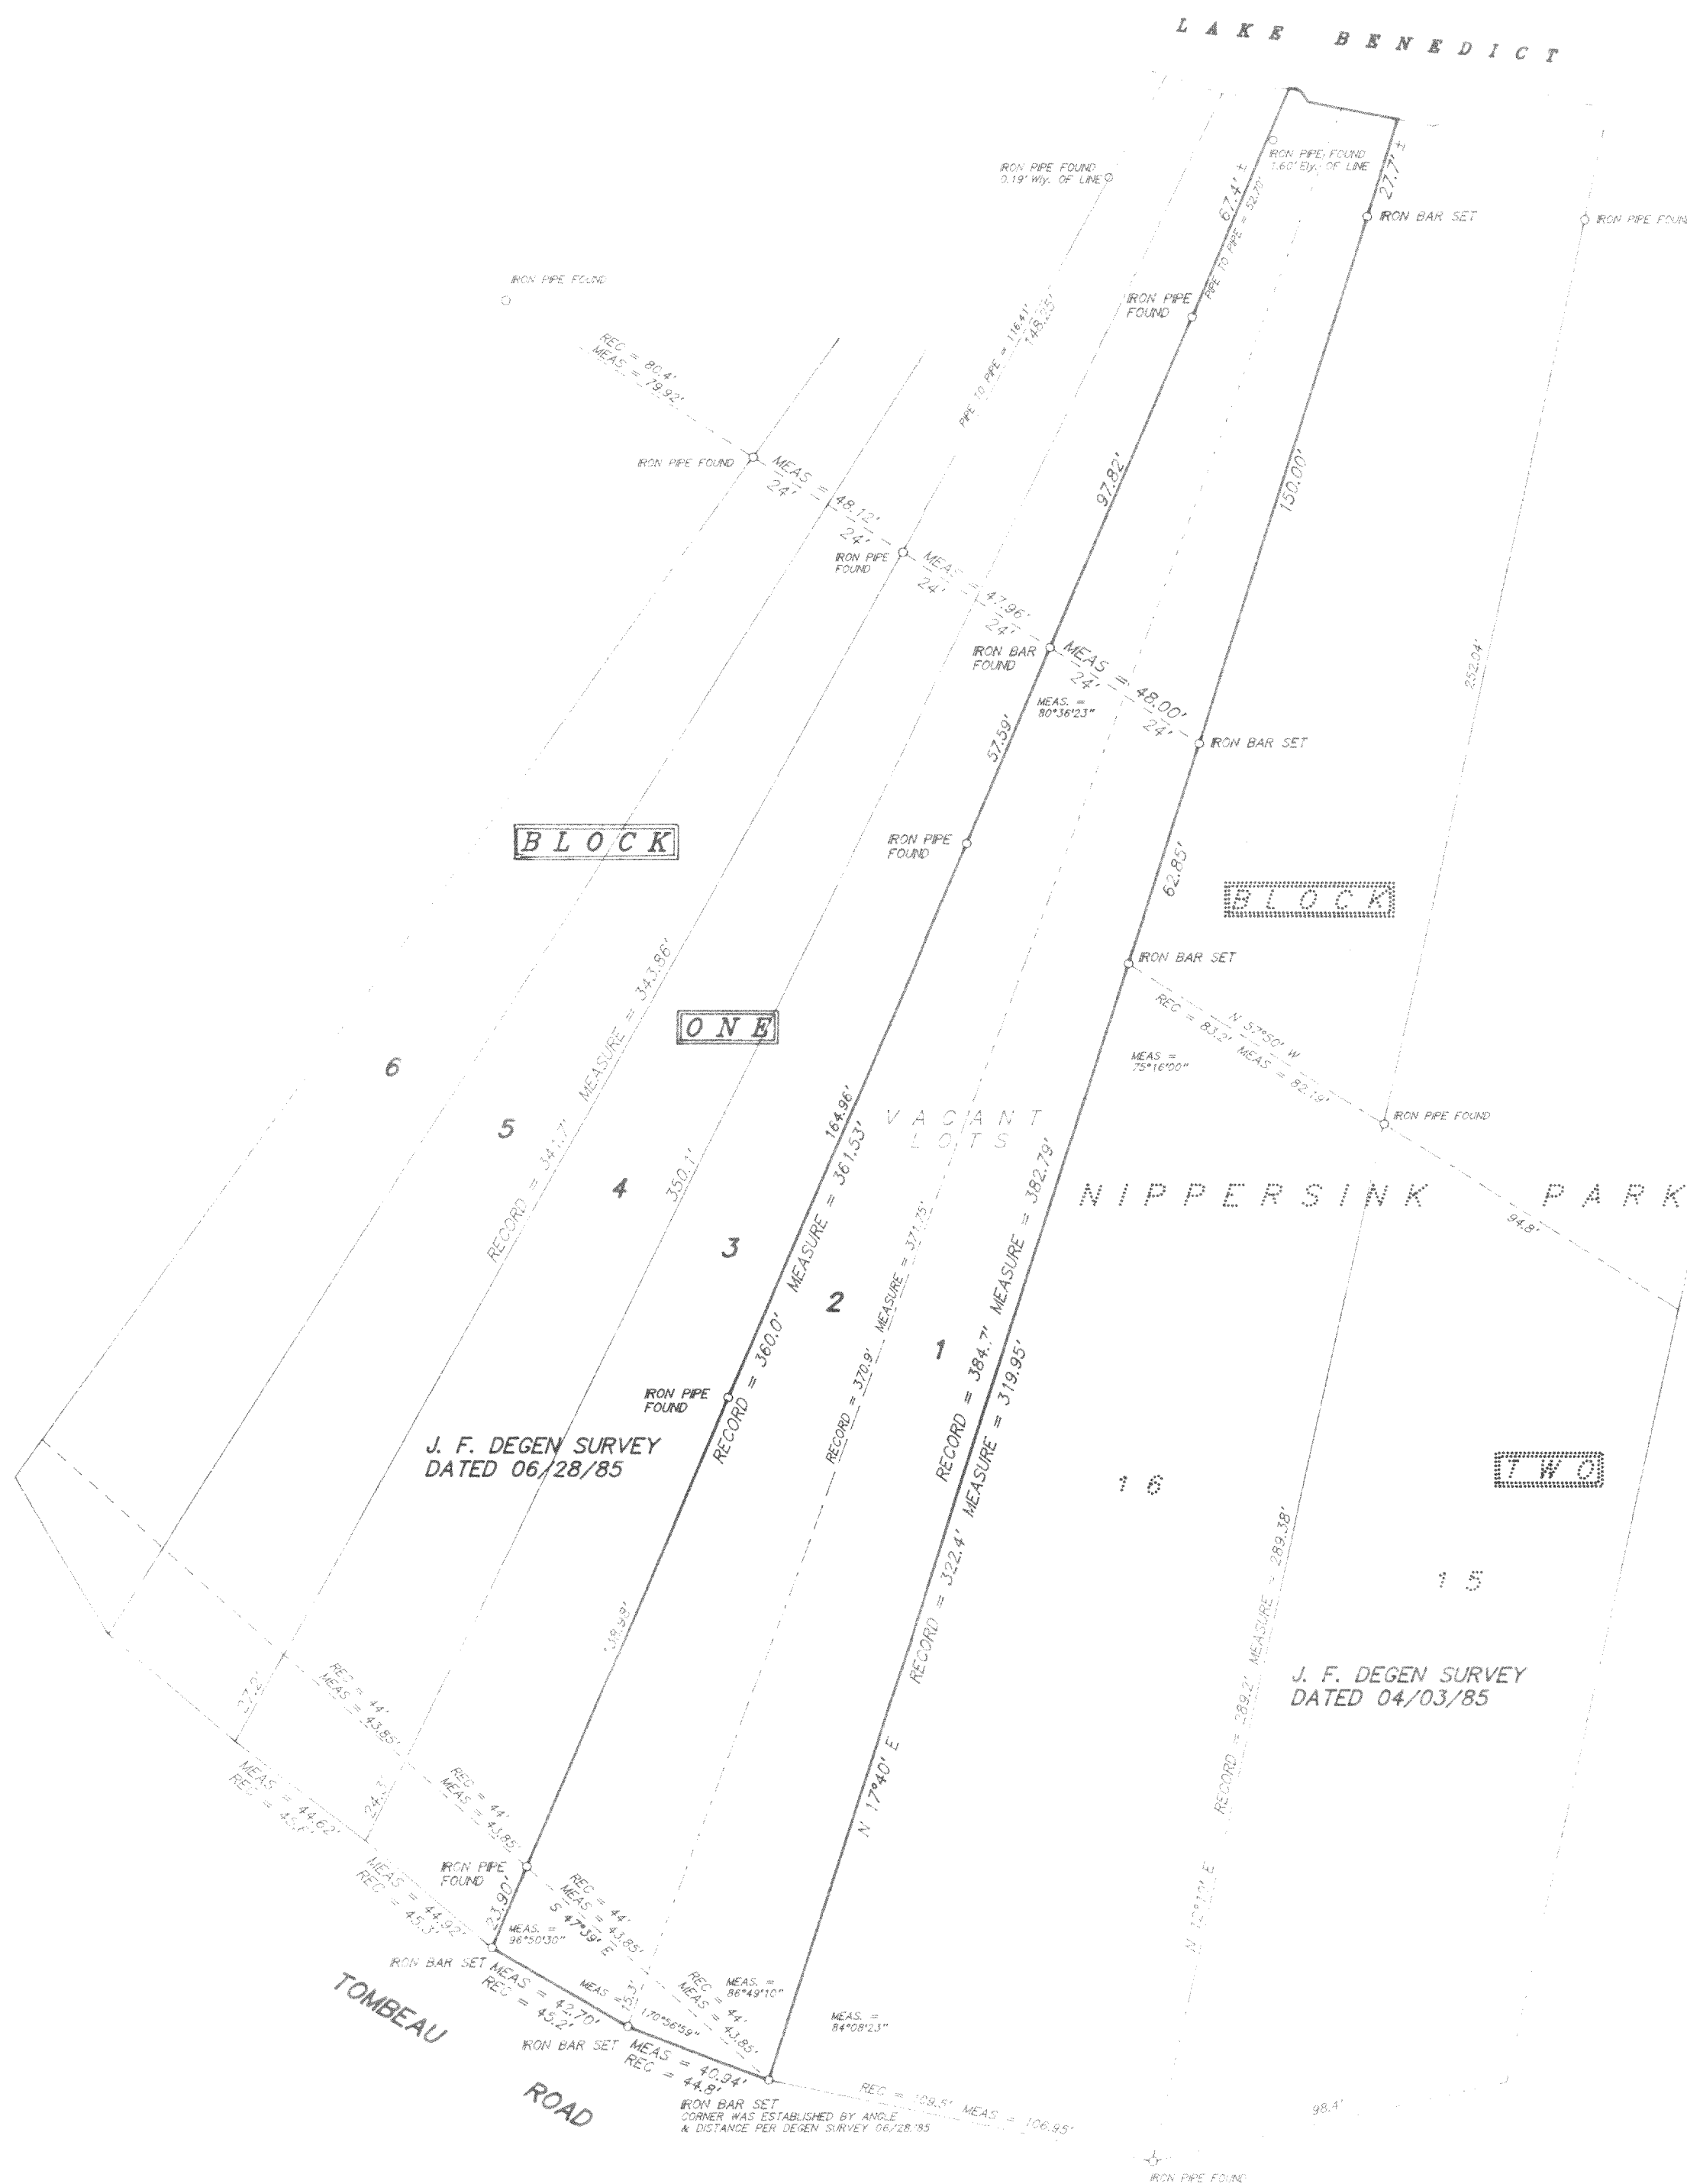


PLAT OF SURVEY OF

Lots 1 and 2, Block 1 of SHINNER'S 8th ADDITION TO NIPPERSINK PARK, being a subdivision of that part of the Northeast Quarter of Section 24, Township 1 North, Range 18 East of the 4th Principal Meridian, Bloomfield Township, Walworth County, Wisconsin.

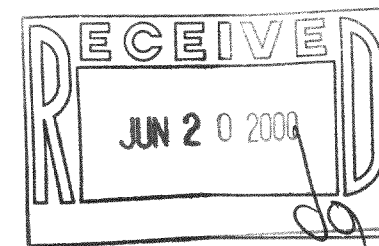

N

SCALE 1 inch = 40 feet
ORDERED BY R. Duomo
JOB NO. 28354

I hereby certify that I have surveyed the above described property and the above plat is a true representation thereof and shows the size and location of the property, its exterior boundaries, the location and dimensions of all visible structures thereon, boundary lines, apparent easements and roadways and visible encroachments, if any.

This survey is made for the exclusive use of the present owner of the property, and also those who purchase, mortgage, or guarantee the title thereto within one year from the date hereof.

Dated at Bassett, Wisconsin this 19th day of June, 1998.

Mark A. Briender
Wisconsin Registered Land Surveyor 5-1784