

DEGEN, FOAT SURVEYING ASSOCIATES



100 SOUTH SECOND STREET
WATERFORD, WISCONSIN
(262)534-5404 (FAX)534-2022

004200
004200S1.DWG

PLAT OF SURVEY

LOTS 6639-6643, BLOCK 143 OF SECTION 4 OF PELL LAKE SUBDIVISION, LOCATED IN TOWN 1 NORTH,
RANGE 18 EAST, WALWORTH COUNTY, WISCONSIN.

SURVEY PREPARED FOR: RE/MAX-SOUTHERN LAKES
112 ELIZABETH LANE
GENOA CITY, WI 53128

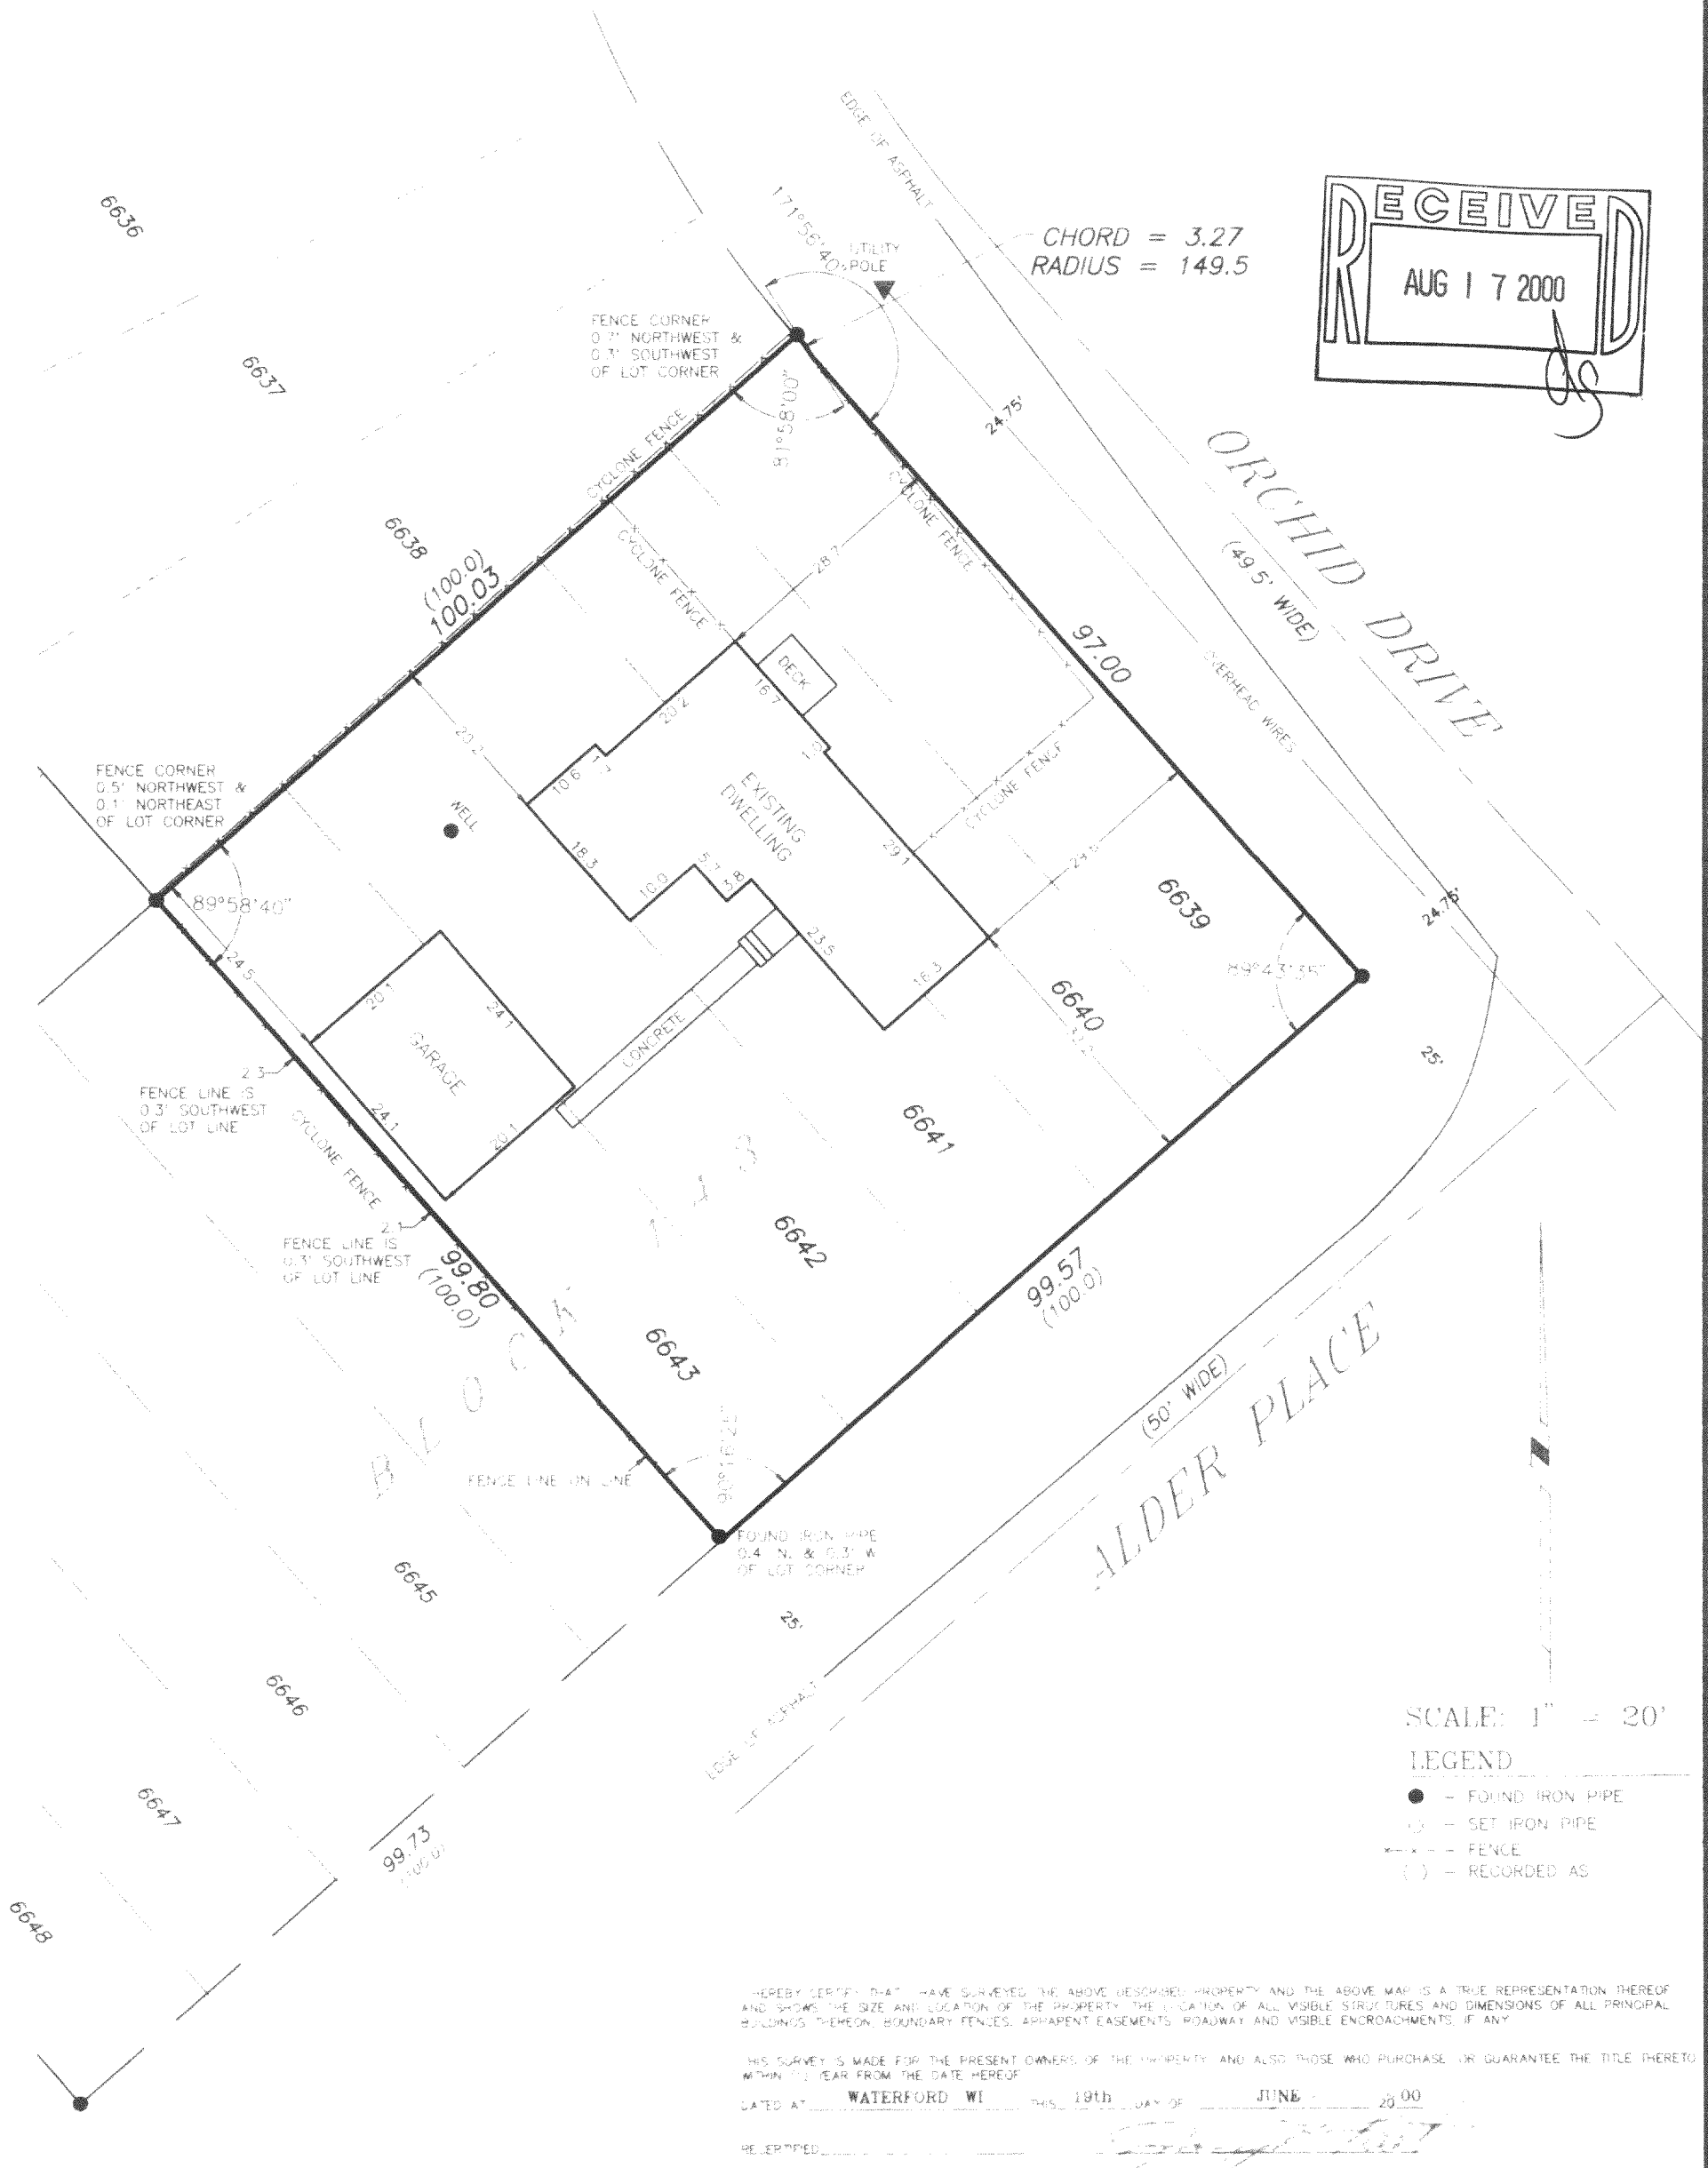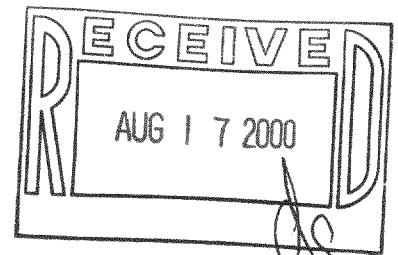

118-1950

MPL-1950
MPL-1450