

DEGEN, FOAT SURVEYING ASSOCIATES


100 SOUTH SECOND STREET
WATERFORD, WISCONSIN
(262)534-5404 (FAX)534-2022

004132
004132S1.DWG

PLAT OF SURVEY


LOT 13, BLOCK 1 OF ROSE NIPPERSINK GARDENS, BEING A SUBDIVISION LOCATED IN THE SOUTHEAST 1/4 AND THE SOUTHWEST 1/4 OF THE SOUTHEAST 1/4 OF SECTION 24, TOWNSHIP 1 NORTH, RANGE 18 EAST, OF THE FOURTH PRINCIPAL MERIDIAN, TOWNSHIP OF BLOOMFIELD, COUNTY OF WALWORTH, STATE OF WISCONSIN.

SURVEY ORDERED BY: MONA PRILL
COLDWELL BANKER LAKE & COUNTRY
P.O. BOX 727, 336 E. MAIN ST.
TWIN LAKES, WI 53181

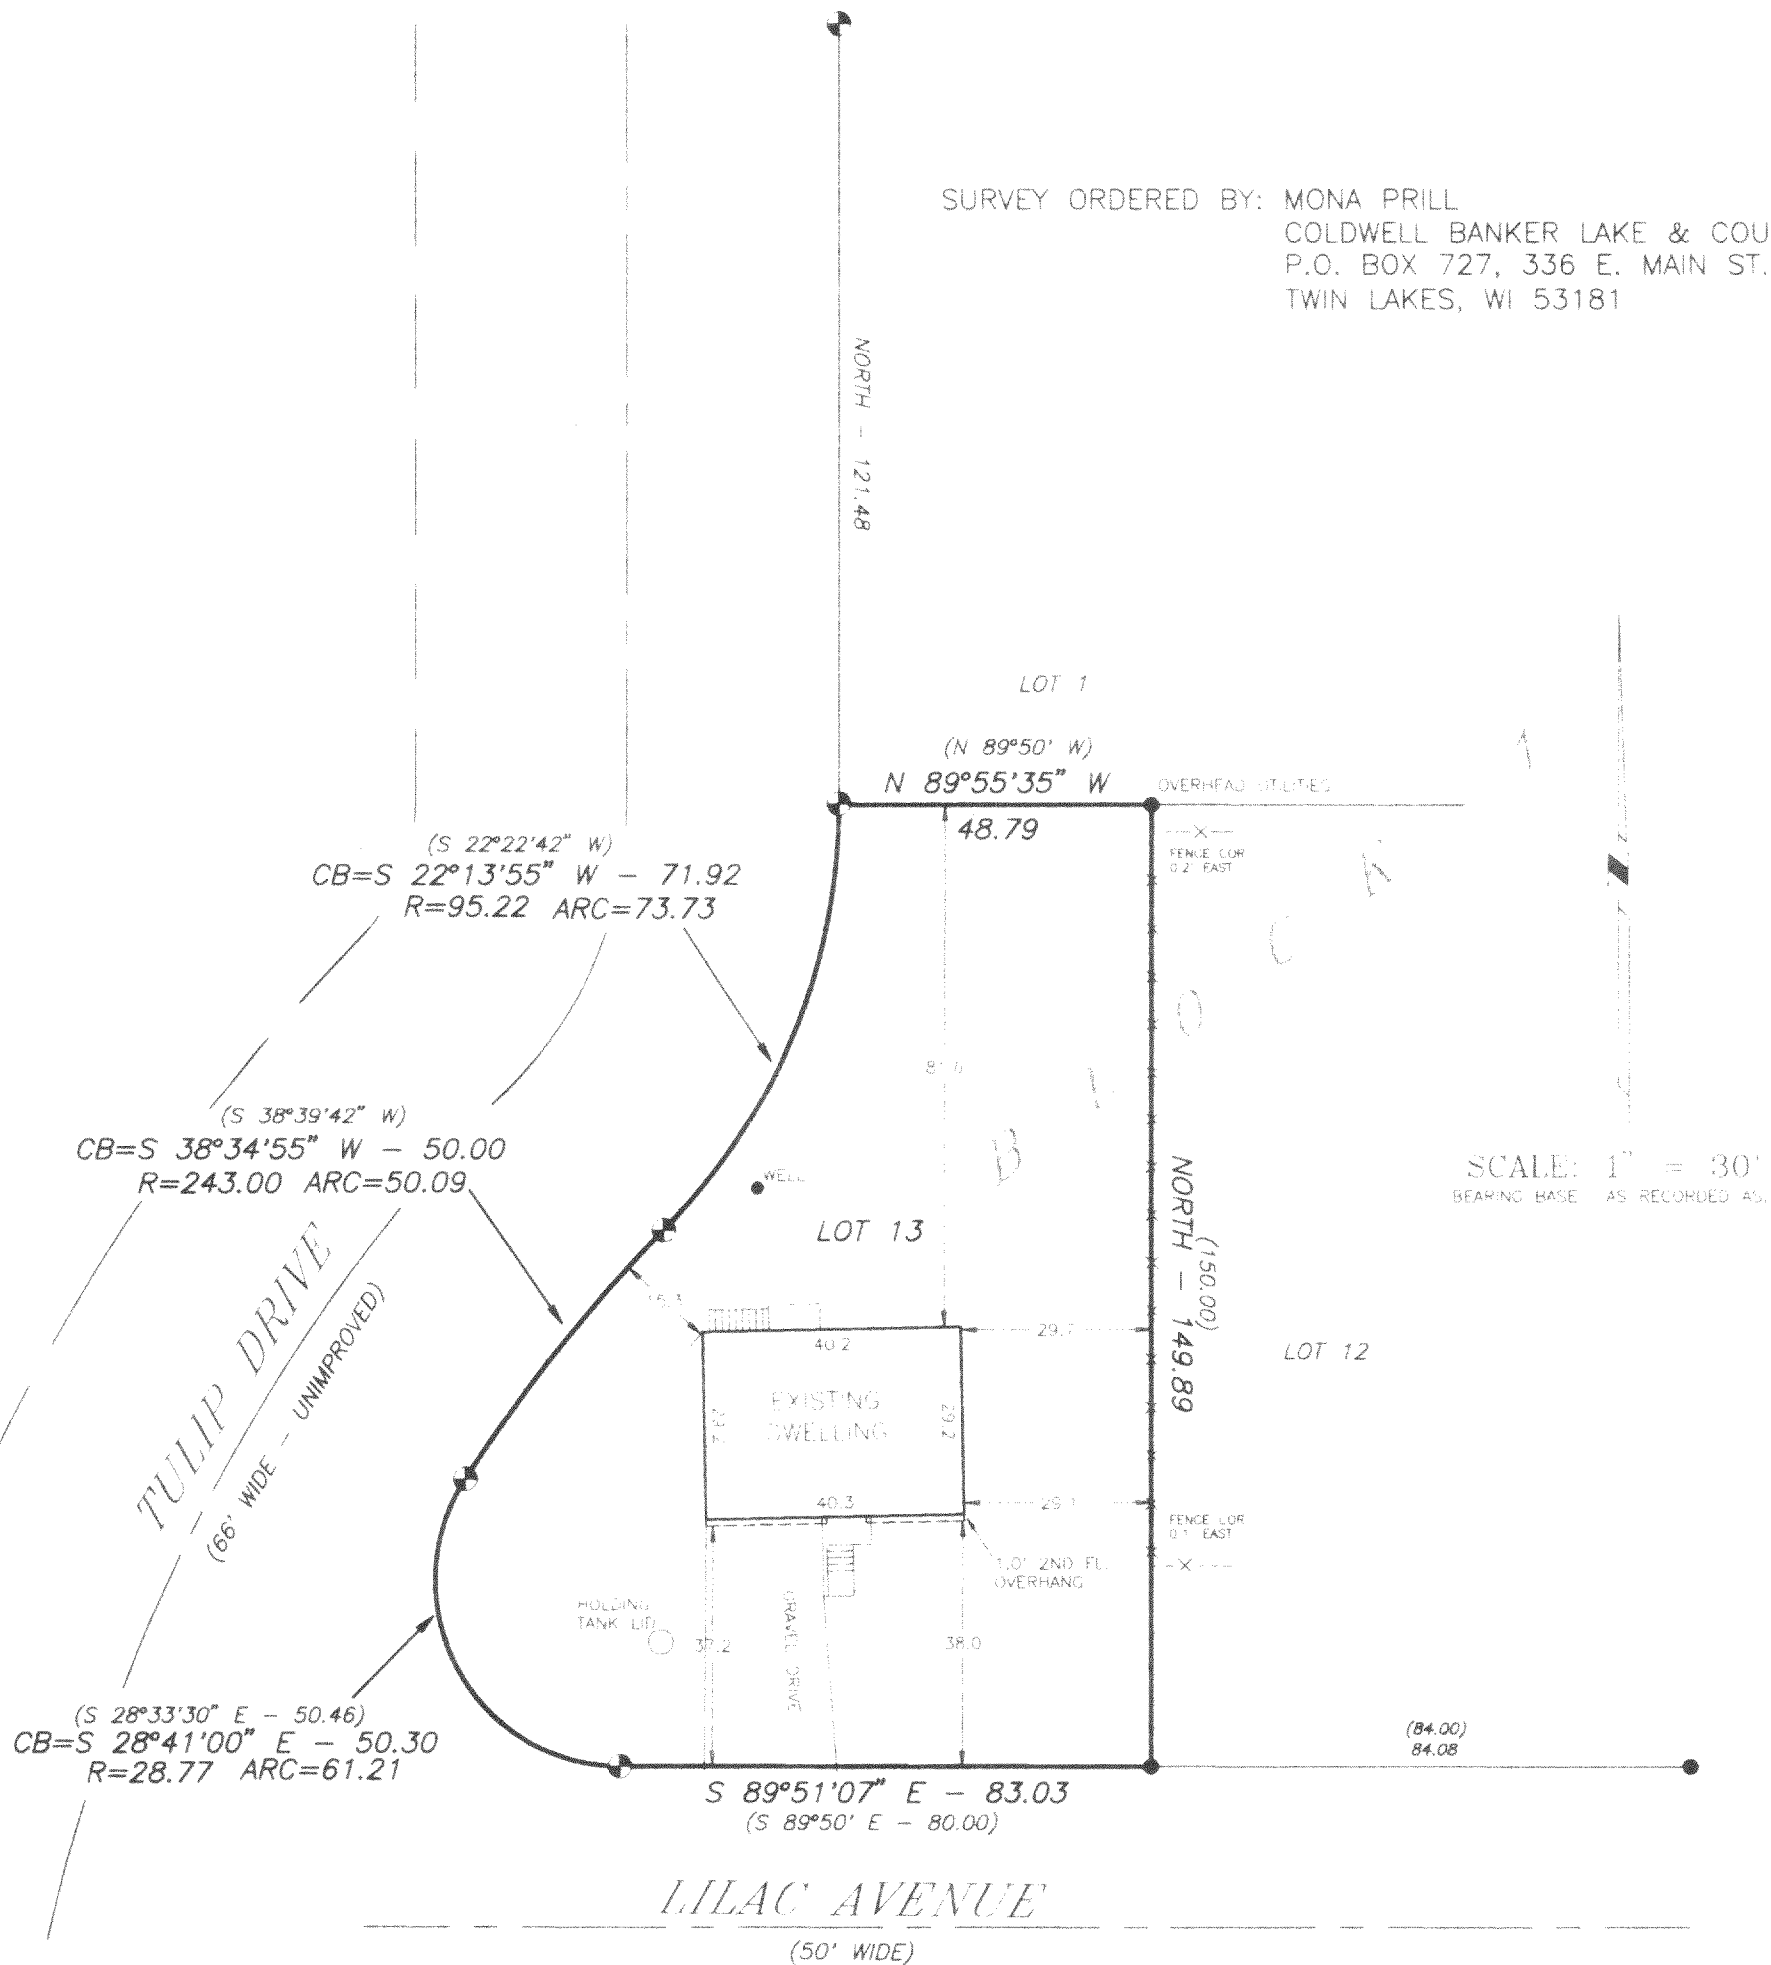

LEGEND

- - FOUND IRON PIPE
- - SET IRON PIPE
- X--- - STOCKADE FENCE
- () - RECORDED AS
- ⊕ - FOUND CONCRETE MONUMENT

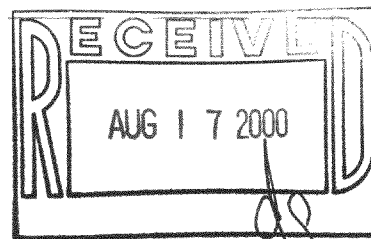

I HEREBY CERTIFY THAT I HAVE SURVEYED THE ABOVE DESCRIBED PROPERTY AND THE ABOVE MAP IS A TRUE REPRESENTATION THEREOF AND SHOWS THE SIZE AND LOCATION OF THE PROPERTY, THE LOCATION OF ALL VISIBLE STRUCTURES AND DIMENSIONS OF ALL PRINCIPAL BUILDINGS THEREON, BOUNDARY FENCES, APPARENT EASEMENTS, ROADWAY AND VISIBLE ENCROACHMENTS, IF ANY.

THIS SURVEY IS MADE FOR THE PRESENT OWNERS OF THE PROPERTY, AND ALSO THOSE WHO PURCHASE, OR GUARANTEE THE TITLE THERETO WITHIN (1) YEAR FROM THE DATE HEREOF.

DATED AT WATERFORD, WI this 2nd DAY OF MAY 2000

RECERTIFIED

Greg B. Fout

118-1955

MRNG-9A