


PLAT OF SURVEY

ORDERED BY:
HOMESTEAD LAKES REALTY
520 BROAD ST.
LAKE GENEVA, WI
53147

DATE: 10 / 15 / 2000

DESCRIPTION

LOTS 1409 THRU 1418 ALL INCLUSIVE BLOCK 23 OF PELL LAKE ADDITION
A SUBDIVISION LOCATED IN T.1.N. , R.18.E. , WALWORTH COUNTY, WISCONSIN.

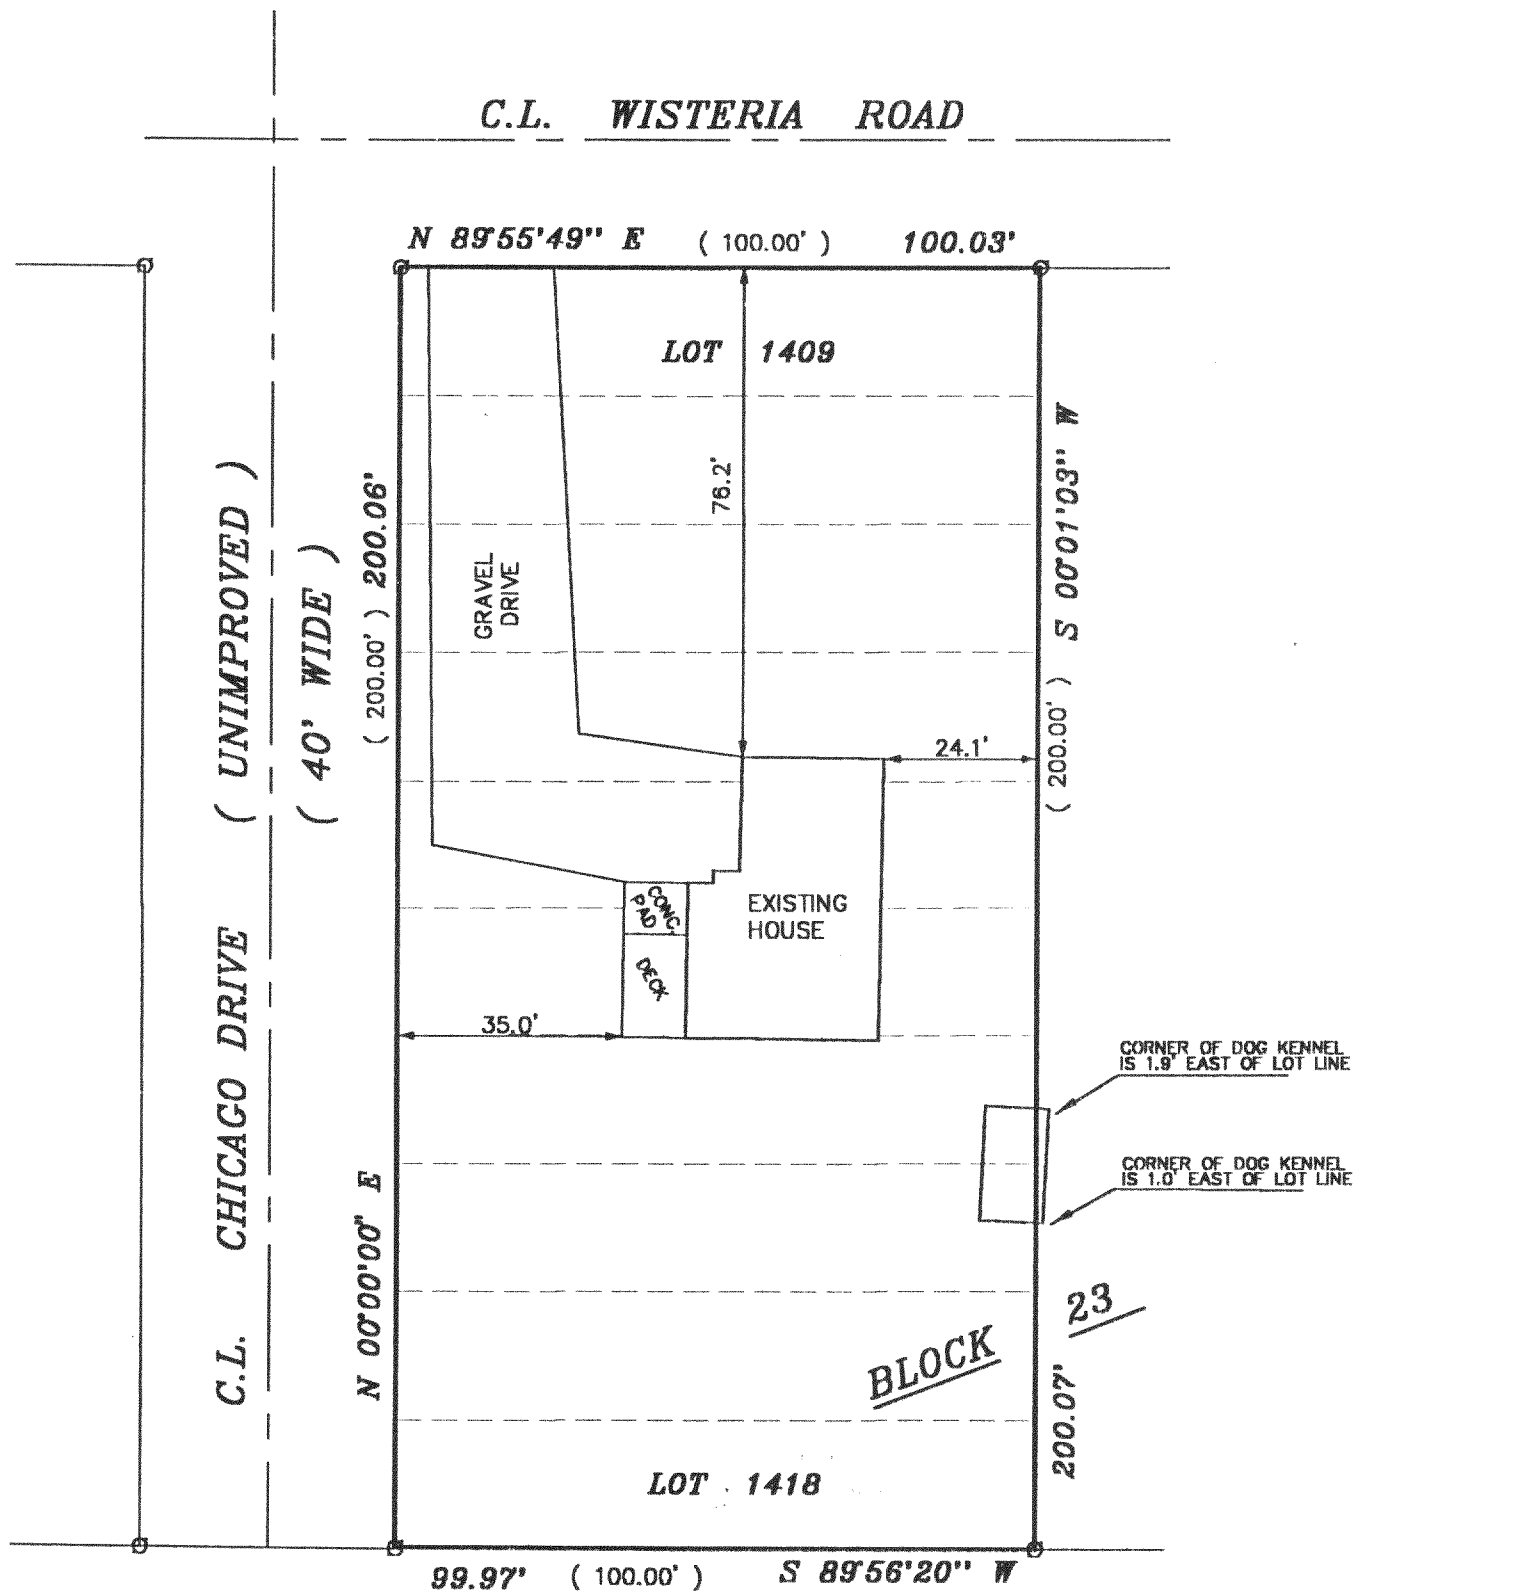

THE ABOVE MAP IS A TRUE REPRESENTATION THEREOF AND SHOWS THE SIZE AND LOCATION OF ALL THE PROPERTY, EXTERIOR BOUNDARIES, THE LOCATION OF ALL VISIBLE BOUNDARY FENCES, APPARENT EASEMENTS, ROADWAYS AND VISIBLE ENCROACHMENTS, IF ANY.

THIS SURVEY IS MADE FOR THE USE OF THE PRESENT OWNERS OF THE PROPERTY, AND ALSO THOSE WHO PURCHASE, MORTGAGE OR GUARANTEE TITLE THERETO WITHIN ONE (1) YEAR FROM DATE HERETO.

John P. Krott
JOHN P. KROTT, R.L.S. 2258

NOTE: THIS IS NOT A CERTIFIED COPY
UNLESS SEAL IS IN RED.

JOB NUMBER: 00530-1-18-MPLA-00293

MPLA-293