

DEGEN, FOAT SURVEYING ASSOCIATES



100 SOUTH SECOND STREET
WATERFORD, WISCONSIN
(262)534-5404 (FAX)534-2022

004358
004358S1.DWG

PLAT OF SURVEY

LOTS 6734 THRU 6739, BLOCK 147, SECTION 4 OF PELL LAKE SUBDIVISION, LOCATED IN THE NORTH 1/2 OF SECTION 15, TOWN 1 NORTH, RANGE 18 EAST, TOWN OF BLOOMFIELD, WALWORTH COUNTY, WISCONSIN.

SURVEY PREPARED FOR: JOHN LYDON
P.O. BOX 646
PELL LAKE, WI 53157

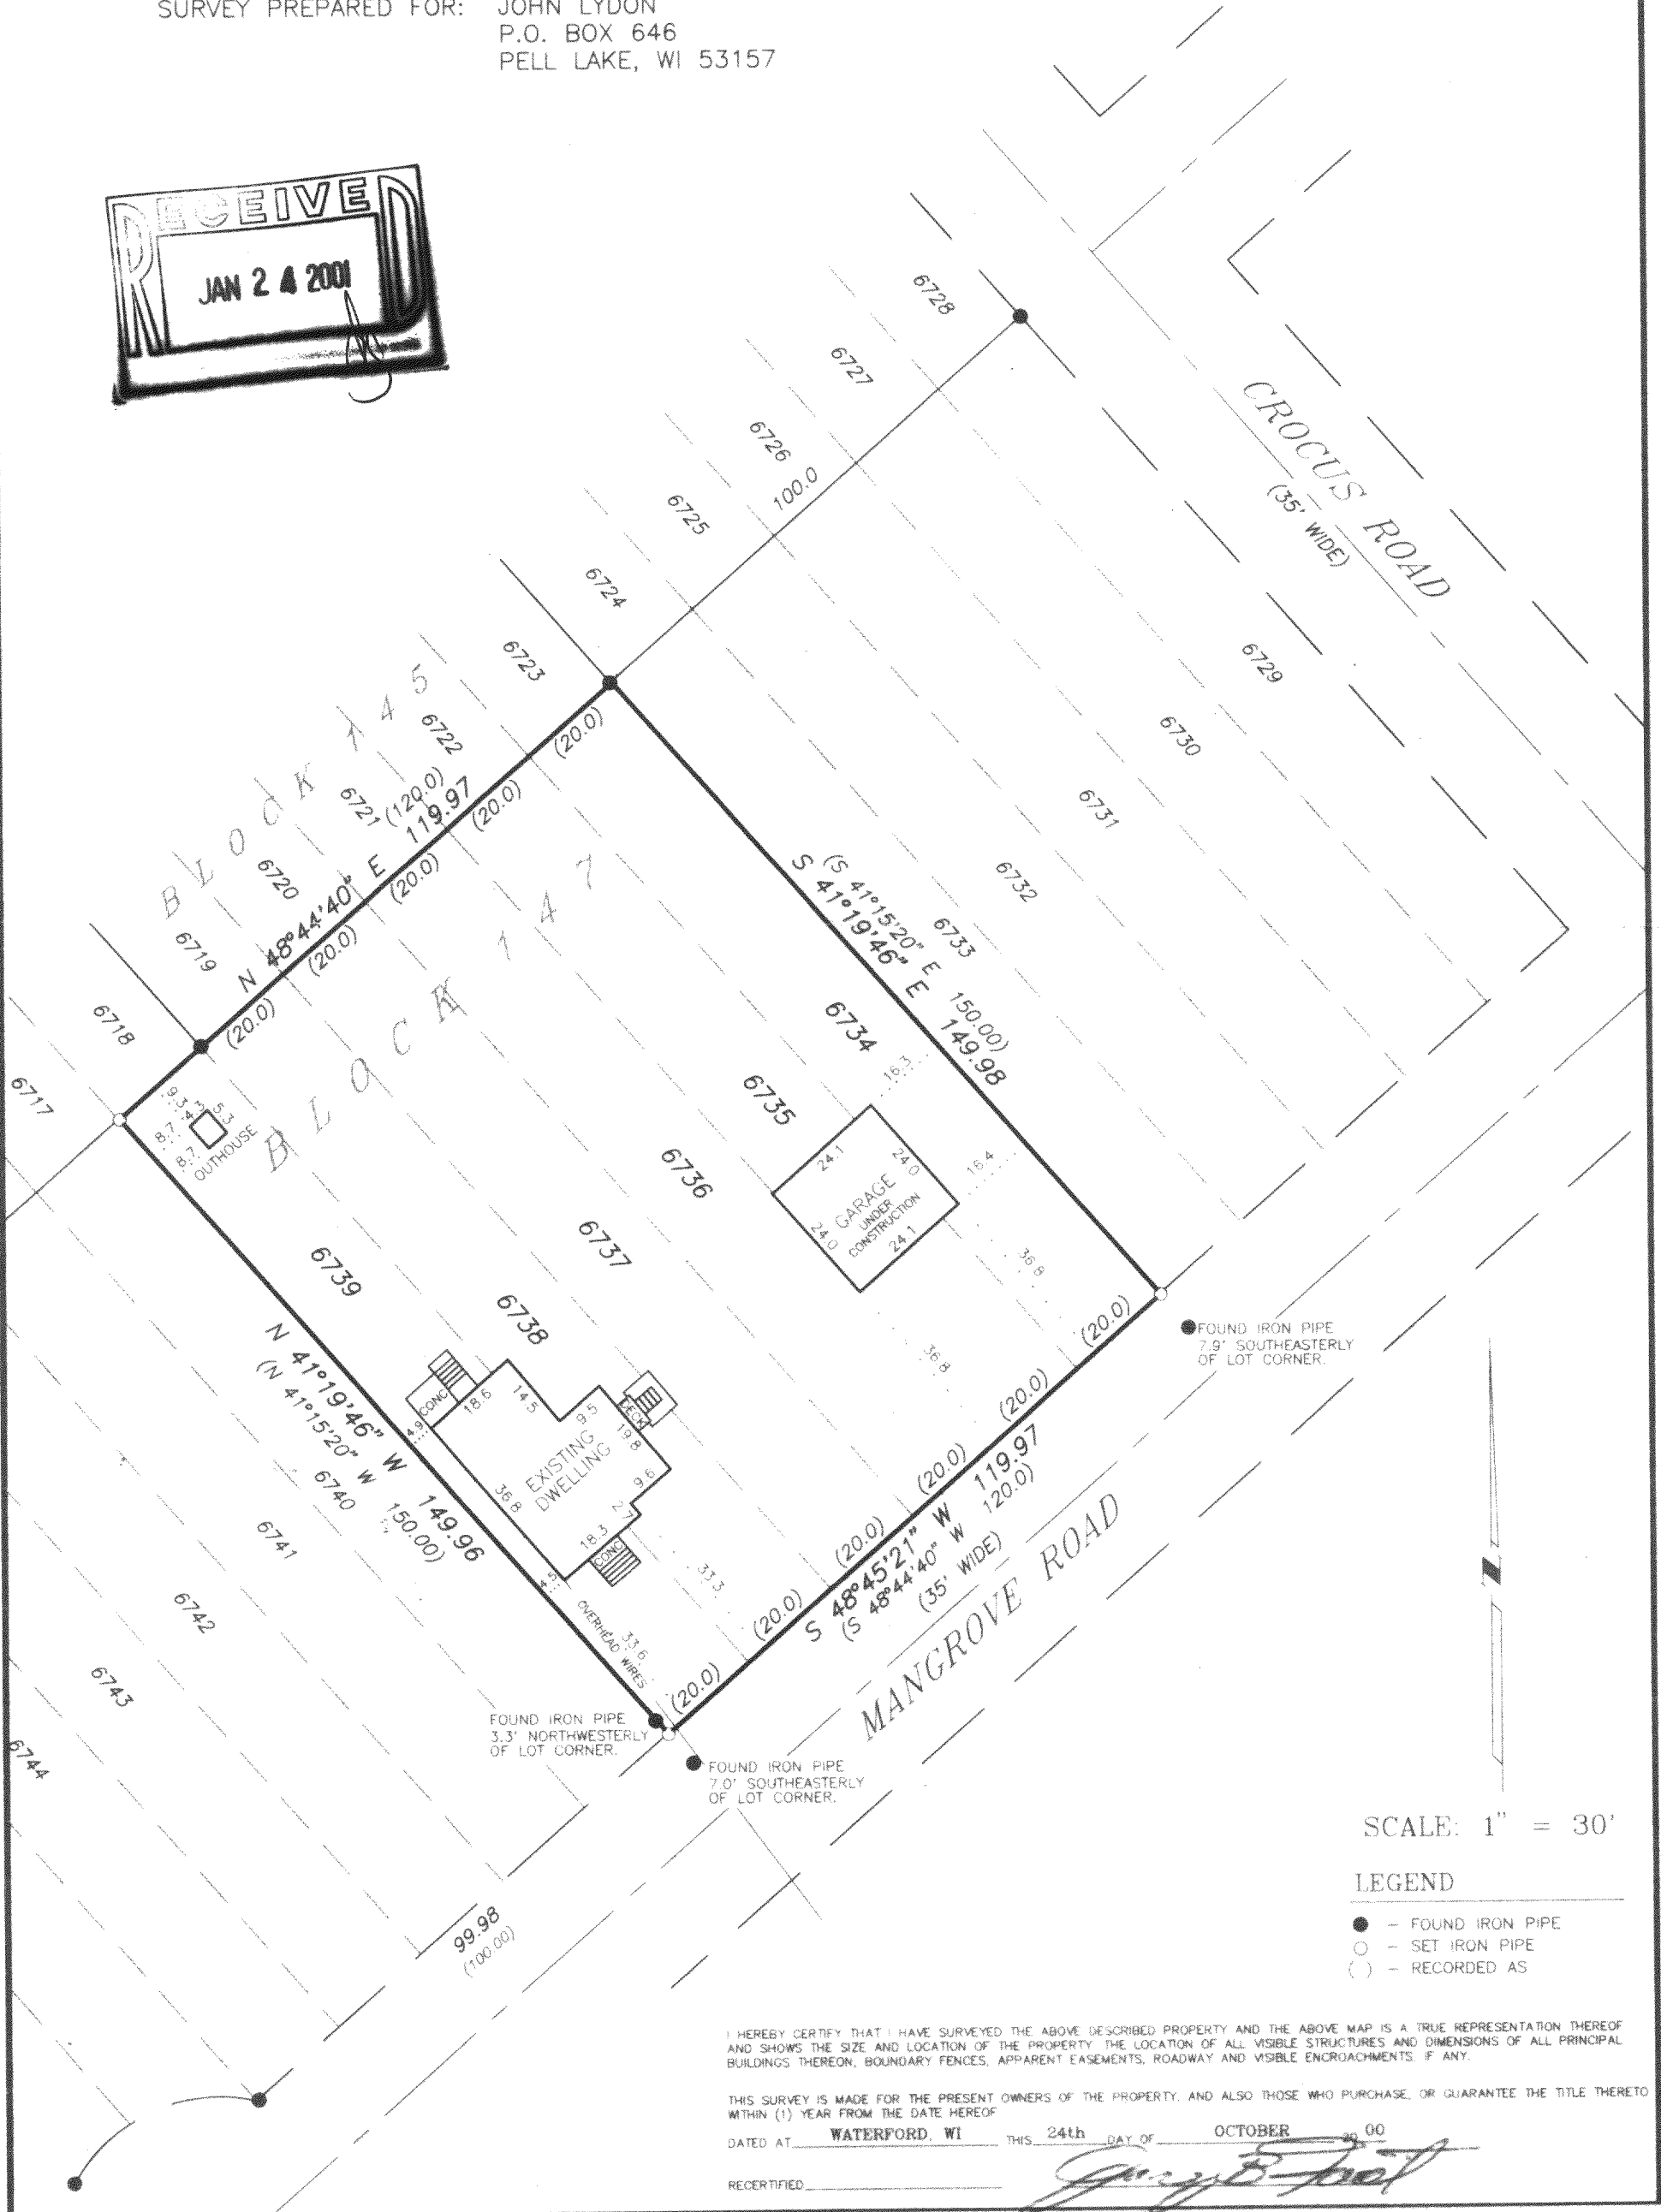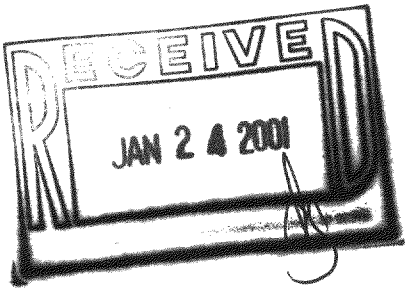

118-2002

MPL-MPL-1469