

004285
004285S1.DWG


PLAT OF SURVEY

SURVEY PREPARED FOR: JERRY SIPARI
P.O. BOX 99
PELL LAKE, WI 53157

(40' WIDE)

- EDGE OF PAVEMENT

(120.0)
119.88

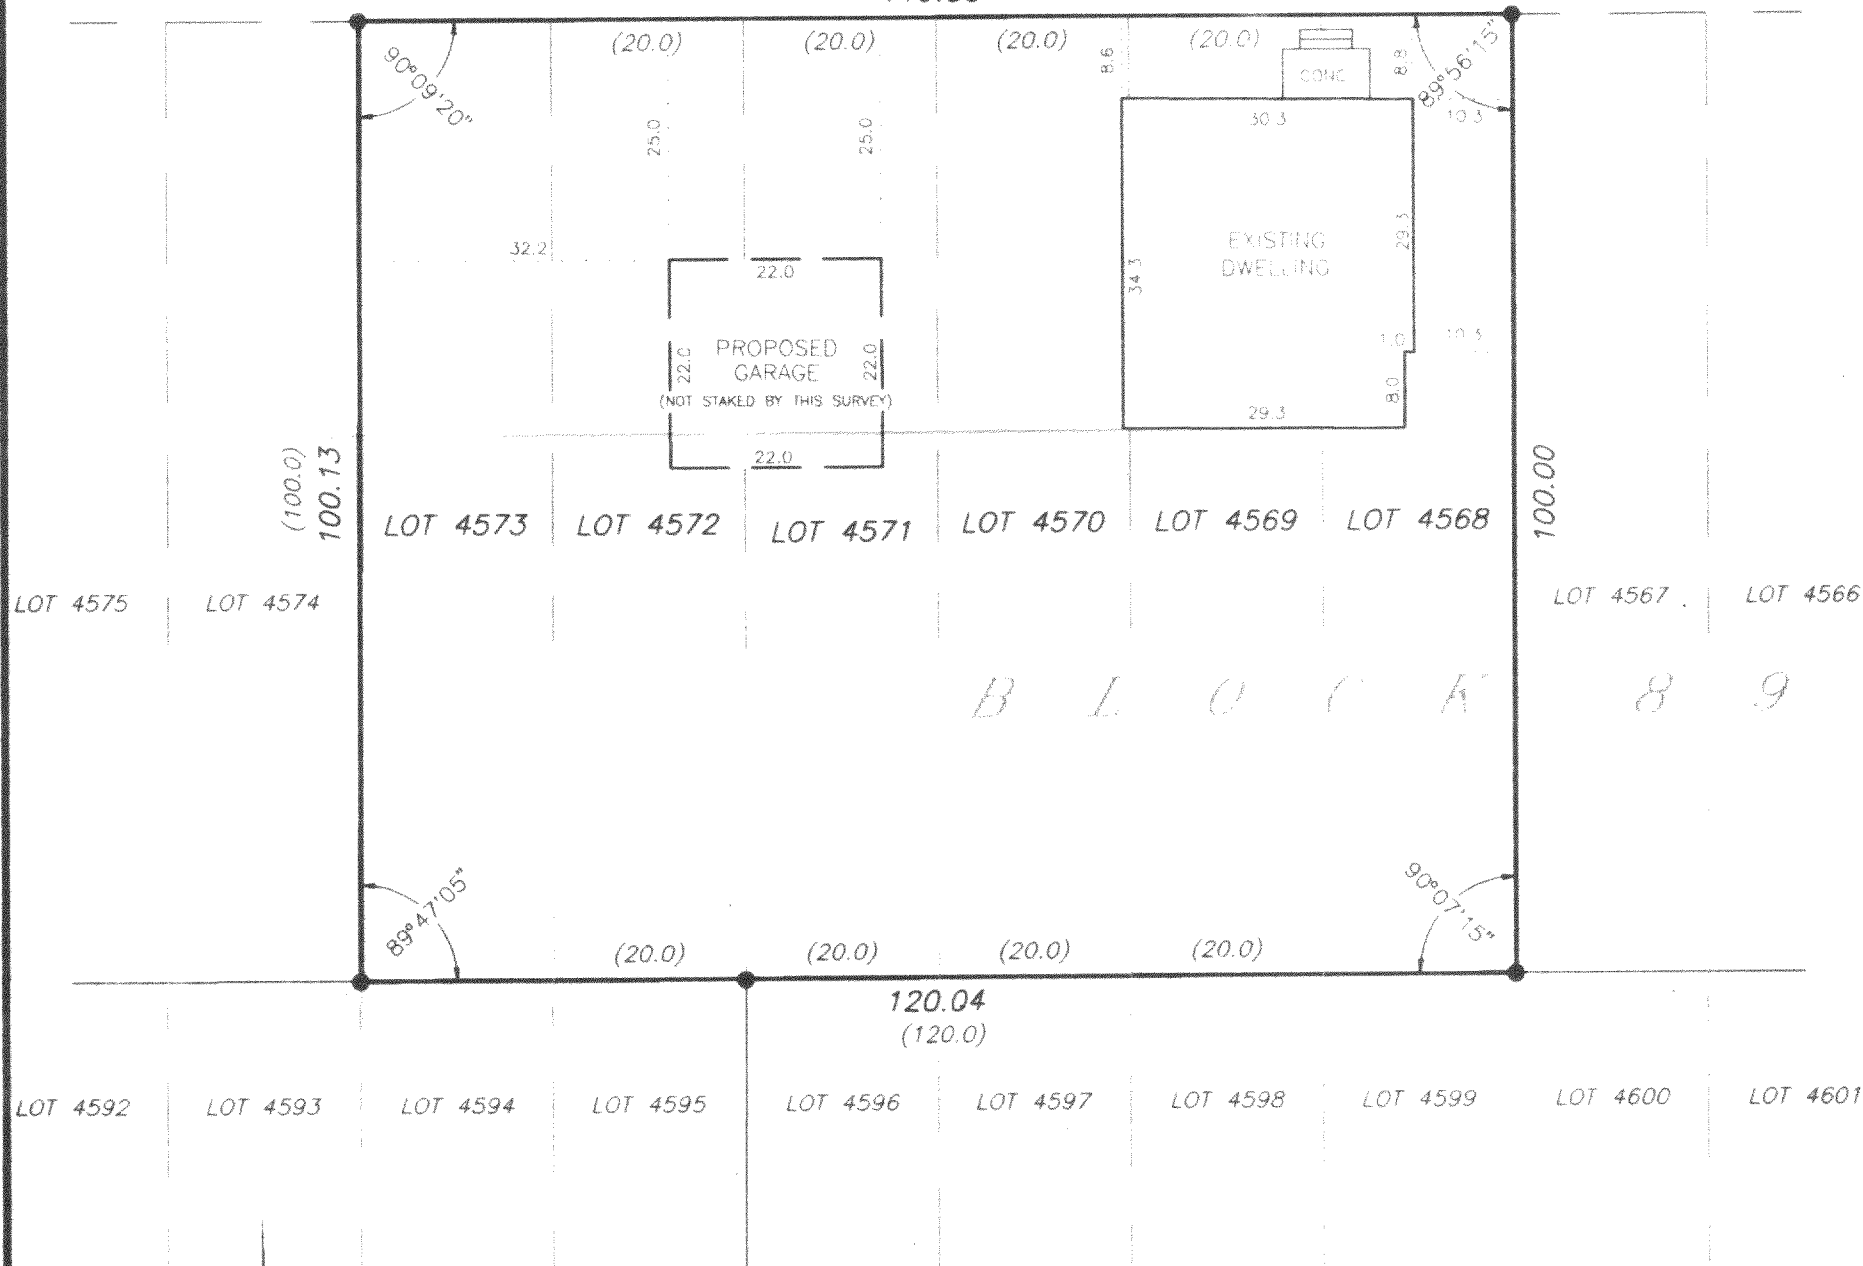

SCALE: 1" = 20'

LEGEND

- -- FOUND IRON PIPE
() -- RECORDED AS

I HEREBY CERTIFY THAT I HAVE SURVEYED THE ABOVE DESCRIBED PROPERTY AND THE ABOVE MAP IS A TRUE REPRESENTATION THEREOF AND SHOWS THE SIZE AND LOCATION OF THE PROPERTY, THE LOCATION OF ALL VISIBLE STRUCTURES AND DIMENSIONS OF ALL PRINCIPAL BUILDINGS THEREON, BOUNDARY FENCES, APPARENT EASEMENTS, ROADWAY AND VISIBLE ENCROACHMENTS, IF ANY.

THIS SURVEY IS MADE FOR THE PRESENT OWNERS OF THE PROPERTY, AND ALSO THOSE WHO PURCHASE, OR GUARANTEE THE TITLE THERE TO WITHIN (1) YEAR FROM THE DATE HEREOF

DATED AT WATERFORD, WI THIS 15th DAY OF SEPTEMBER, 2000

RE CERTIFIED.

MPL-974

118-2003