

C. GEORGES

MZ 00006




DEGEN, FOAT SURVEYING ASSOCIATES

100 SOUTH SECOND STREET
WATERFORD, WISCONSIN
(262)534-5404 (FAX)534-2022

PLAT OF SURVEY

LOT 5, ZUHDE SUBDIVISION, LOCATED IN THE EAST HALF OF SECTION 13, TOWN 1 NORTH, RANGE 18
EAST OF THE FOURTH PRINCIPAL MERIDIAN, TOWNSHIP OF BLOOMFIELD, COUNTY OF WALWORTH, STATE
OF WISCONSIN.

SURVEY PREPARED FOR: RE/MAX - SOUTHERN LAKES
112 ELIZABETH LANE
GENOA CITY, WI 53128

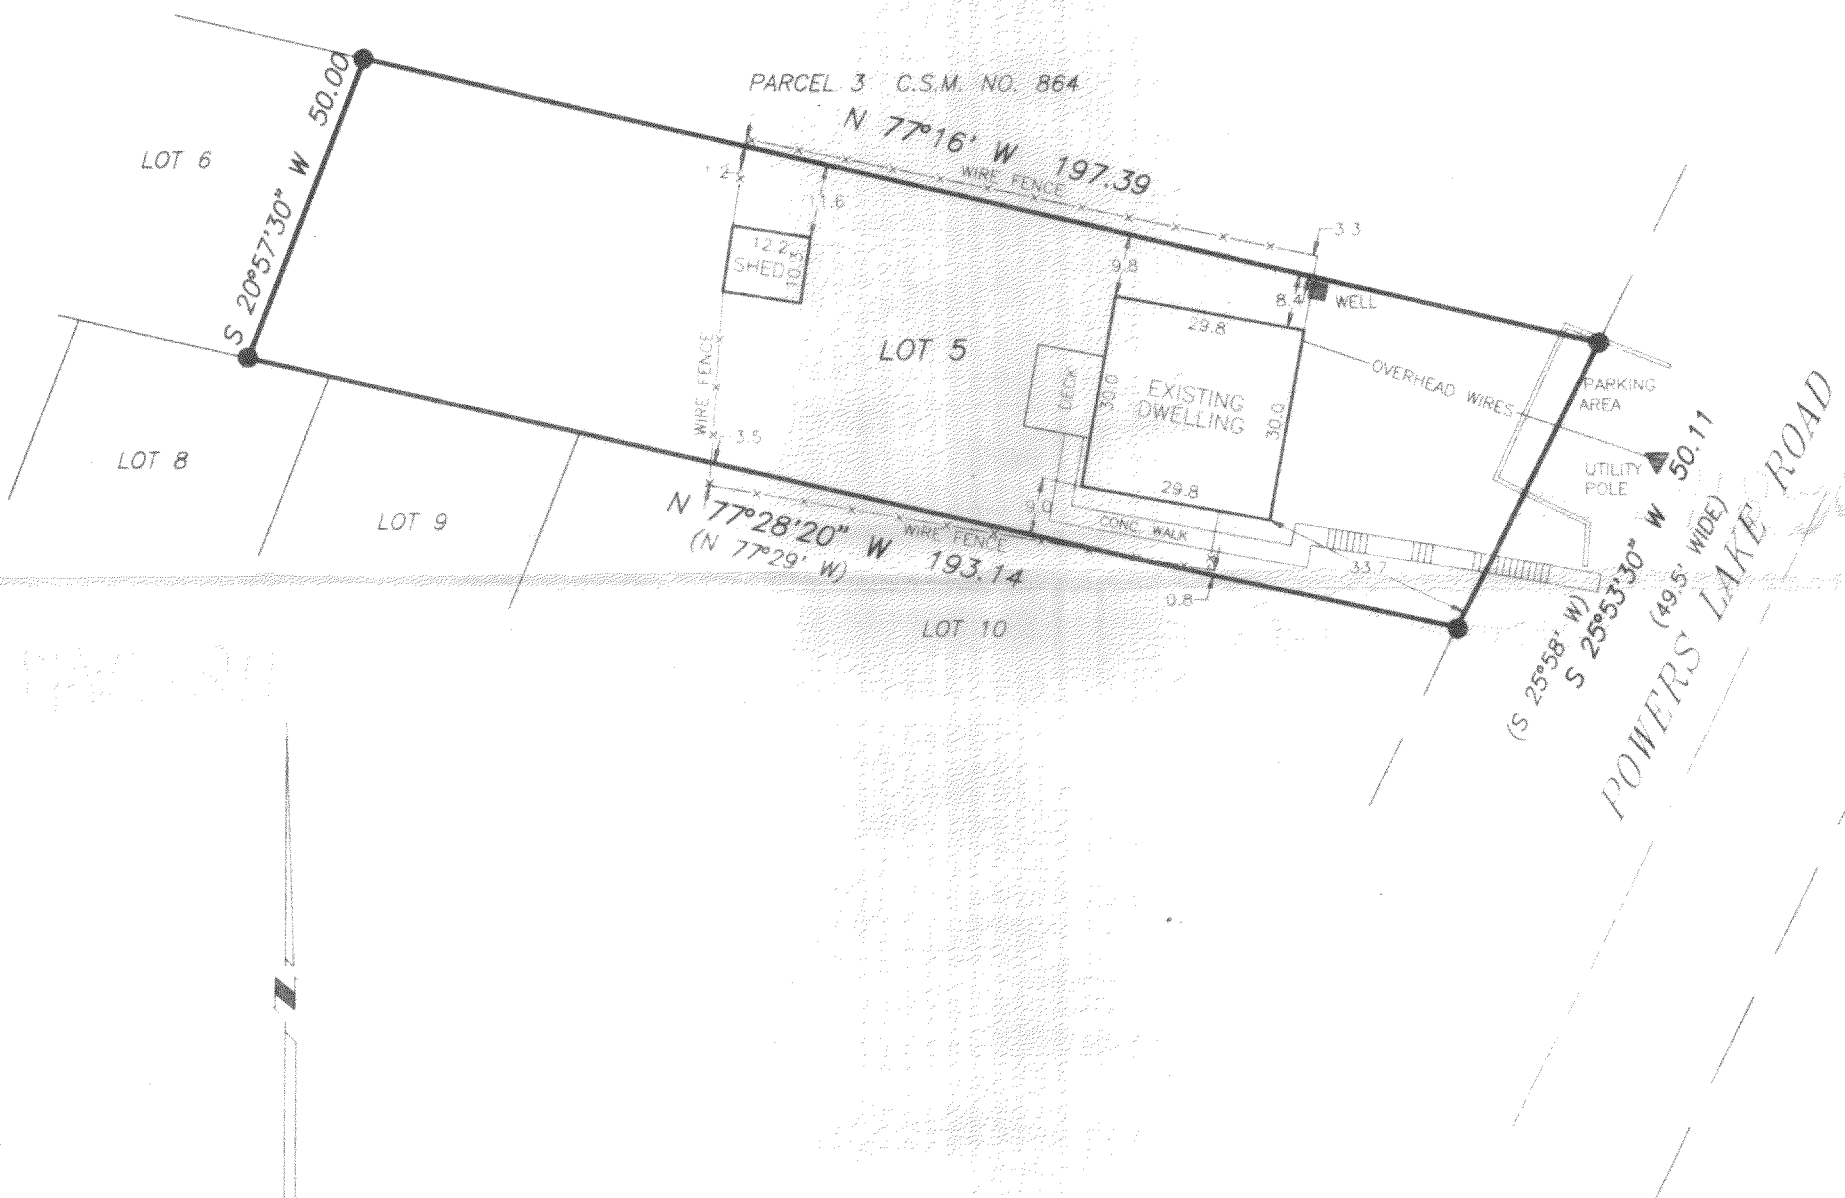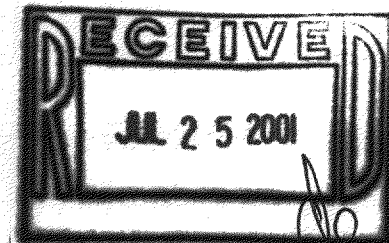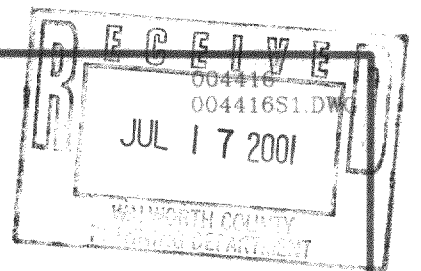

SCALE: 1" = 30'

BEARINGS RELATE TO THE NORTH LINE
OF LOT 5 WHICH WAS USED AS PLATTED
AS N 77°16' W.

LEGEND

- - FOUND IRON PIPE
- FENCE
- () - RECORDED AS
- ⊙ - FOUND CONCRETE MONUMENT

I HEREBY CERTIFY THAT I HAVE SURVEYED THE ABOVE DESCRIBED PROPERTY AND THE ABOVE MAP IS A TRUE REPRESENTATION THEREOF
AND SHOWS THE SIZE AND LOCATION OF THE PROPERTY, THE LOCATION OF ALL VISIBLE STRUCTURES AND DIMENSIONS OF ALL PRINCIPAL
BUILDINGS THEREON, BOUNDARY FENCES, APPARENT EASEMENTS, ROADWAY AND VISIBLE ENCROACHMENTS, IF ANY.

THIS SURVEY IS MADE FOR THE PRESENT OWNERS OF THE PROPERTY, AND ALSO THOSE WHO PURCHASE, OR GUARANTEE THE TITLE THERETO
WITHIN (1) YEAR FROM THE DATE HEREOF.

DATED AT WATERFORD, WI THIS 20th DAY OF DECEMBER 2000

RECERTIFIED

Gary B. Fout

MZ-6

118-2049