

LOTS 1583, 1584, 1585, 1586, 1587, 1588 AND 1589 IN BLOCK 25 AS DESIGNATED AND DELINEATED ON THE MAP ENTITLED "PELL LAKE HIGHLANDS" IN WALWORTH COUNTY, WISCONSIN AND RECORDED IN THE OFFICE OF THE REGISTER OF DEED IN AND FOR THE COUNTY OF WALWORTH AND STATE OF WISCONSIN ON THE 12TH DAY OF JUNE 1925, IN VOLUME 8 OF PLATS ON PAGE 27.

"I hereby certify that I have surveyed the above described property and that the above map is a correct representation thereof and shows the size and location of the property, its exterior boundaries, the location of all visible structures and dimensions of all principal buildings thereon, boundary fences, apparent easements, roadways and encroachments, if any."


"This survey is made for the use of the present owners of the property, and those who purchase, mortgage, or guarantee the title thereto within one year from date hereof."

412 N. PINE STREET
BURLINGTON, WI 53105
(262)-767-0225

MP4-273
118-2052



○ FOUND IRON PIPE
● FOUND IRON ROD
Ø SET IRON PIPE

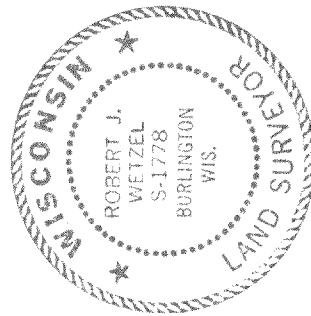

THIS IS NOT AN ORIGINAL PRINT
UNLESS THIS SEAL IS RED.

Robert J. Wetzel
ROBERT J. WETZEL 3-1778

JULY 19, 2001
DATE

5058
JOB NUMBER

RECEIVED
AUG 13 2001
ORIGINAL PRINT