


PREPARED FOR:
HALLMARK REALTY
P.O. BOX 1005
PELL LAKE WI 53157

PLAT OF SURVEY
- OF -

J.K. SURVEYING INC.
N3705 WILLOWBEND LANE
LAKE GENEVA, WI, 53147
262-248-3697

THE EAST 60 FEET OF LOTS 74 THRU 78 BLK 2 PELL LAKE HIGHLANDS SUBDIVISION
AND LOTS 9484 THRU 9488 PELL LAKE SUBDIVISION ALL LOCATED IN T.1.N. R.18.E,
WALWORTH COUNTY , WISCOSIN.

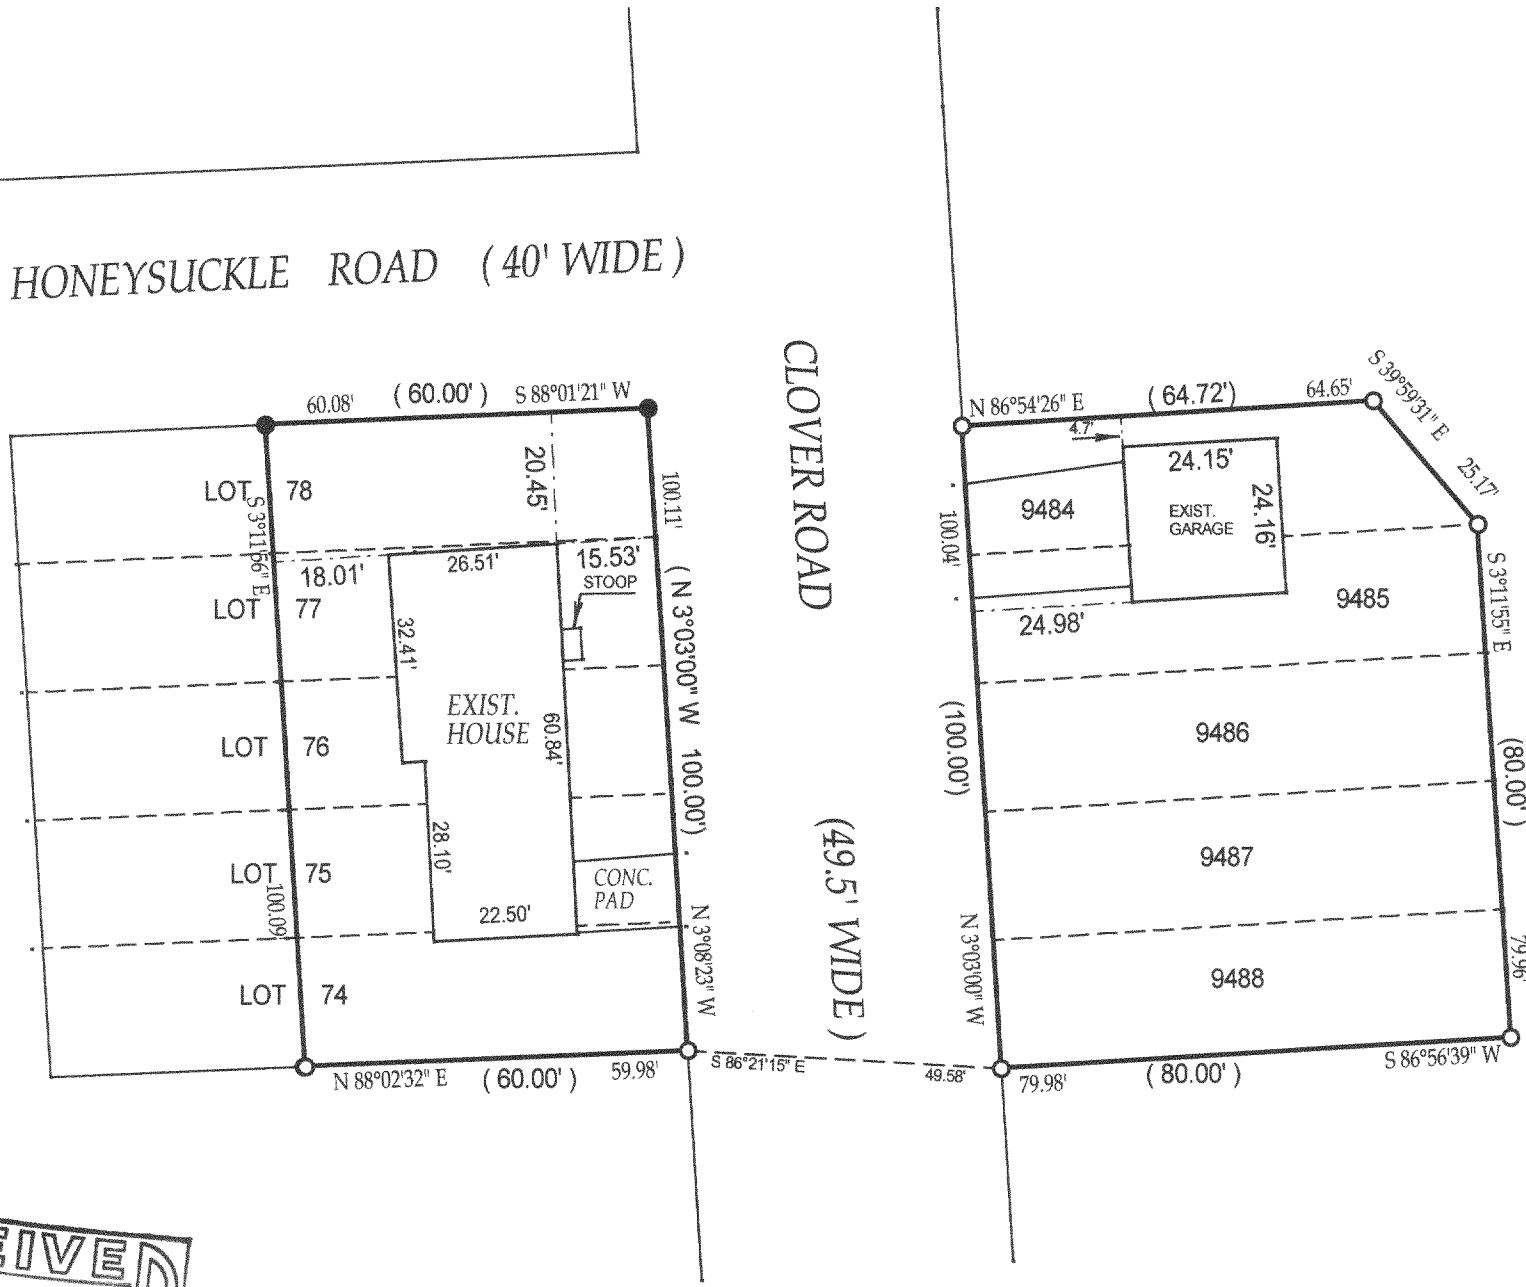

- () = recorded as
- = found iron bar
- = found iron pipe
- = set iron pipe
- = set iron bar

SCALE 1" = 30'

JOB # 01-459

TAX ID # MPL-1923 & MPLH-17



COMPARE LEGAL DESCRIPTION ABOVE AND DRAWING WITH DEED. FOR BUILDING RESTRICTIONS AND EASEMENTS NOT SHOWN, REFER TO DEED, ABSTRACT SOURCES AND LOCAL MUNICIPAL CODES. NOTIFY THE SURVEYOR IMMEDIATELY OF ANY DISCREPANCY.

"I hereby certify that I have surveyed the above described property and that the above map is a true representation thereof and shows the size and location of all visible structures, apparent easements and encroachments if any."

This survey is made for the present owners of the property, and those who purchase, mortgage, or guarantee the title thereto, within one year from the date hereof. DATED THIS 12 TH, DAY OF OCTOBER 20 01 .



John P. Krott
JOHN KROTT S - 2258
Wisconsin Registered Land Surveyor
(original if signed in red)

MPL-1923

MPLH-17

118-2870